
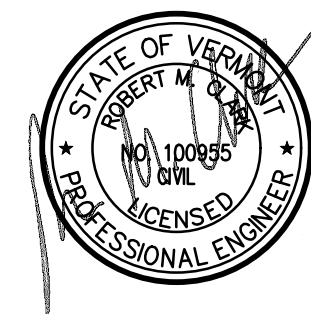


TOWN OF BERLIN

PAINE TURNPIKE NORTH WASTEWATER IMPROVEMENTS

BERLIN, VERMONT

SPRING 2020

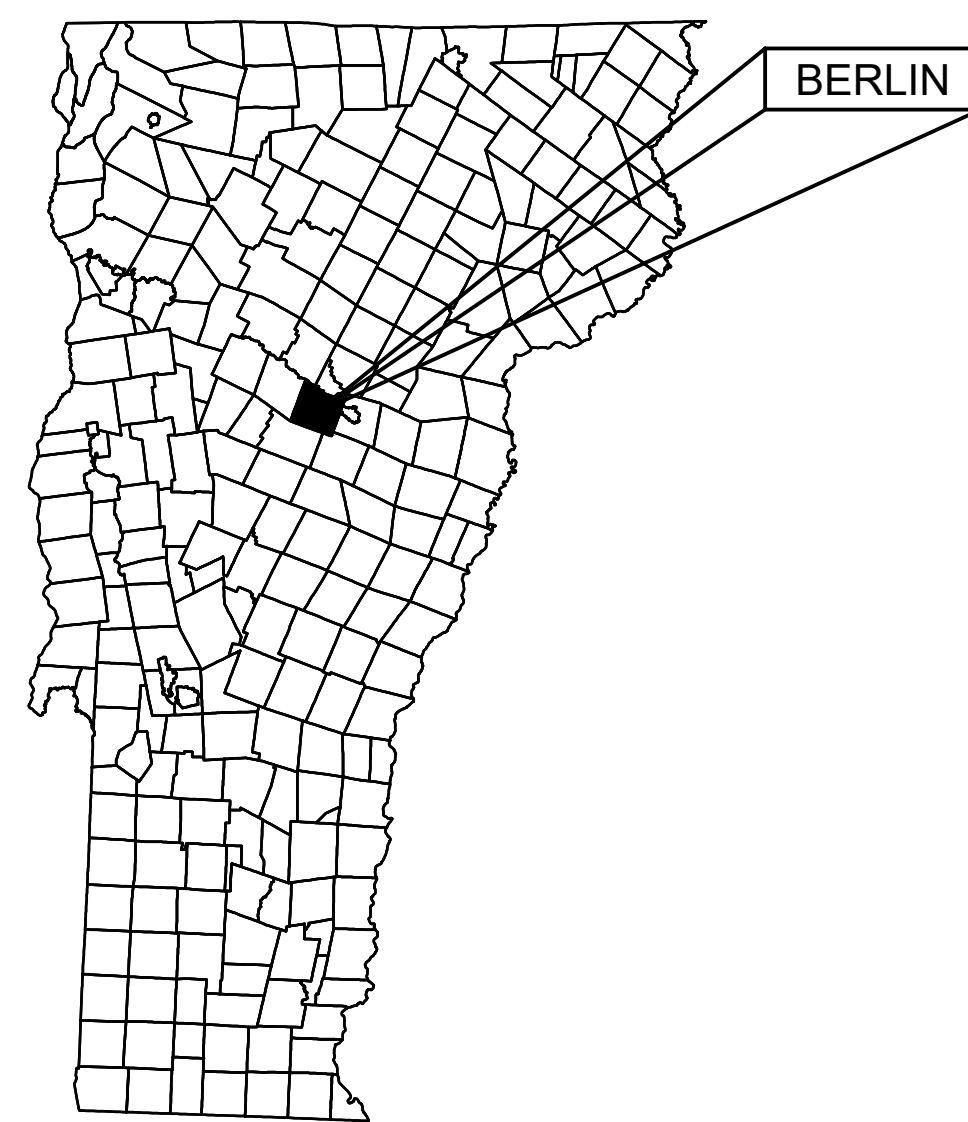

RECORD SET

RECORD DRAWING

Record drawings have been prepared on the basis of information furnished by others. The engineer is not responsible for errors or omissions which have been incorporated into this document as a result. The location of items shown without labeled dimensions shall be considered as approximate. Profiles show general layout. Due to changes during construction, alignment, station and elevation information may not be correct. The site was not re-surveyed after construction, so "as-built" locations, elevations and finish grades are approximate and shall be considered "schematic". Details and cross sections may not reflect "as built" conditions.
Prepared by : Otter Creek Engineering, Inc., East Middlebury, Vermont.




**OTTERCREEK
ENGINEERING**

404 East Main Street
P.O. Box 712
East Middlebury, VT 05740
Telephone: 802 382-8522
Fax: 802 382-8640

110 Merchants Row
4th Floor, Suite 15
Rutland, VT 05701
Telephone: 802 747-3080
Fax: 802 747-4820

E-mail: info@ottercrk.com

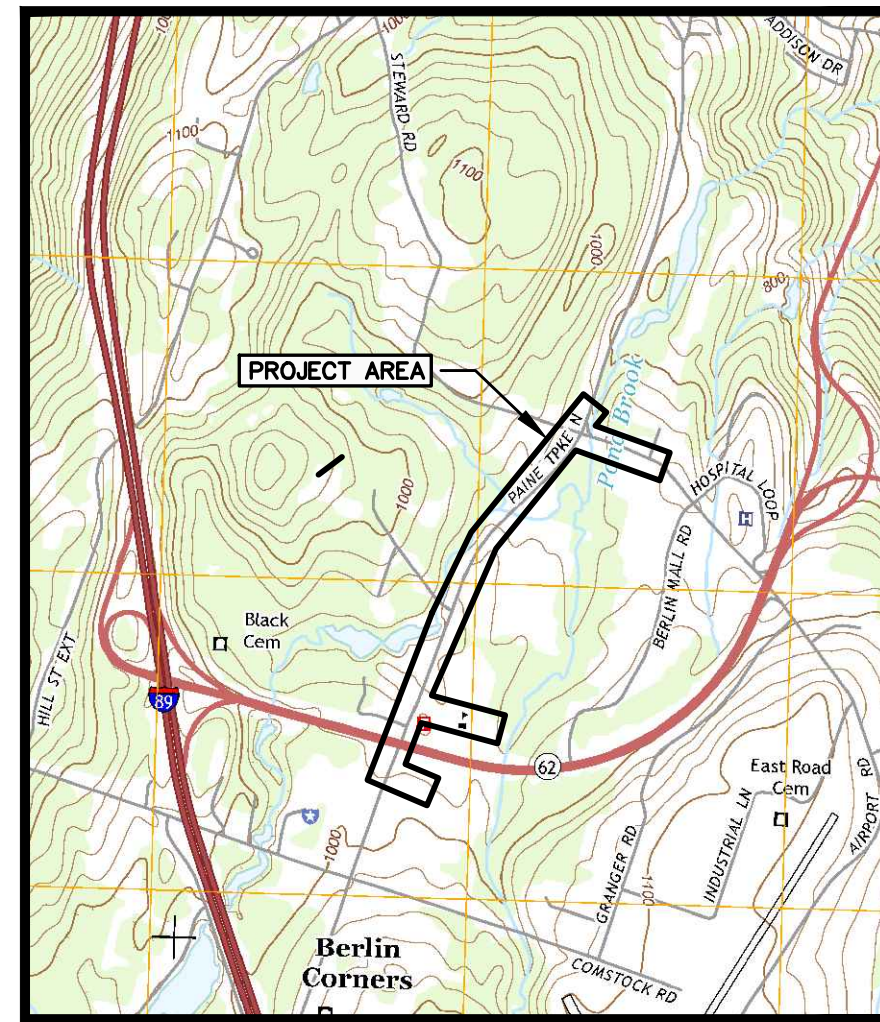

PROJECT LOCATION MAP

LEGEND

	boundary line/r.o.w.
	easement
	road/parking (paved/gravel)
	drive (paved/gravel)
	tree line/hedge row
	2 foot contour
	10 foot contour
	area of depression
	stone wall
	fence
	underground electric
	overhead utility
	underground telephone
	fiber optic
	ditch line/drainage
	storm drain
	water main
	sanitary sewer
	force main
	guardrail
	retaining wall
	culvert (size noted)
	railroad tracks
	sign
	light pole
	utility pole
	utility pole with light
	guy
	cleanout
	gate valve
	curb stop
	hydrant
	iron pipe found
	property monument
	flag pole
	boring designation
	wetland marker
	drilled well
	monitoring well
	post
	mailbox
	boulder
	catch basin
	sewer manhole
	telephone manhole
	deciduous tree
	coniferous tree
	bush/bushes
	stump
	hedges/treeline
	traverse station
	temporary bench mark
	tracer wire box
	FINISH GRADE
	SANITARY SEWER
	SEWER FORCE MAIN
	SEWER MANHOLE
	WATER MAIN
	GATE VALVE
	REDUCER

NOTE: FOR CLARITY, TEXT DENOTING EXISTING ITEMS IS SHOWN IN LOWER CASE, AND TEXT DENOTING PROPOSED ITEMS IS UPPERCASE AND BOLD.

ABBREVIATIONS

AC	ASBESTOS CEMENT	MH	MANHOLE
CI	CAST IRON	NC	NORMALLY CLOSED
CB	CATCH BASIN	NFL	NOT FIELD LOCATED
CL	CLASS	NLTD	NO LEDGE TO DEPTH
CMP	CORRUGATED METAL PIPE	NO	NORMALLY OPEN
CS	CURB STOP	NTS	NOT TO SCALE
DI	DUCTILE IRON	RCP	REINFORCED CONCRETE PIPE
FM	FORCE MAIN	ROW	RIGHT OF WAY
GPM	GALLON PER MINUTE	S	SANITARY SEWER
GV	GATE VALVE	SD	STORM DRAIN
GND	GROUND	SMH	SEWER MANHOLE
HYD	HYDRANT	TBM	TEMPORARY BENCH MARK
HDPE	HIGH DENSITY POLYETHYLENE	TBA	TO BE ABANDONED
INV	INVERT	TBR	TO BE REMOVED
IP	IRON PIPE/PIN	TMH	TELEPHONE MANHOLE
IPF	IRON PIPE/PIN FOUND	WMH	WATER MANHOLE
I.P.S.	IRON PIPE SIZE	U.N.O.	UNLESS NOTED OTHERWISE
		VC	VITRIFIED CLAY

GENERAL NOTES


1. THESE PLANS ARE BASED ON PLANIMETRIC MAPPING PREPARED BY MINUTEMAN MAPPING PHOTOGRAMMETRIC SERVICES, BEDFORD, NH, FROM PHOTOGRAPHY DATED 11/11/10, MAP COMPILED 11/24/12.
2. IN THE PREPARATION OF THESE PLANS, DATA FROM THE FOLLOWING SOURCES WAS INCORPORATED:
 - A. PLAN TITLED "TOWN OF BERLIN, BERLIN CORNERS MUNICIPAL WATER SYSTEM, BERLIN, VERMONT", PREPARED BY OTTER CREEK ENGINEERING, DATED 8/8/16.
 - B. PLAN TITLED "NORTHFIELD SAVINGS BANK OPERATIONS CENTER", PREPARED BY DUBOIS & KING INC., SOUTH BURLINGTON, VERMONT, DATED 3/17/2014.
 - C. PLAN TITLED "802 HONDA BUILDING ADDITION" PREPARED BY DEWOLFE ENGINEERING ASSOCIATES, MONTPELIER, VERMONT, DATED 1/30/17, REVISED 2/10/17.
 - D. PLAN TITLED "BEAULIEU PLACE, CENTRAL VERMONT CHAMBER OF COMMERCE, BERLIN, VERMONT ~ JUNE, 1992", BY KELLER AND LOWE INC. ~ WATERBURY, VERMONT.
3. ELEVATION IS BASED ON NAVD 88.
4. COORDINATE SYSTEM IS BASED ON NAD83 VT FEET.
5. FOR CLARITY, TEXT DENOTING EXISTING ITEMS IS SHOWN IN LOWER CASE, AND TEXT DENOTING PROPOSED ITEMS IS UPPERCASE AND BOLD.
6. REFER TO LEGEND LOCATED ON THIS SHEET FOR SYMBOL AND ABBREVIATION DESIGNATIONS.
7. ALL UNDERGROUND UTILITIES ARE SHOWN AS APPROXIMATE LOCATIONS.
8. THIS IS NOT A BOUNDARY SURVEY.
9. CONTRACT DOCUMENTS AND TECHNICAL SPECIFICATIONS ACCOMPANY THESE PLANS AND ARE ESSENTIAL FOR CONSTRUCTION OF THIS PROJECT.

CONSTRUCTION NOTES


1. PRIOR TO ANY CONSTRUCTION AND FOLLOWING DIG SAFE MARKING, THE CONTRACTOR'S SUPERINTENDENT AND TOWN REPRESENTATIVES SHALL LOCATE, MARK OUT AND/OR STAKE EXISTING UNMARKED UTILITIES THROUGHOUT ALL CONSTRUCTION AREAS. CONTRACTOR SHALL ALSO CONTACT SIGNAL MAINTENANCE SUPERVISOR DAN ERTLE TO LOCATE AND MARK OUT SIGNAL CONTROLS. FOLLOWING ALL MARKING, THE CONTRACTOR SHALL PRESENT THE TOWN AND ENGINEER WITH AN UPDATED SCHEDULE AND ALL PARTIES SHALL DISCUSS AND RESOLVE HOW CONSTRUCTION WILL BE COMPLETED IN ANY LOCATIONS OF CONCERN.
2. THE CONTRACTOR SHALL CONTACT TOWN AND OCCUPANTS OF EACH BUILDING A MINIMUM OF 48 HOURS PRIOR TO SHUTTING OFF ANY UTILITY.
3. CONTRACTOR SHALL SUBMIT A CONSTRUCTION SCHEDULE AND A SITE SPECIFIC TRAFFIC CONTROL/DETOUR PLAN TO TOWN AND VTRANS FOR REVIEW AND APPROVAL PRIOR TO CONSTRUCTION. ALL TRAFFIC CONTROL AND DETOUR MEASURES SHALL MEET CURRENT MUTCD STANDARDS, AND ACCEPTANCE OF PLAN BY VTRANS IS A REQUIREMENT OF THIS CONTRACT.
4. CONTRACTOR SHALL PROVIDE ADEQUATE VEHICULAR BARRIERS AROUND WORK AREAS. WORK AREAS SHALL BE ADEQUATELY SIGNED.
5. CONTRACTOR SHALL CONTACT TOWN OF BERLIN POLICE AND FIRE DEPARTMENTS, VERMONT STATE POLICE AND CENTRAL VERMONT MEDICAL CENTER AND LOCAL EMT SERVICE A MINIMUM OF 3 DAYS PRIOR TO ANY ROAD CLOSURES. IN ADDITION, THE CONTRACTOR SHALL NOTIFY LOCAL BUS SERVICES OF ANY SHUTDOWN.
6. CONTRACTOR SHALL MAKE EVERY EFFORT TO ALLOW ACCESS TO AND FROM DRIVEWAYS LOCATED ALONG THE PROJECT SITE. OCCUPANTS SHALL BE NOTIFIED A MINIMUM OF 24 HOURS IN ADVANCE OF ANY DRIVEWAY CROSSINGS WHICH WILL LIMIT THE ACCESS TO THEIR PROPERTY.
7. CONTRACTOR SHALL MAINTAIN SAFE PEDESTRIAN ACCESS THROUGHOUT THE SITE. BICYCLE ACCOMMODATIONS SHOULD BE TAKEN TO ENSURE THAT OBSTACLES, EQUIPMENT, CONSTRUCTION MATERIALS, AND TRAFFIC CONTROL DEVICES DO NOT ENCRUSH INTO THE BICYCLE PATH OF TRAVEL. IT IS IMPORTANT THAT CYCLIST ROUTES ARE FREE OF RUTS, SAND, AND MUD TO PREVENT CYCLIST CRASHES. REFER TO SPECIAL CONDITIONS SPECIFICATIONS.
8. CONTRACTOR SHALL MAINTAIN WATER AND SEWER SERVICES TO ALL CUSTOMERS DURING CONSTRUCTION UNLESS A SCHEDULED, SHORT-TERM SHUTDOWN IS PREVIOUSLY APPROVED BY TOWN. CONTRACTOR SHALL INSTALL TEMPORARY WATER AND SEWER SERVICE LINES IN AREAS WHERE THE CONSTRUCTION WILL LIKELY DAMAGE THE EXISTING WATER MAIN OR SERVICE.
9. EXPLORATORY EXCAVATIONS ARE REQUIRED PRIOR TO COMMENCING WITH ORDERING OF STRUCTURES. REFER TO SPECIAL CONDITIONS FOR A LIST OF PROPOSED LOCATIONS. THE TOWN AND ENGINEER ARE REQUIRED TO BE NOTIFIED A MINIMUM OF 24 HOURS PRIOR TO EXCAVATION. INFORMATION RESULTING FROM EXCAVATIONS MUST BE PROVIDED TO THE ENGINEER WITHIN 24 HOURS OF COMPLETING EXCAVATION.
10. ALL WATER, STORM, SEWER, AND SERVICES CROSSED BY PROPOSED SEWER MAINS ARE PRESUMED TO REQUIRE PORTIONS TO BE REPAIRED/REPLACED.
11. OVERHEAD UTILITIES ARE NOT SHOWN ON THE DRAWINGS FOR CLARITY. CONTRACTOR SHALL REVIEW OVERHEAD UTILITY LOCATIONS, AND TAKE APPROPRIATE MEASURES TO PROTECT UTILITIES FROM DAMAGE. CONTRACTOR TO ARRANGE FOR POLE OWNER TO SUPPORT POLES DURING CONSTRUCTION, AS REQUIRED. ALL COSTS ASSOCIATED WITH POLE SUPPORT, TEMPORARY RELOCATION OR LIKEWISE SHALL BE ON THE RESPONSIBILITY OF THE CONTRACTOR.

DEMOLITION AND ABANDONMENT NOTES

1. THE PROJECT REQUIRES THE DEMOLITION AND ABANDONMENT OF THREE EXISTING WASTEWATER PUMP STATIONS AND THEIR ASSOCIATED APPURTENANCES. THE FOLLOWING SEQUENCE OF WORK SHALL BE COMPLETED AT ALL STATIONS:
 - A. PUMPS, CONTROLS, MOTORS AND EQUIPMENT IN THE WET WELL SHALL BE COMPLETELY REMOVED FROM THE WET WELL.
 - B. ELECTRICAL SERVICE SHALL BE DISCONNECTED AND WIRES AND CONDUCTORS REMOVED. ALL CONDUITS SHALL BE SEALED.
 - C. ALL PIPE PENETRATIONS SHALL BE CAPPED OR PLUGGED IN THE WET WELL AND VALVE VAULTS.
 - D. ALL PIPE AND APPURTENANCES SHALL BE DEMOLISHED AND REMOVED FROM THE VALVE PITS.
2. WHERE PUMP STATIONS ARE ABANDONED IN PLACE, CONTRACTOR SHALL DEMO THE TOP FRAME AND ACCESS RISER OF ALL STRUCTURES. PERFORATE THE BOTTOM OF EACH STRUCTURE WITH 3/4" DRILL HOLES AND FILL THE VOID WITH 3/4" CRUSHED STONE.
3. WHERE PUMP STATIONS ARE TO BE REMOVED, THE VOID SHALL BE FILLED WITH COMPACTED CRUSHED GRAVEL AND ALL PIPES SHALL BE CAPPED.

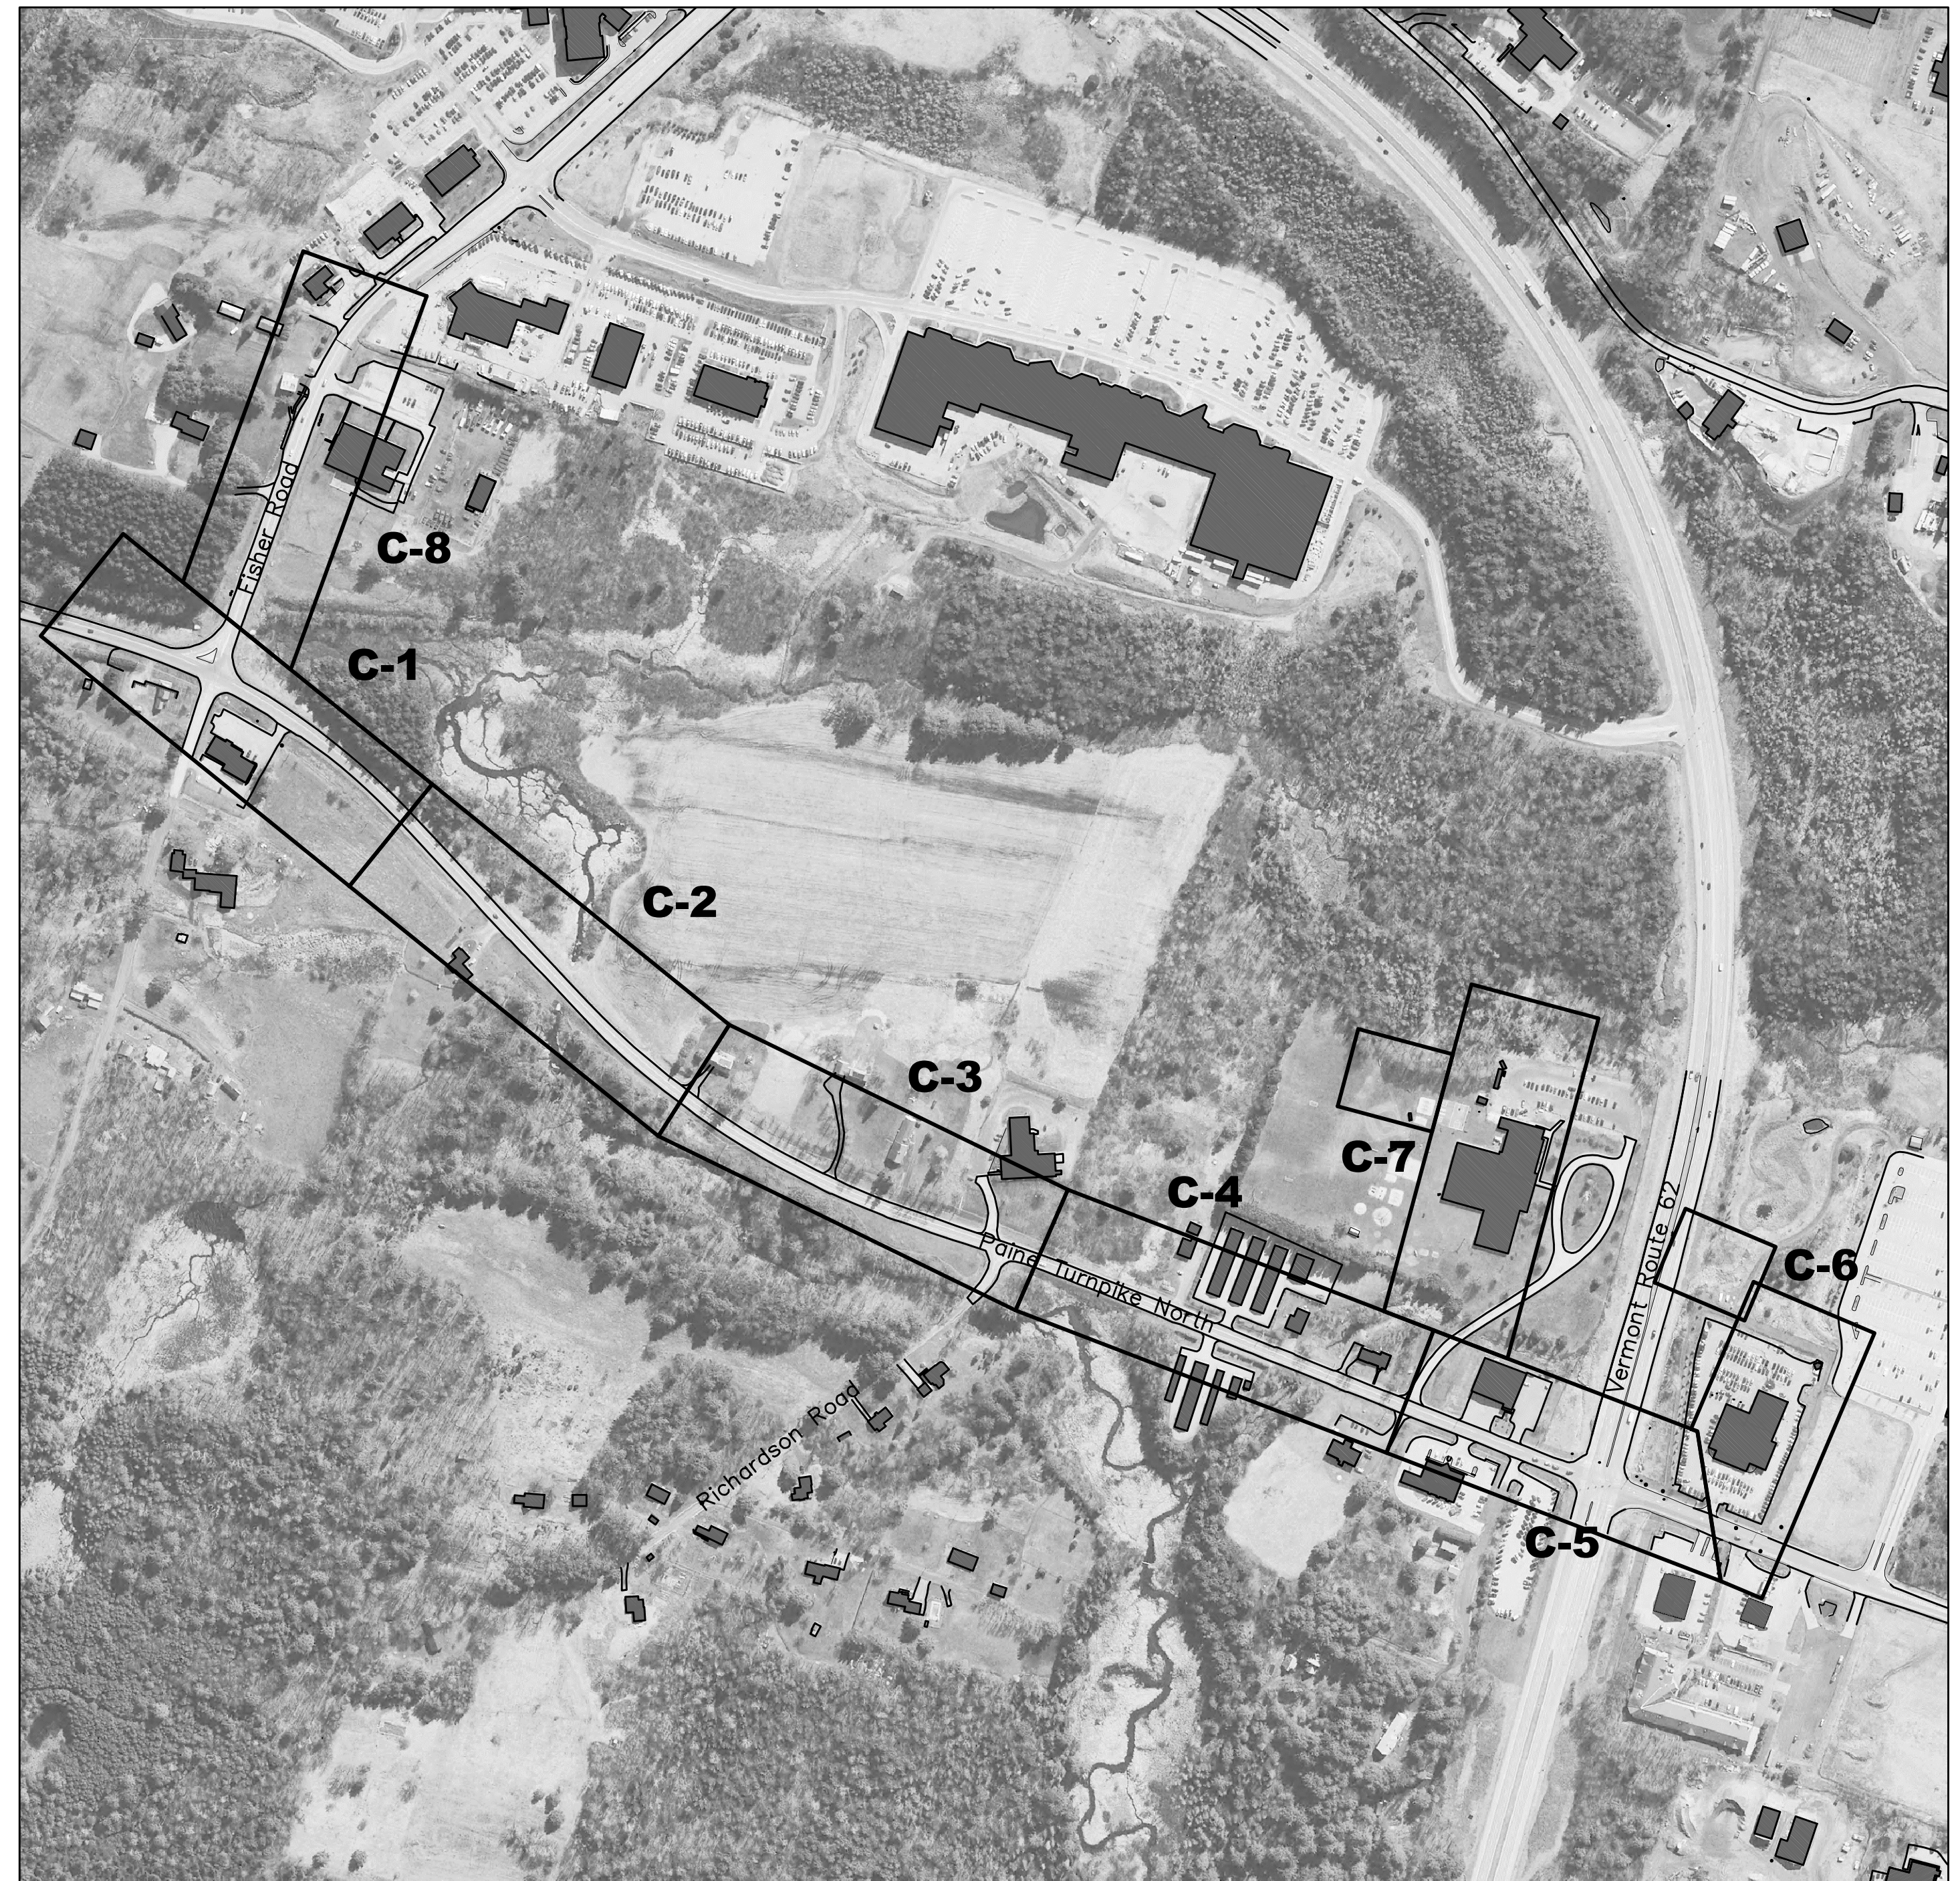

GRAPHIC SCALE

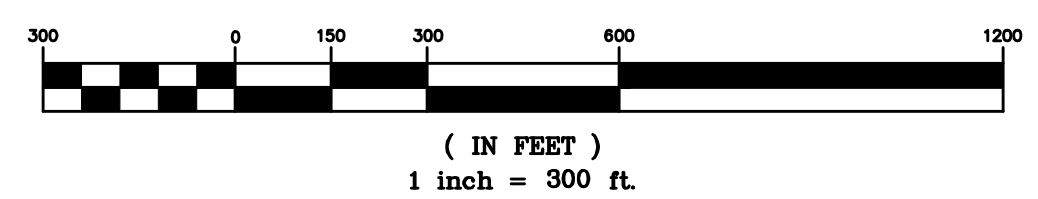

SHEET TITLE

REV. NO. DATE

SHEET	TITLE	REV. NO.	DATE
I-1	INDEX PLAN	-	-
C-1	SITE PLAN AND PROFILE	-	-
C-2	SITE PLAN AND PROFILE	-	-
C-3	SITE PLAN AND PROFILE	-	-
C-4	SITE PLAN AND PROFILE	-	-
C-5	SITE PLAN AND PROFILE	-	-
C-6	SITE PLAN AND PROFILE	-	-
C-7	SITE PLAN AND PROFILE	-	-
C-8	SITE PLAN AND PROFILE	-	-
C-9	PROFILES	-	-
C-10	PUMP STATION DETAILS	-	-
C-11	DETAILS	-	-
C-12	DETAILS AND NOTES	-	-
C-13	DETAILS AND NOTES	-	-
C-14	DETAILS AND NOTES	-	-
E1	ELECTRICAL LEGEND	-	-
E2	ELECTRICAL SITE PLAN	-	-

RECORD DRAWING

Record drawings have been prepared on the basis of information furnished by others. The engineer is not responsible for errors or omissions which have been incorporated into this document as a result. The location of items shown without labeled dimensions shall be considered as approximate. Profiles show general layout. Due to changes during construction, alignment, station and elevation information may not be correct. The site was not re-surveyed after construction, so "as-built" locations, elevations and finish grades are approximate and shall be considered "schematic". Details and cross sections may not reflect "as built" conditions. Prepared by : Otter Creek Engineering, Inc., East Middlebury, Vermont.




OTTER CREEK ENGINEERING

404 East Main Street
P.O. Box 712
East Middlebury, VT 05740
Telephone: 802.382.8522
Fax: 802.382.8640

110 Merchants Row
4th Floor, Suite 15
Rutland, VT 05701
Telephone: 802.747.3080
Fax: 802.747.4820

E-mail: info@ottercrk.com


STAMP AND SIGNATURE:

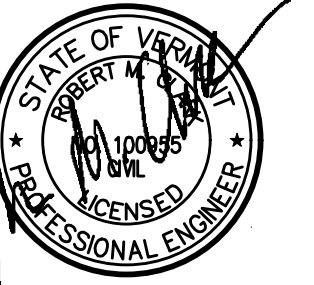

DESIGN ENGINEER

THESE DRAWINGS SHALL NOT BE ALTERED IN ANY WAY WITHOUT THE WRITTEN APPROVAL OF THE ENGINEER. ANY REVISIONS SHALL BE MADE BY THE ENGINEER AND NOTED IN THE REVISION BLOCK. © 2021

OTTER CREEK ENGINEERING, INC.

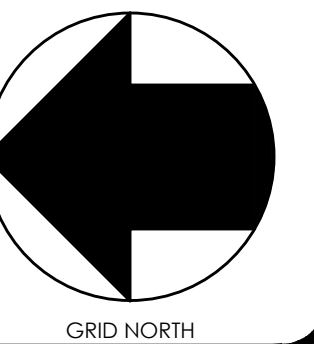

**TOWN OF BERLIN
PAINE TURNPIKE NORTH
WASTEWATER
IMPROVEMENTS
BERLIN, VERMONT**

RECORD

DATE ISSUED: 6/30/2021
REVISIONS:

DRAWN BY: RR
CHECKED BY: JK
SCALE: 1"=300'
PROJECT NO.: 519.005
CADD FILE:

TITLE: INDEX PLAN





DRAWING NO.

I-1

MATCH LINE

MATCH TO DRAWING C-8

MATCH TO DRAWING C-2

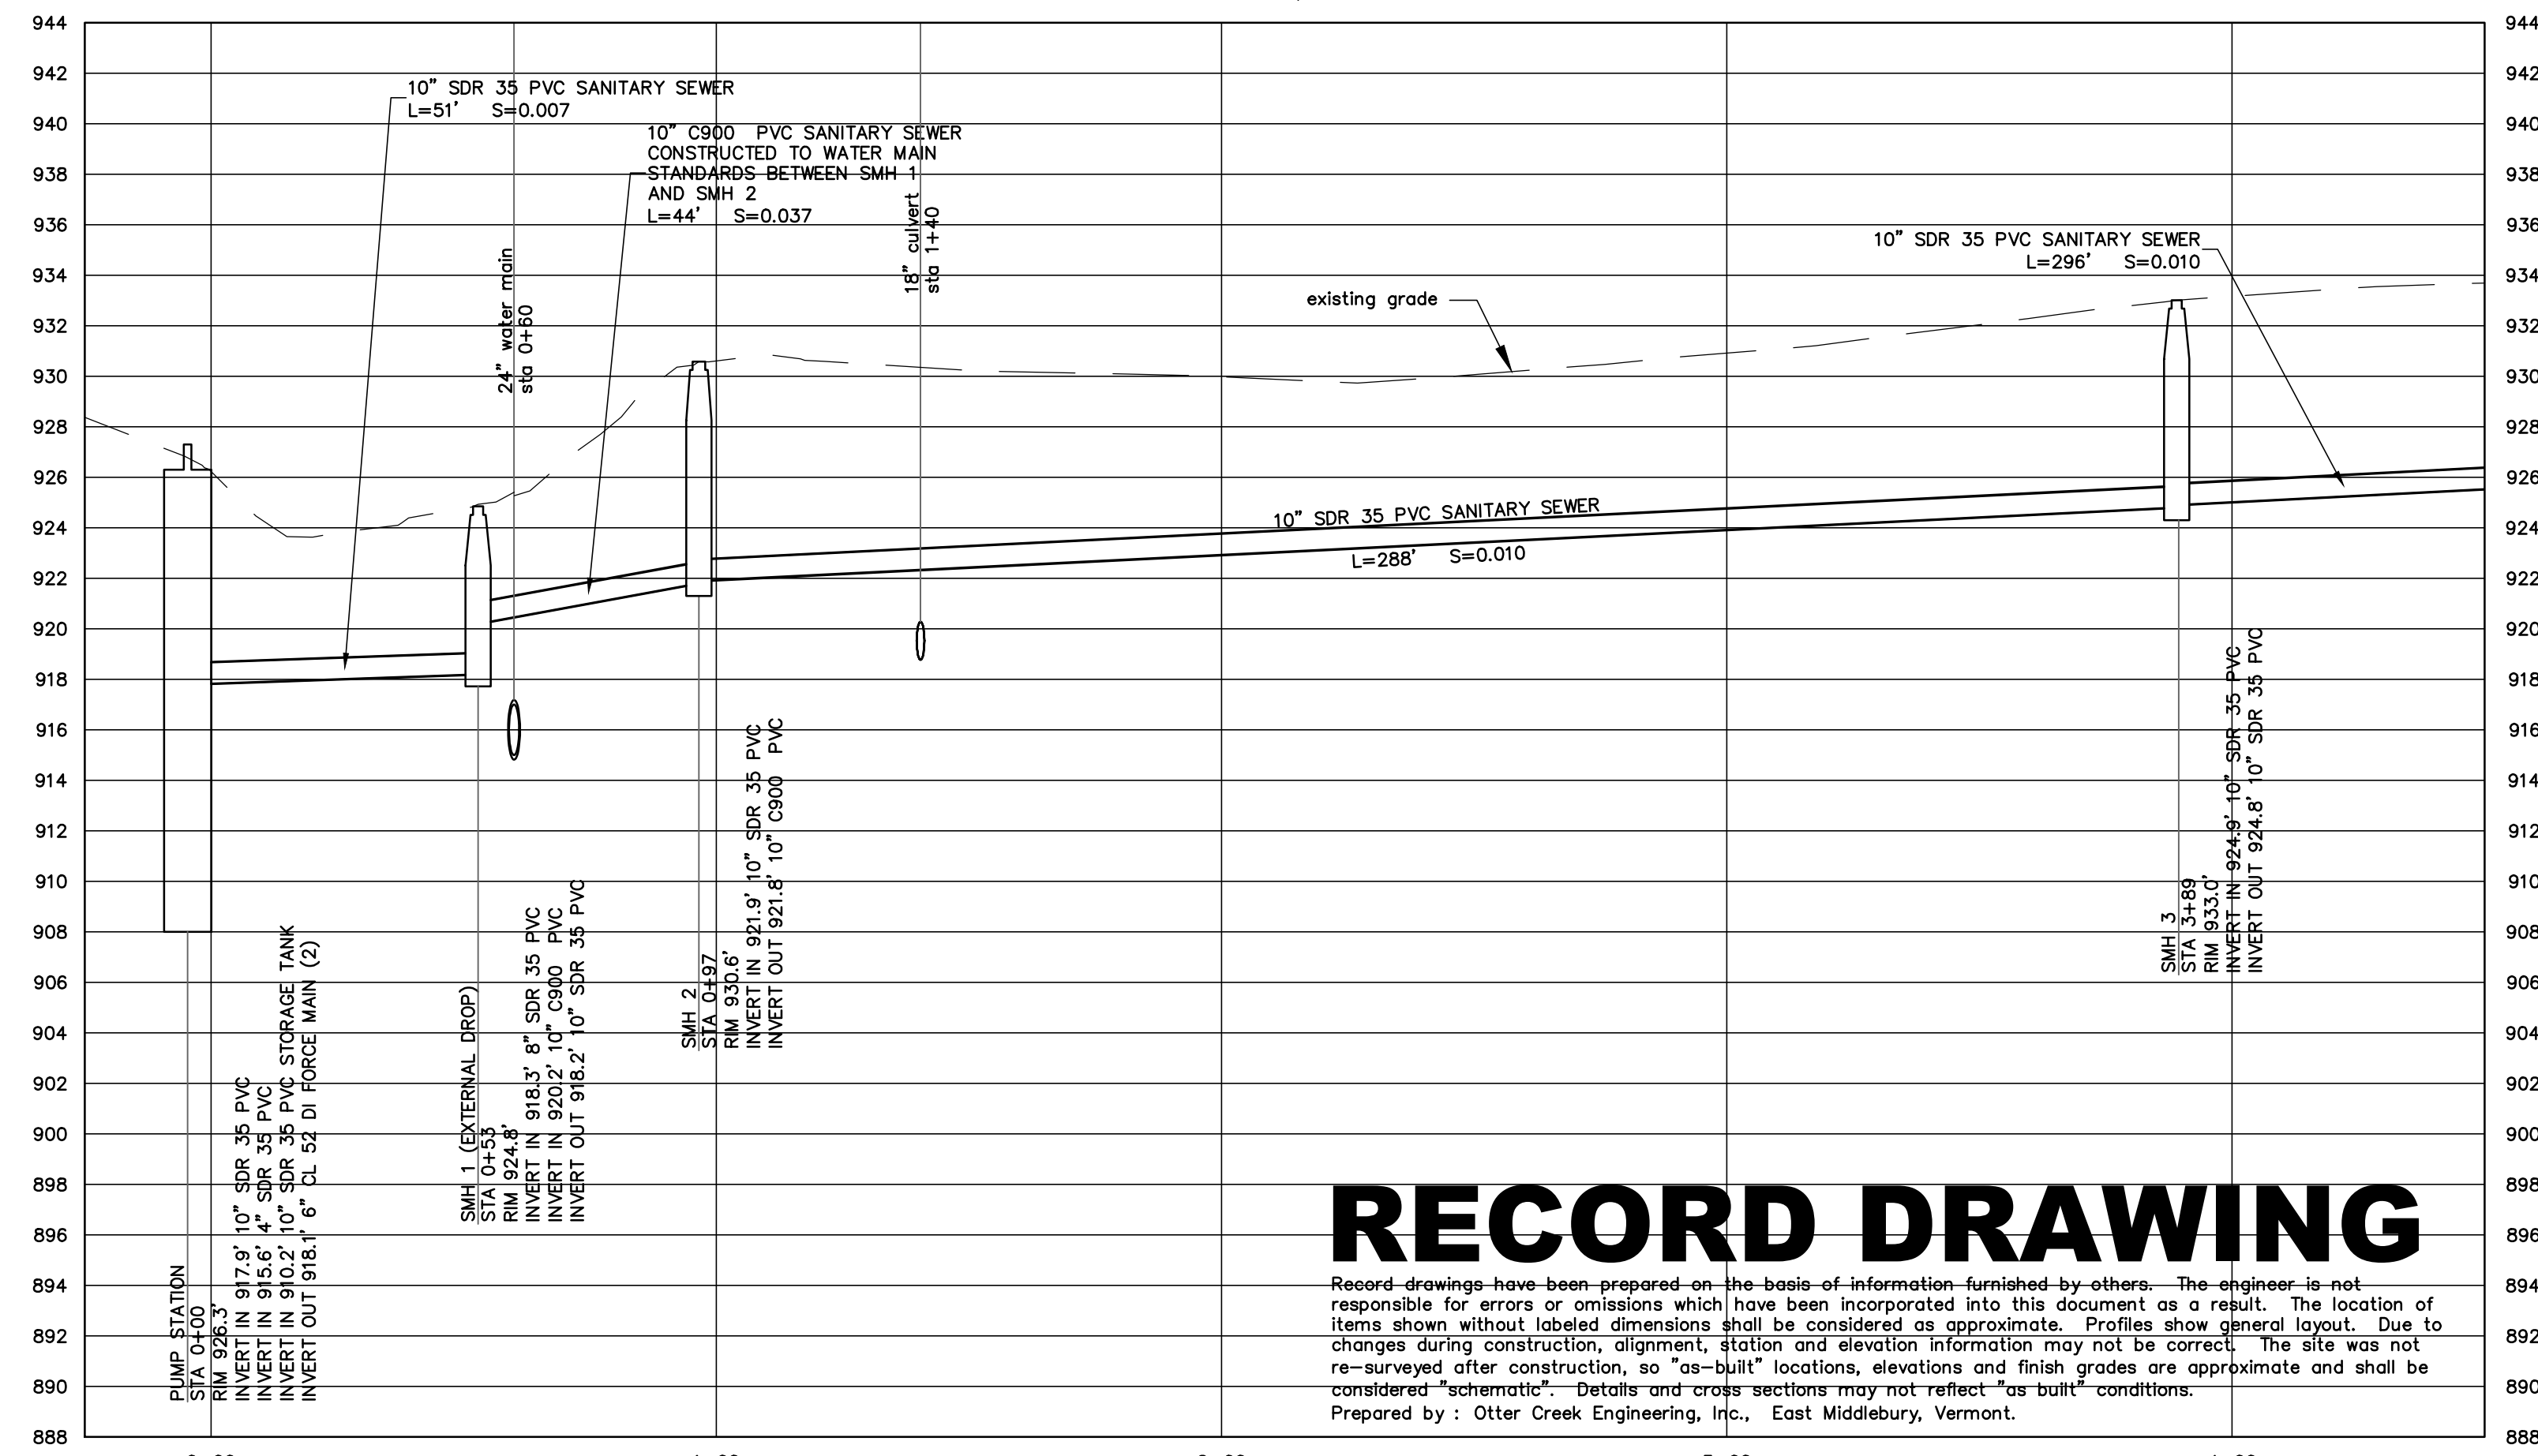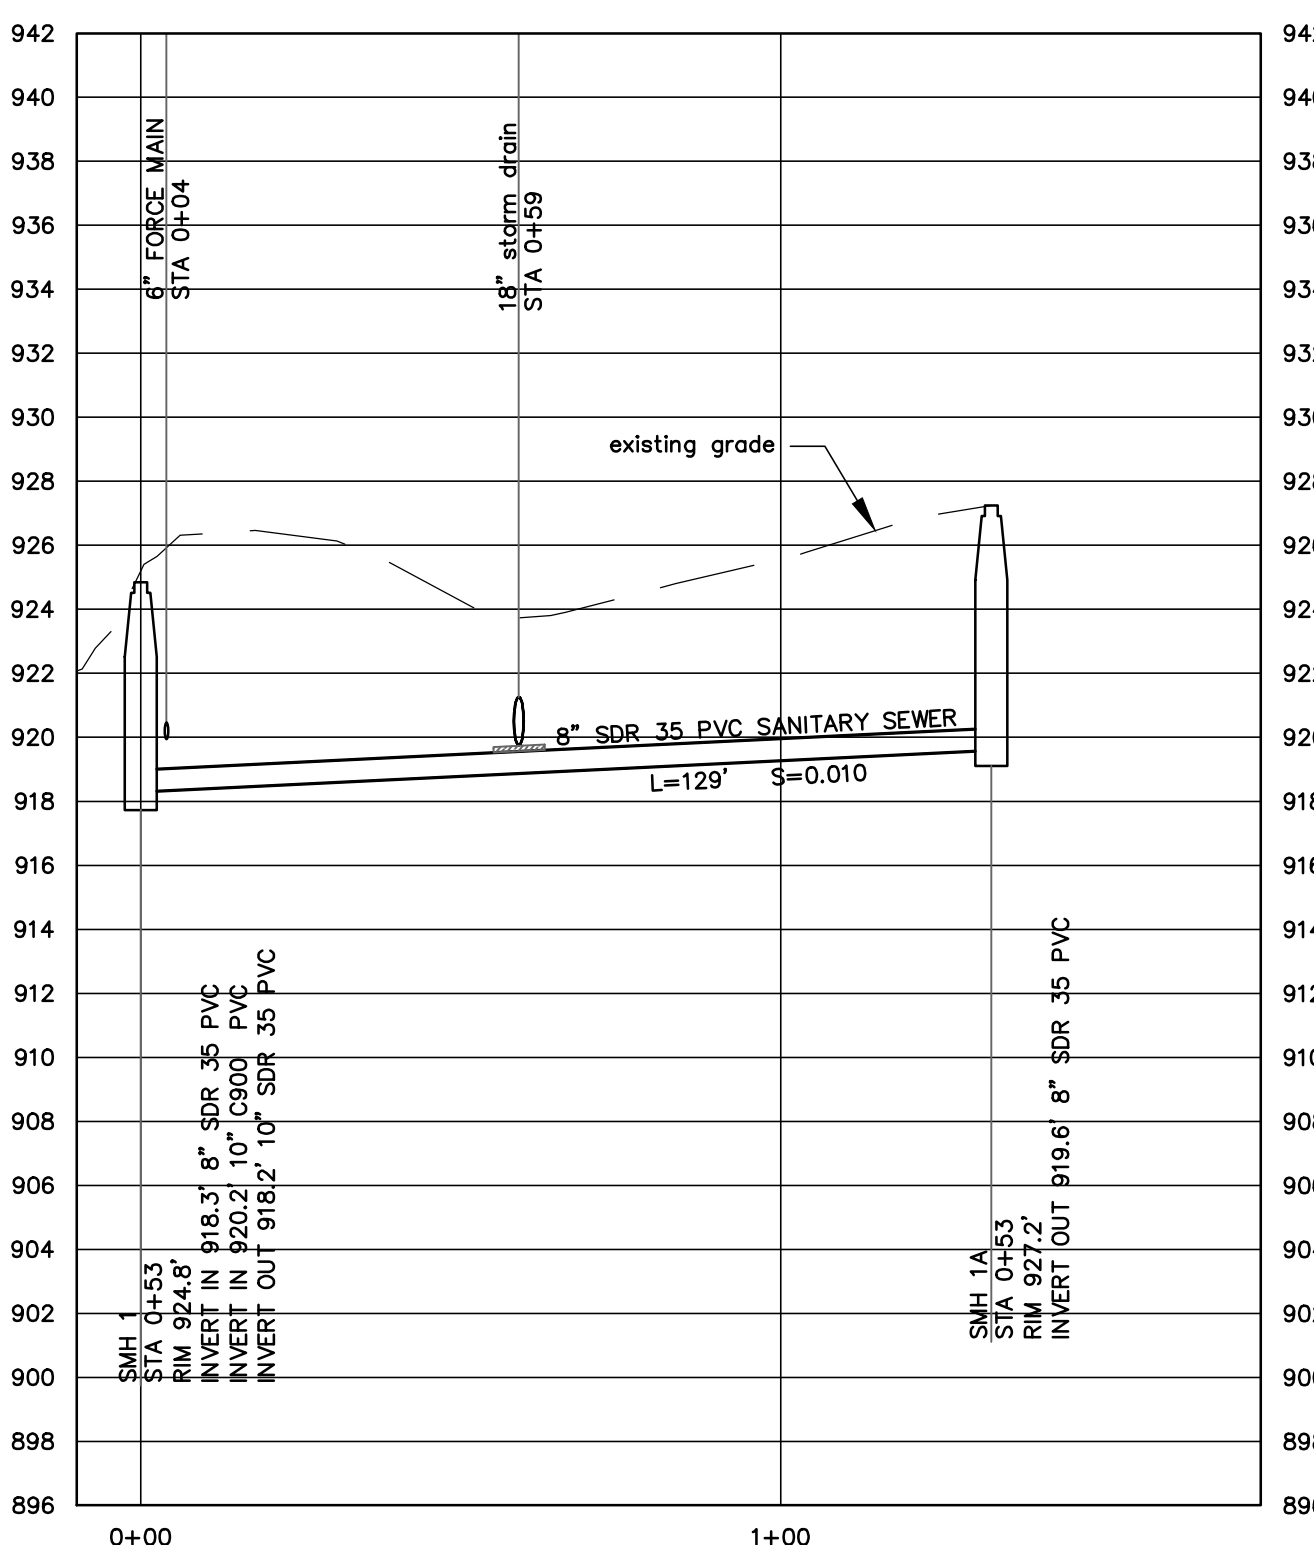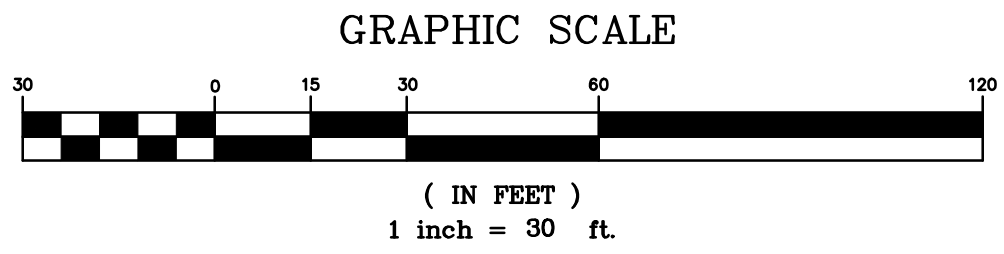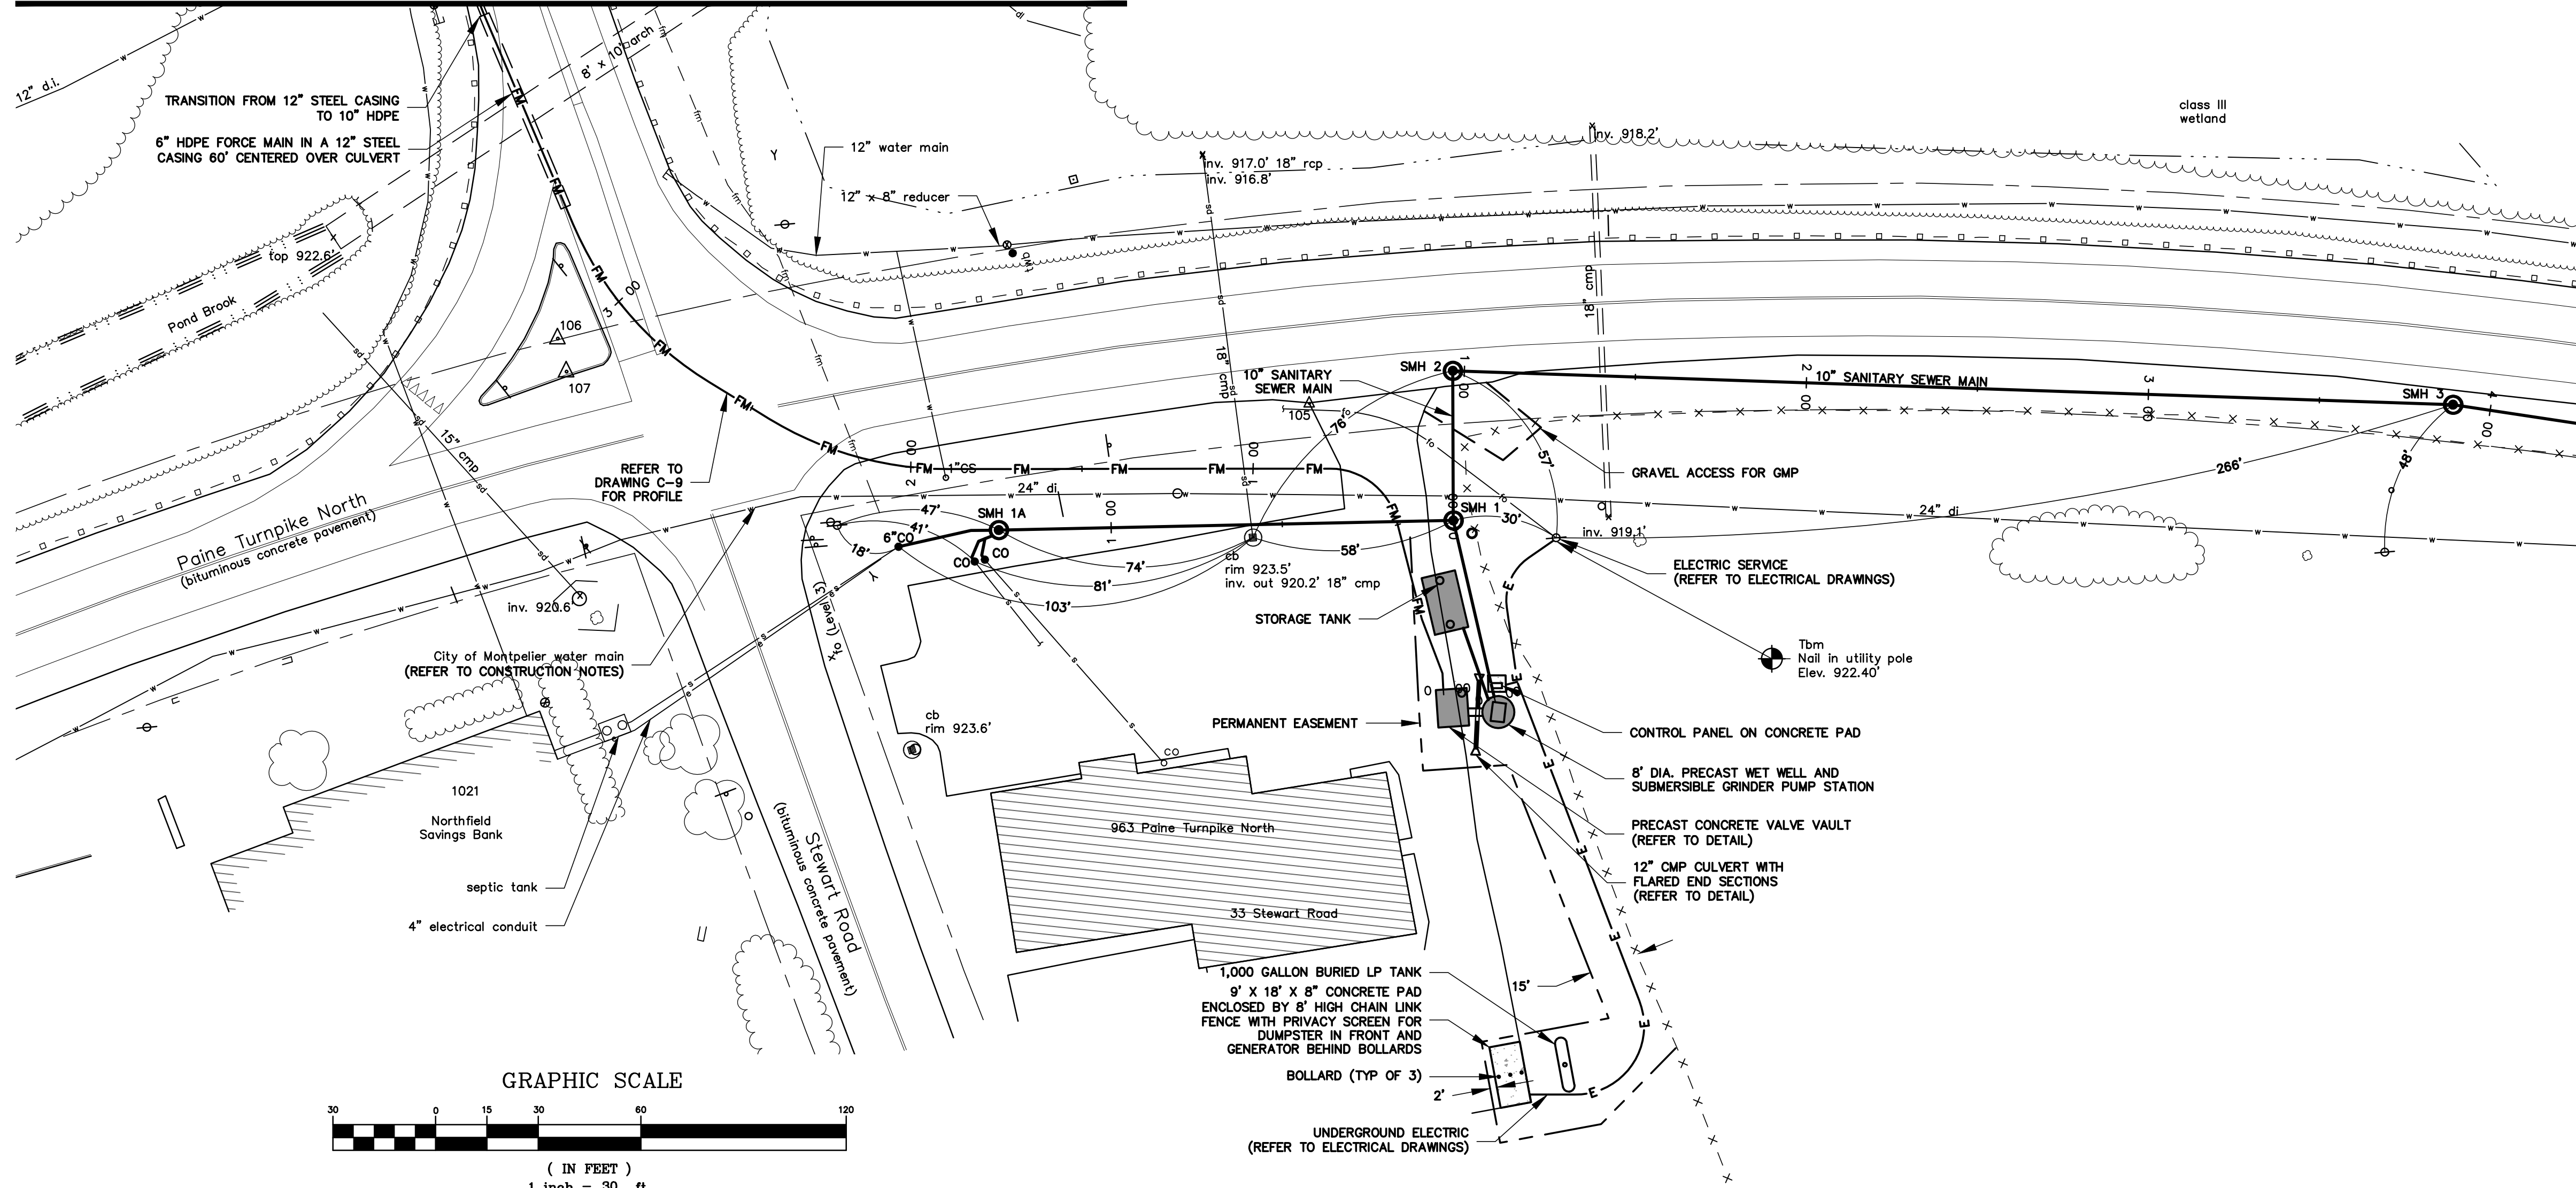


RECORD DRAWING

Record drawings have been prepared on the basis of information furnished by others. The engineer is not responsible for errors or omissions which have been incorporated into this document as a result. The location of items shown without labeled dimensions shall be considered as approximate. Profiles show general layout. Due to changes during construction, alignment, station and elevation information may not be correct. The site was not re-surveyed after construction, so "as-built" locations, elevations and finish grades are approximate and shall be considered "schematic". Details and cross sections may not reflect "as built" conditions.
Prepared by: Otter Creek Engineering, Inc., East Middlebury, Vermont.

OTTER CREEK ENGINEERING
404 East Main Street
P.O. Box 712
East Middlebury, VT 05740
Telephone: 802-382-8522
Fax: 802-382-8440
110 Merchants Row
4th Floor, Suite 15
Rutland, VT 05701
Telephone: 802-747-3080
Fax: 802-747-4820
E-mail: info@ottercreek.com

STAMP AND SIGNATURE:
STATE OF VERMONT
ROBERT M. DEAR
10095
LICENSED PROFESSIONAL ENGINEER
DESIGN ENGINEER

THESE DRAWINGS SHALL NOT BE ALTERED IN ANY WAY WITHOUT THE WRITTEN APPROVAL OF THE ENGINEER. ANY REVISIONS SHALL BE MADE BY THE ENGINEER AND NOTED IN THE REVISION BLOCK. © 2021
OTTER CREEK ENGINEERING, INC.

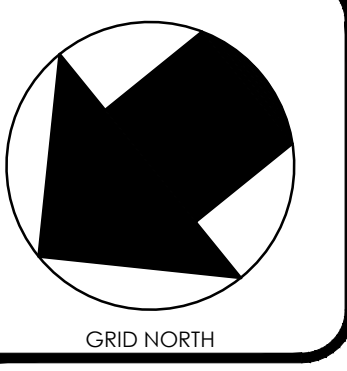

**TOWN OF BERLIN
PAINE TURNPIKE NORTH
WASTEWATER
IMPROVEMENTS
BERLIN, VERMONT**




RECORD
DATE ISSUED: 6/30/2021
REVISIONS:
DRAWN BY: RR
CHECKED BY: JK
SCALE: 1"=30'
PROJECT NO.: 519.005
CADD FILE: 519-005
TITLE: SITE PLAN AND PROFILE
DRAWING NO. C-1

MATCH TO DRAWING C-1

MATCH LINE

MATCH LINE

MATCH TO DRAWING C-3

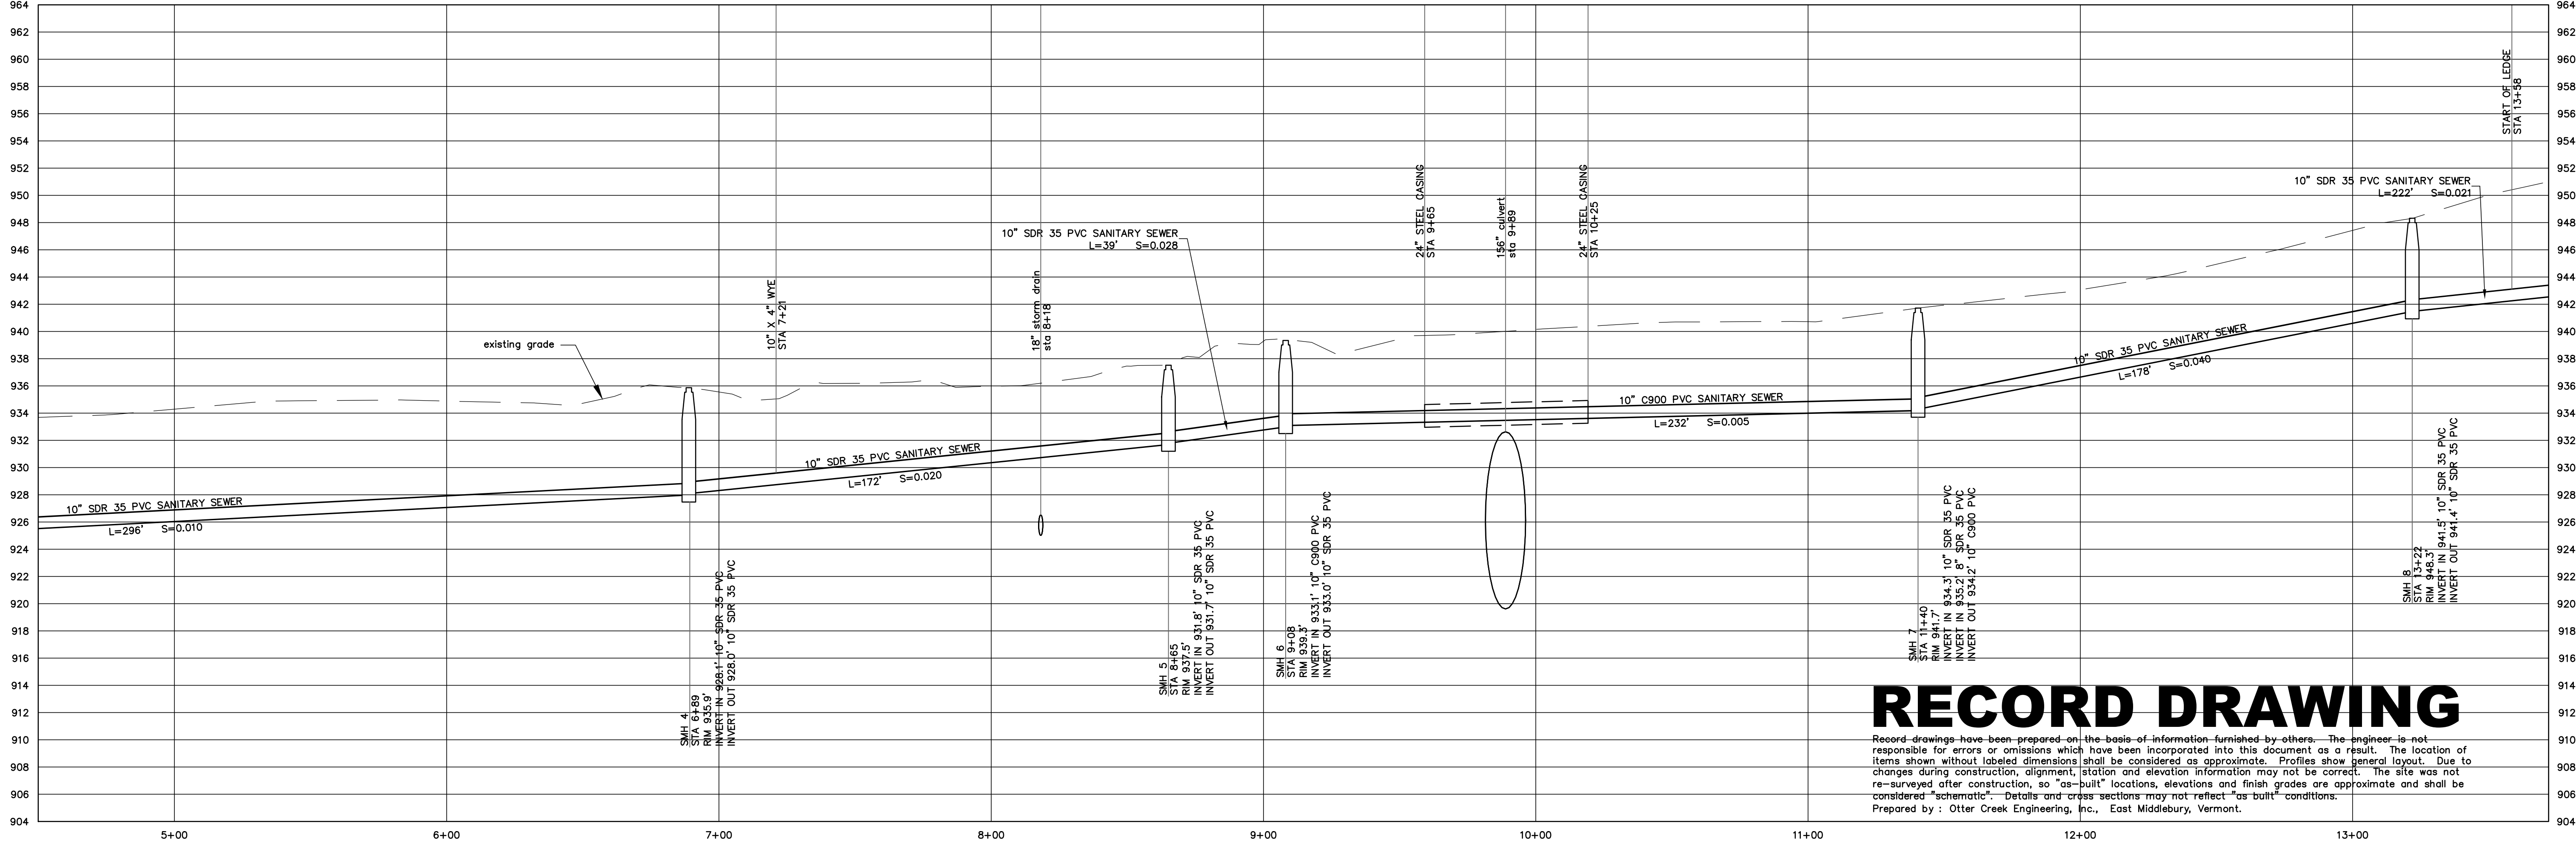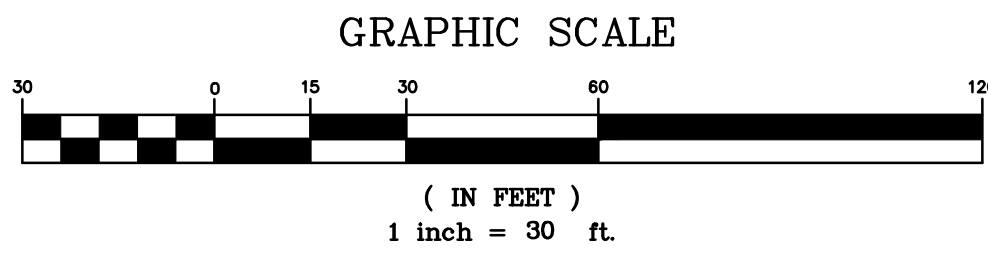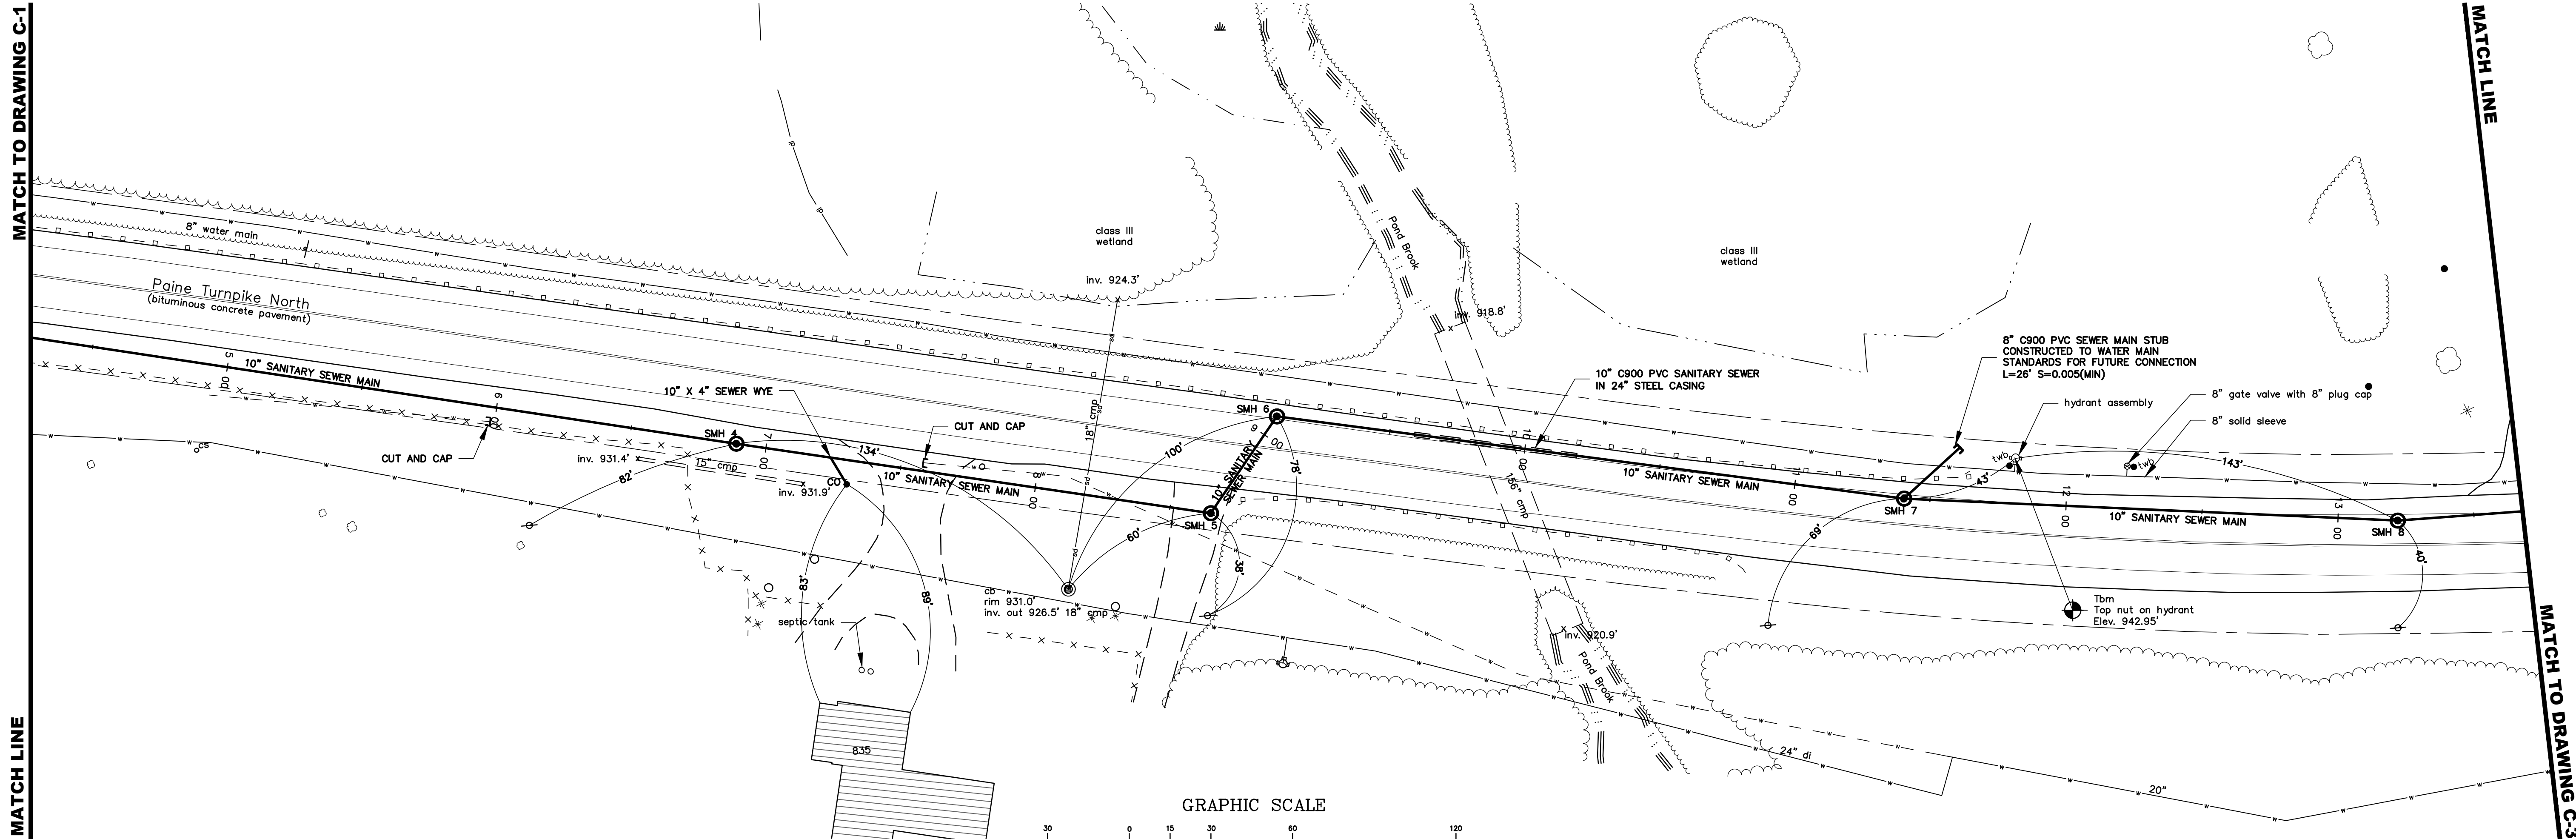


PAINÉ TURNPIKE NORTH SEWER MAIN PROFILE
 SCALE: 1" = 30' HORIZONTAL
 1" = 6' VERTICAL

RECORD DRAWING


Record drawings have been prepared on the basis of information furnished by others. The engineer is not responsible for errors or omissions which have been incorporated into this document as a result. The location of items shown without labeled dimensions shall be considered as approximate. Profiles show general layout. Due to changes during construction, alignment, station and elevation information may not be correct. The site was not re-surveyed after construction, so "as-built" locations, elevations and finish grades are approximate and shall be considered "schematic". Details and cross sections may not reflect "as-built" conditions.
 Prepared by: Otter Creek Engineering, Inc., East Middlebury, Vermont.

OTTER CREEK ENGINEERING
 404 East Main Street
 P.O. Box 712
 East Middlebury, VT 05740
 Telephone: 802.382.8522
 Fax: 802.382.8640
 110 Merchants Row
 4th Floor, Suite 15
 Rutland, VT 05701
 Telephone: 802.747.3080
 Fax: 802.747.4820
 E-mail: info@ottercrk.com

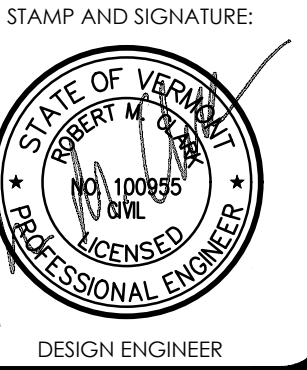

THESE DRAWINGS SHALL NOT BE ALTERED IN ANY WAY WITHOUT THE WRITTEN APPROVAL OF THE ENGINEER. ANY REVISIONS SHALL BE MADE BY THE ENGINEER AND NOTED IN THE REVISION BLOCK. © 2021

OTTER CREEK ENGINEERING, INC.

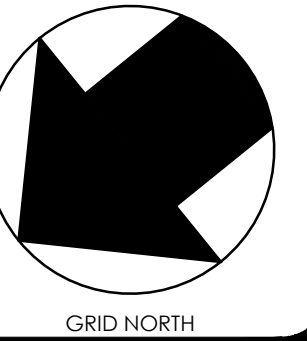

**TOWN OF BERLIN
 PAINÉ TURNPIKE NORTH
 WASTEWATER
 IMPROVEMENTS
 BERLIN, VERMONT**

RECORD

DATE ISSUED: 6/30/2021
 REVISIONS:
 DRAWN BY: RR
 CHECKED BY: JK
 SCALE: 1"=30'
 PROJECT NO.: 519.005
 CADD FILE:
 TITLE:
SITE PLAN AND PROFILE

DRAWING NO.
C-2




OTTER CREEK ENGINEERING

404 East Main Street
P.O. Box 712
East Middlebury, VT 05740
Telephone: 802.382.8522
Fax: 802.382.8440

110 Merchants Row
4th Floor, Suite 15
Rutland, VT 05701
Telephone: 802.747.3080
Fax: 802.747.4820
E-mail: info@ottercrk.com


STAMP AND SIGNATURE:

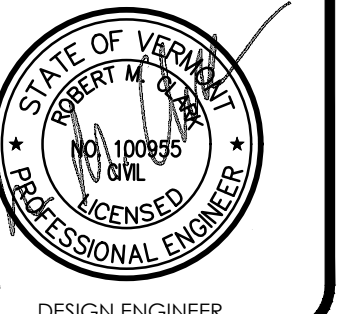

DESIGN ENGINEER

THESE DRAWINGS SHALL NOT
BE ALTERED IN ANY WAY
WITHOUT THE WRITTEN
APPROVAL OF THE ENGINEER.
ANY REVISIONS SHALL BE
MADE BY THE ENGINEER AND
NOTED IN THE REVISION
BLOCK. © 2021

OTTER CREEK ENGINEERING, INC.

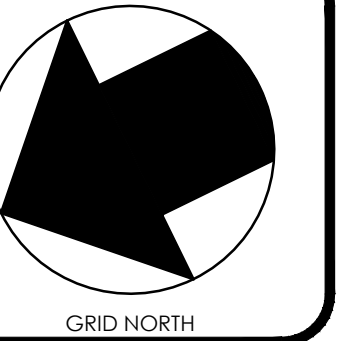

TOWN OF BERLIN
PAINÉ TURNPIKE NORTH
WASTEWATER
IMPROVEMENTS
BERLIN, VERMONT

RECORD

DATE ISSUED: 6/30/2021

REVISIONS:

DRAWN BY: RR

CHECKED BY: JK

SCALE: 1"=30'

PROJECT NO.: 519.005




CADD FILE:

TITLE:

SITE PLAN AND
PROFILE

DRAWING NO.

C-3

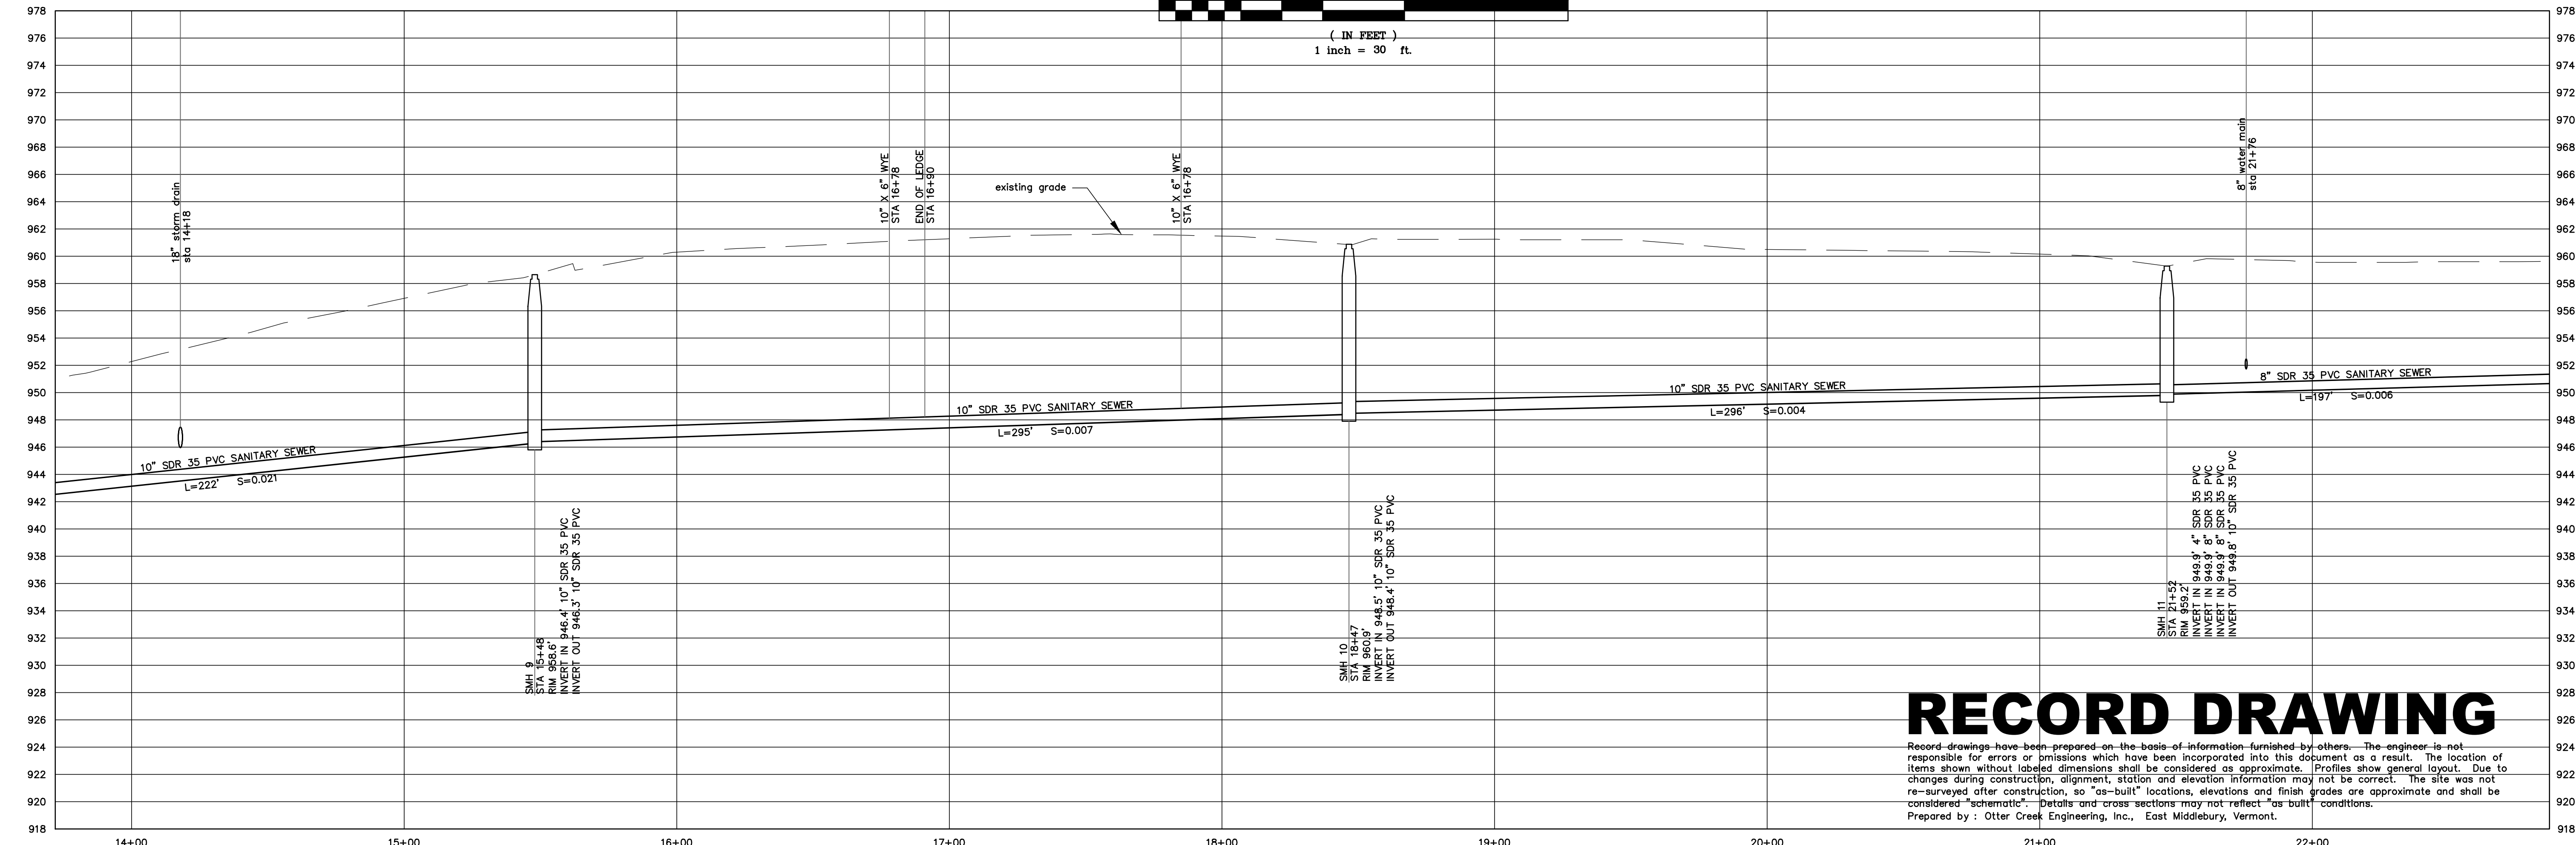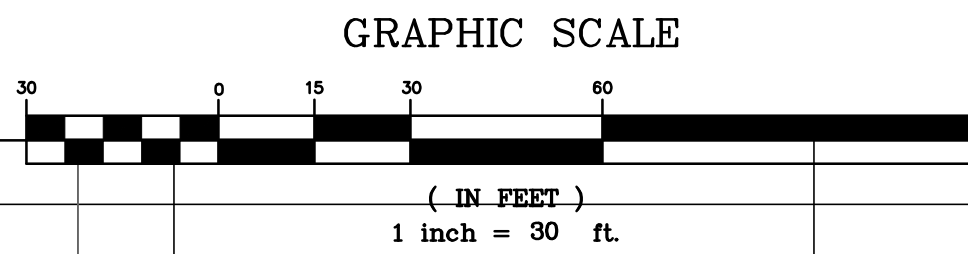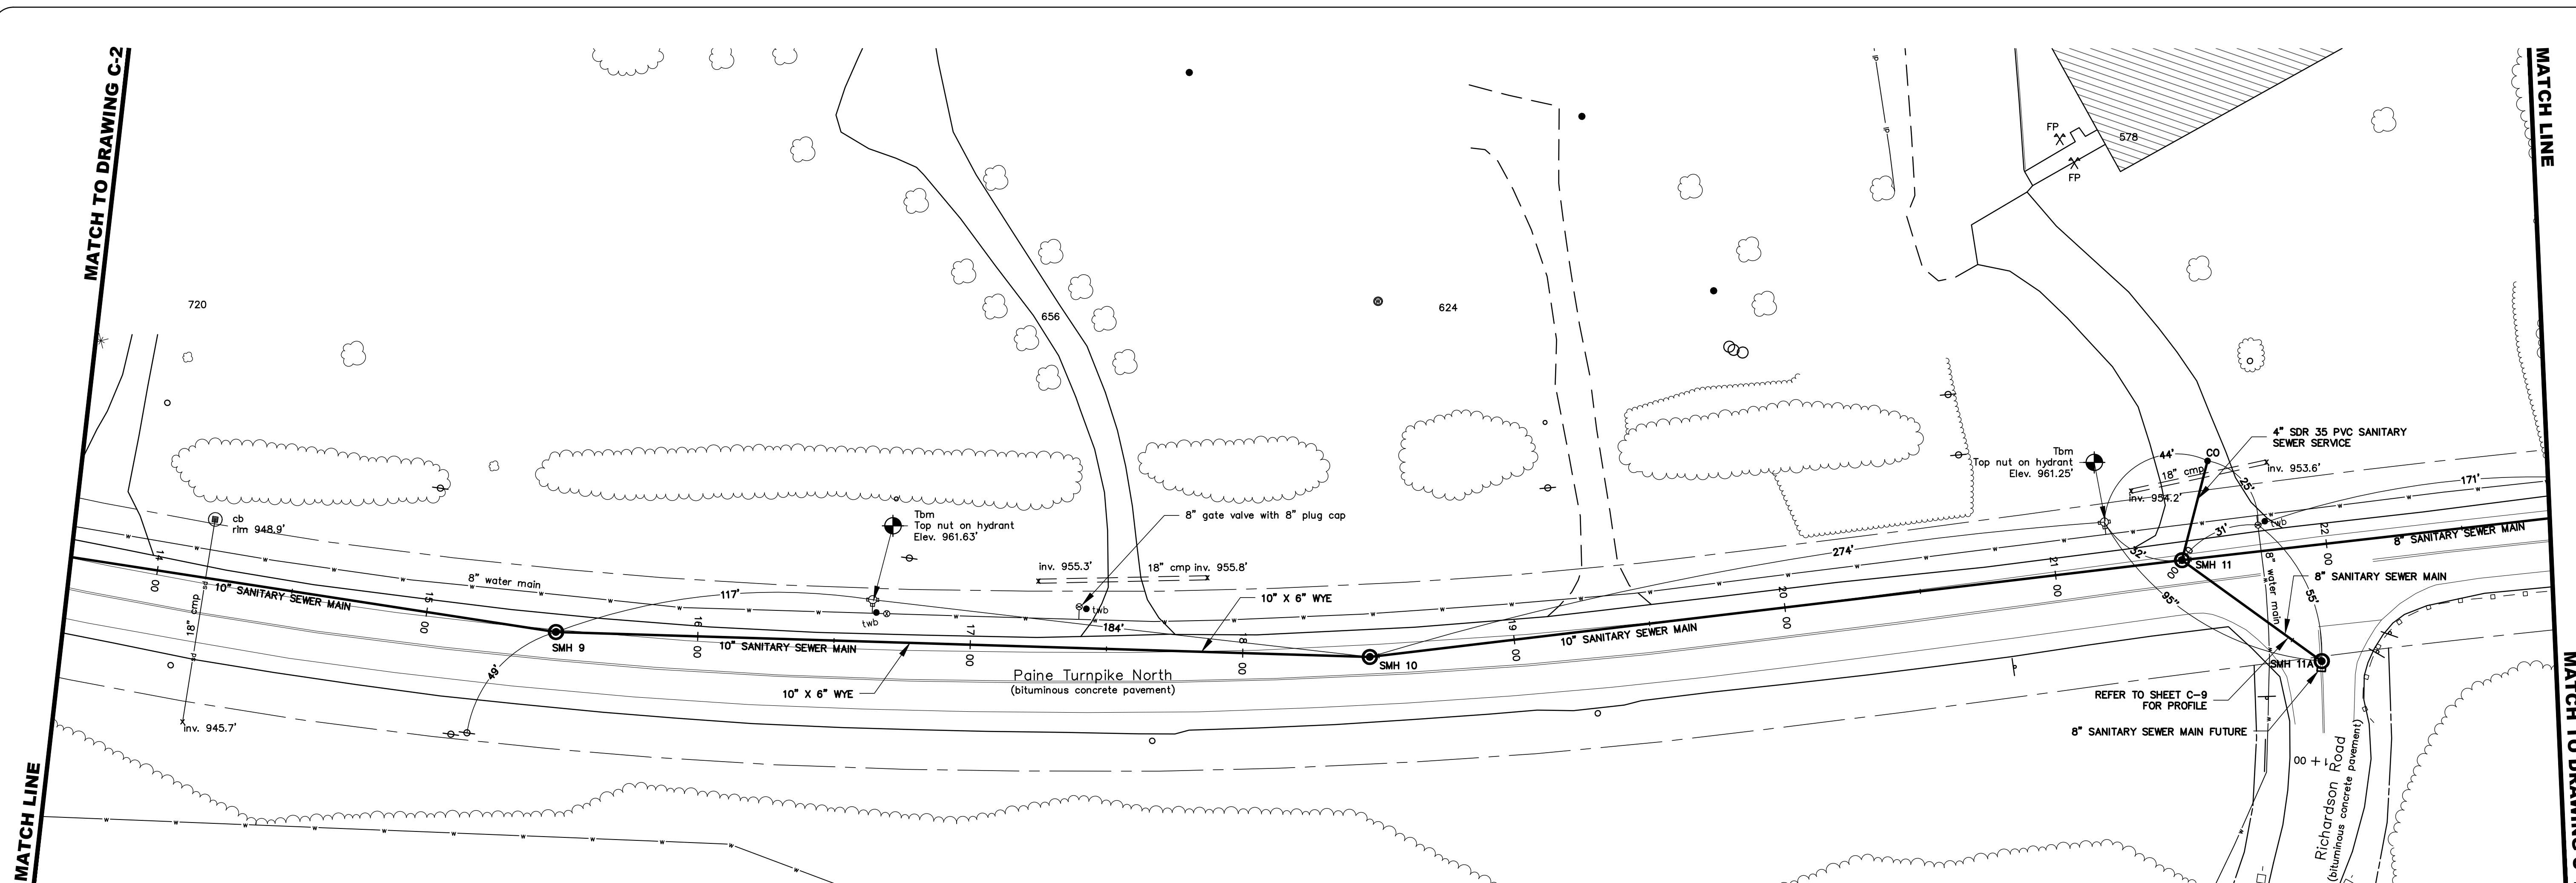

PAINÉ TURNPIKE NORTH SEWER MAIN PROFILE
SCALE: 1" = 30' HORIZONTAL
1" = 6' VERTICAL

RECORD DRAWING




Record drawings have been prepared on the basis of information furnished by others. The engineer is not responsible for errors or omissions which have been incorporated into this document as a result. The location of items shown without labeled dimensions shall be considered as approximate. Profiles show general layout. Due to changes during construction, alignment, station and elevation information may not be correct. The site was not re-surveyed after construction, so "as-built" locations, elevations and finish grades are approximate and shall be considered "schematic". Details and cross sections may not reflect "as built" conditions.
Prepared by: Otter Creek Engineering, Inc., East Middlebury, Vermont.

MATCH TO DRAWING C-3

MATCH LINE

MATCH TO DRAWING C-5

MATCH LINE

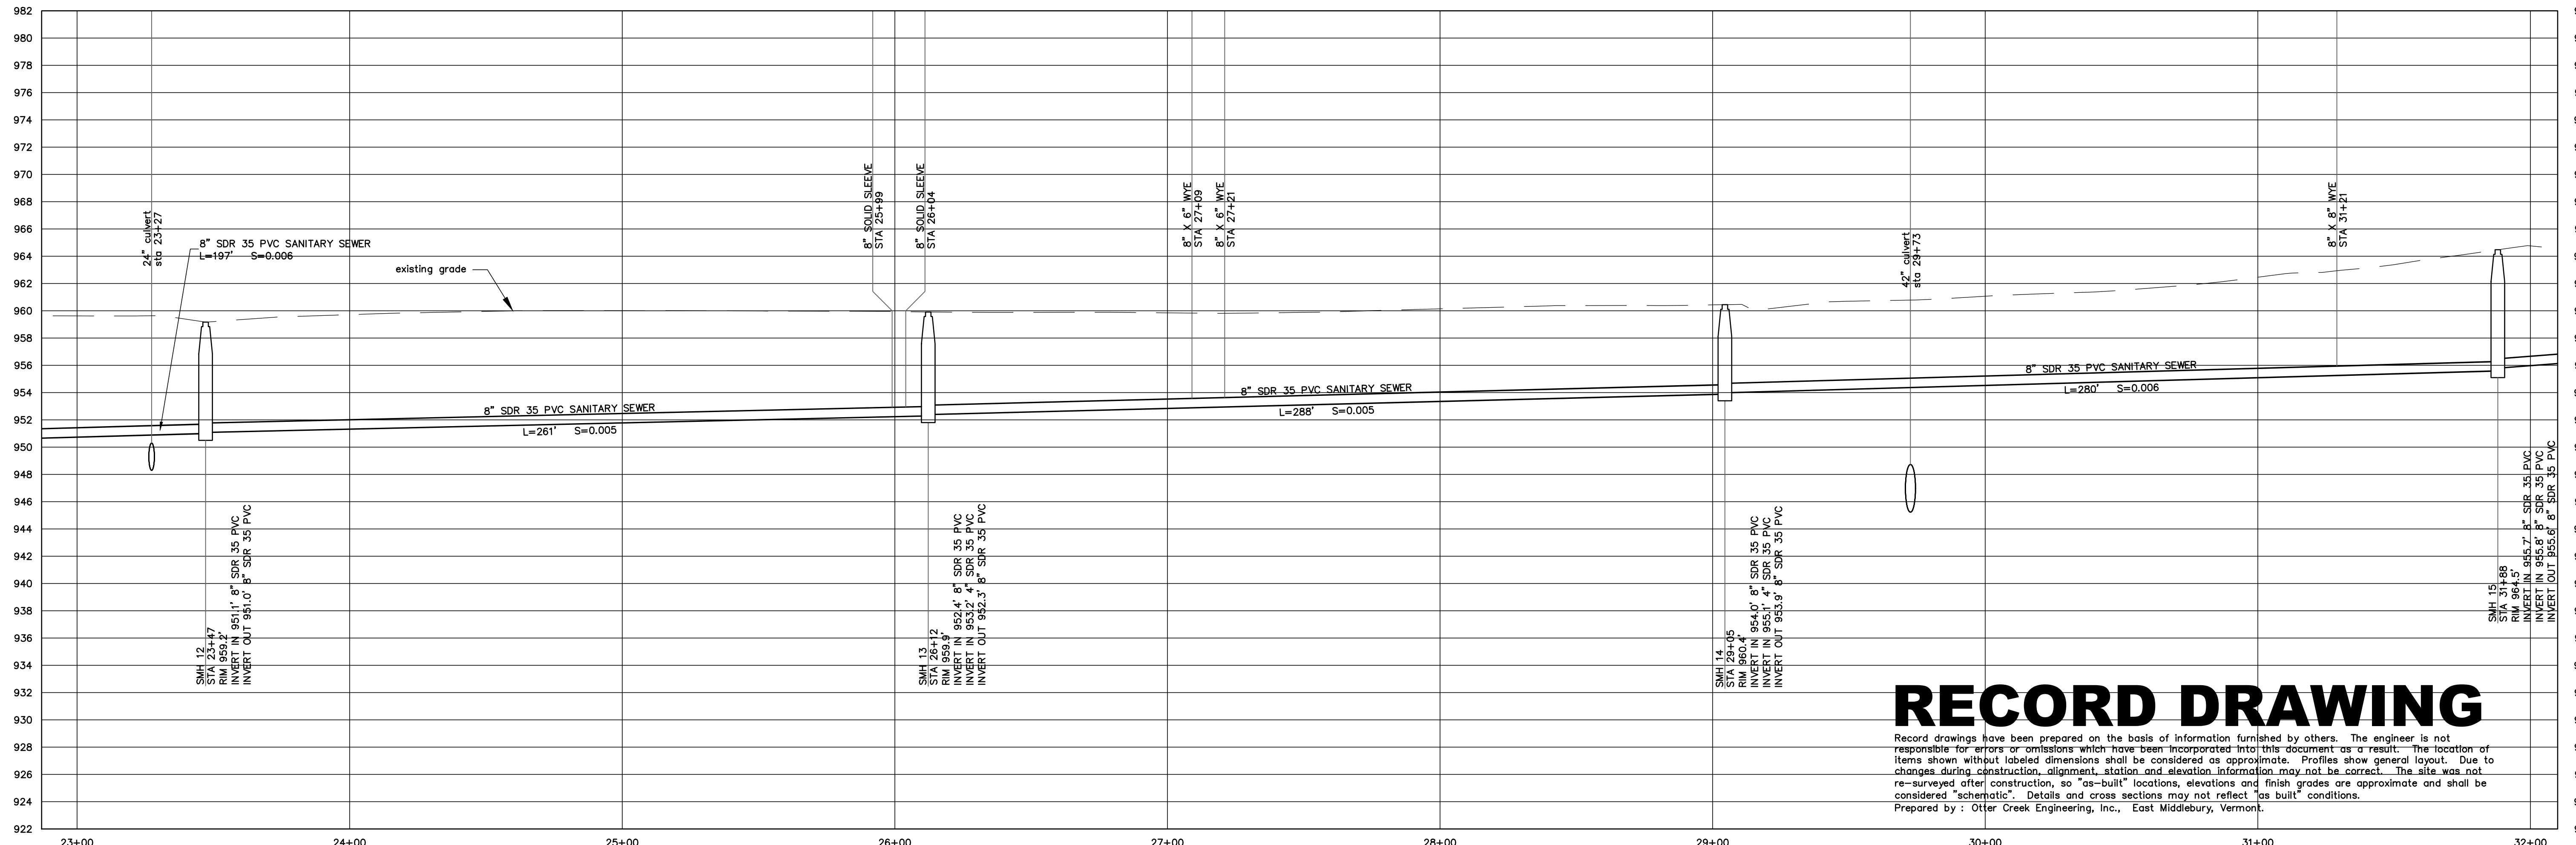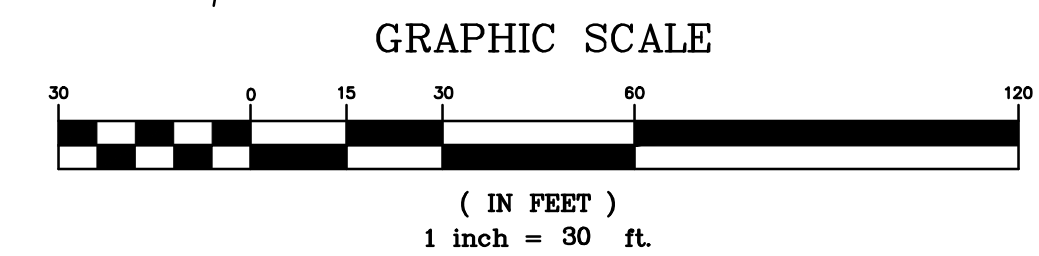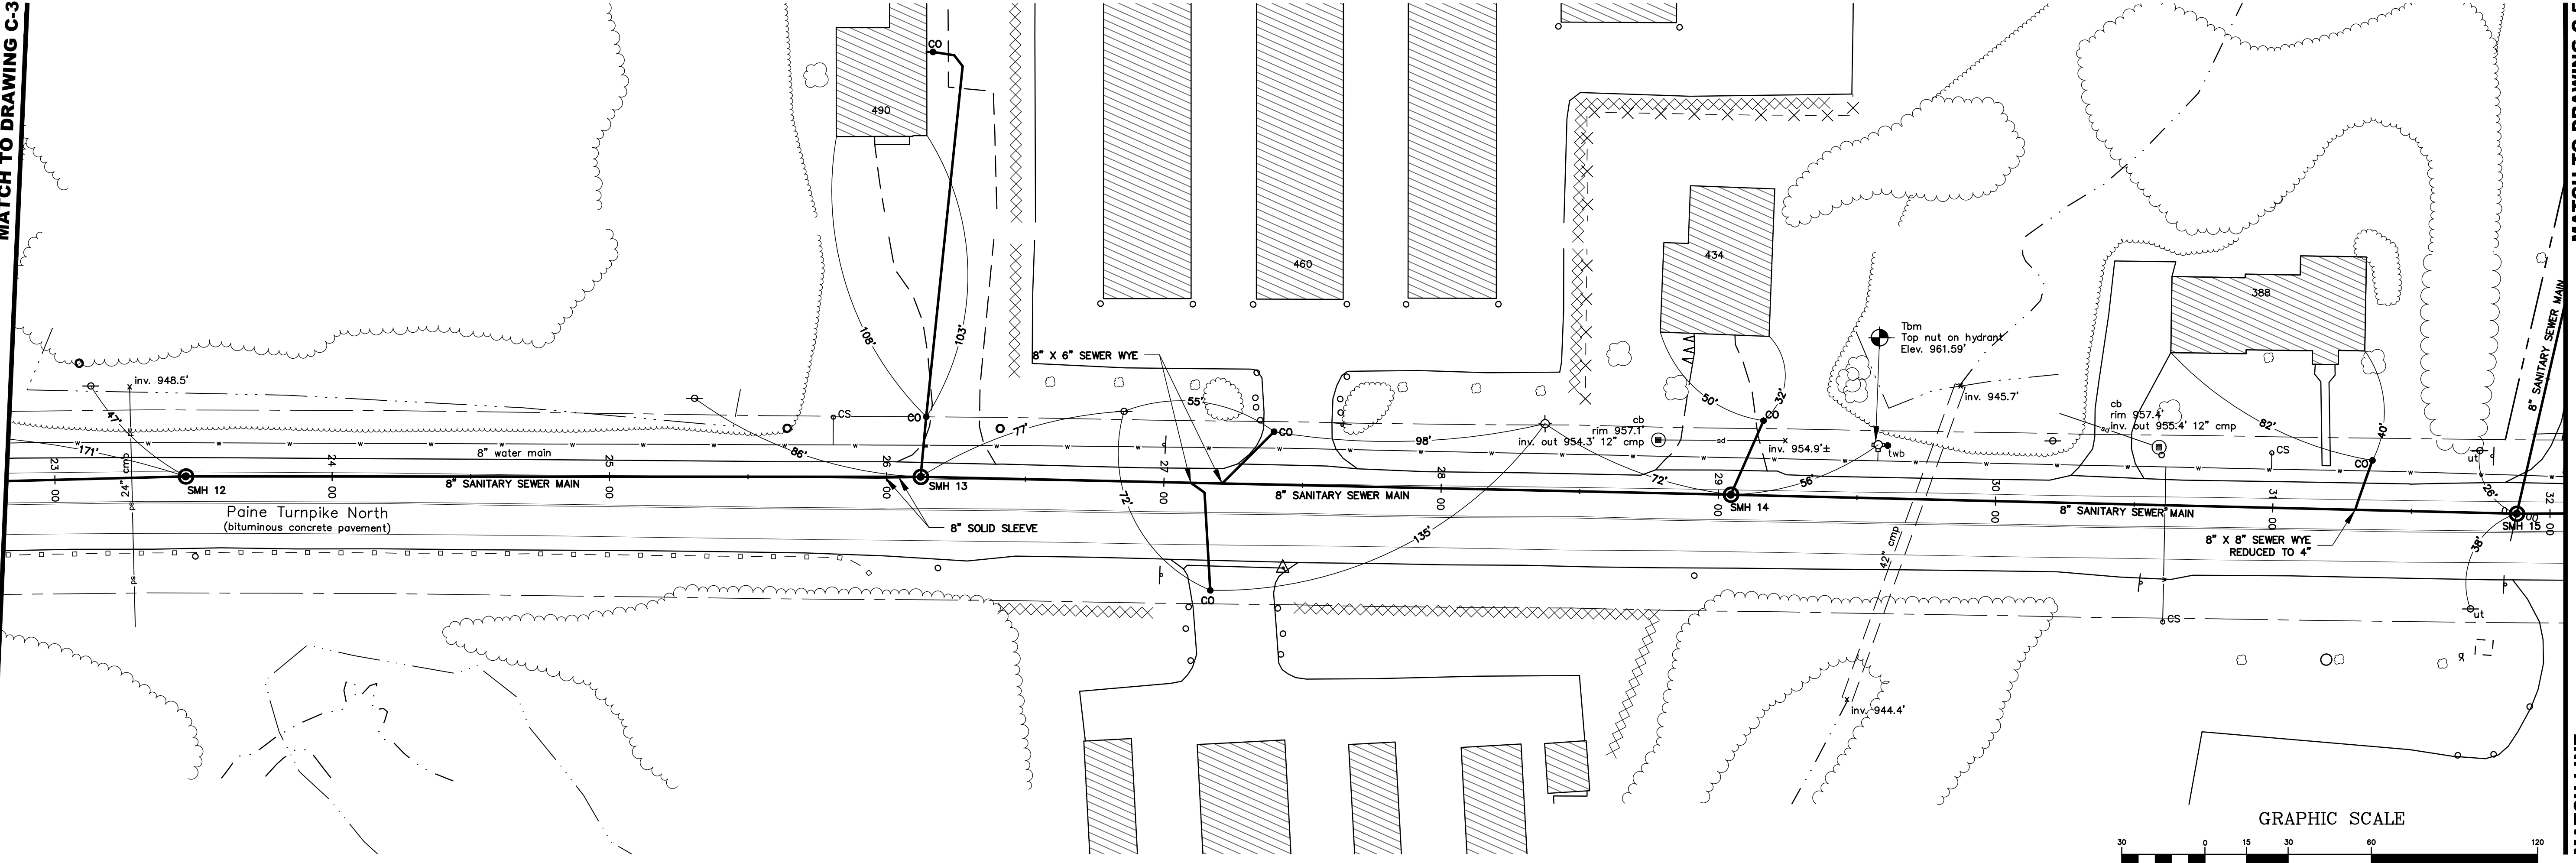

RECORD DRAWING


Record drawings have been prepared on the basis of information furnished by others. The engineer is not responsible for errors or omissions which have been incorporated into this document as a result. The location of items shown without labeled dimensions shall be considered as approximate. Profiles show general layout. Due to changes during construction, alignment, station and elevation information may not be correct. The site was not re-surveyed after construction, so "as-built" locations, elevations and finish grades are approximate and shall be considered "schematic". Details and cross sections may not reflect "as built" conditions.
Prepared by: Otter Creek Engineering, Inc., East Middlebury, Vermont.

OTTER CREEK ENGINEERING
 404 East Main Street
 P.O. Box 712
 East Middlebury, VT 05740
 Telephone: 802-382-8522
 Fax: 802-382-8640
 110 Merchants Row
 4th Floor, Suite 15
 Rutland, VT 05701
 Telephone: 802-747-3080
 Fax: 802-747-4820
 E-mail: info@ottercrk.com

STAMP AND SIGNATURE:

 DESIGN ENGINEER

THESE DRAWINGS SHALL NOT BE ALTERED IN ANY WAY WITHOUT THE WRITTEN APPROVAL OF THE ENGINEER. ANY REVISIONS SHALL BE MADE BY THE ENGINEER AND NOTED IN THE REVISION BLOCK. © 2021
 OTTER CREEK ENGINEERING, INC.

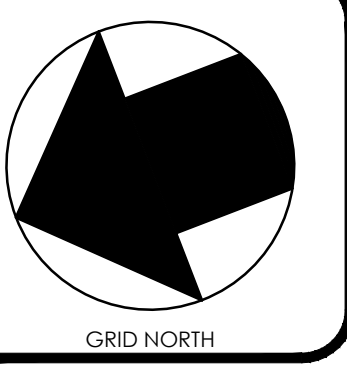

**TOWN OF BERLIN
 PAINE TURNPIKE NORTH
 WASTEWATER
 IMPROVEMENTS
 BERLIN, VERMONT**

RECORD
 DATE ISSUED: 6/30/2021
 REVISIONS:
 DRAWN BY: RR
 CHECKED BY: JK
 SCALE: 1"=30'
 PROJECT NO.: 519.005
 CADD FILE:
 TITLE: SITE PLAN AND PROFILE
 DRAWING NO.: **C-4**




MATCH LINE MATCH TO DRAWING C-7

MATCH LINE

RECORD DRAWING

Record drawings have been prepared on the basis of information furnished by others. The engineer is not responsible for errors or omissions which have been incorporated into this document as a result. The location of items shown without labeled dimensions shall be considered as approximate. Profiles show general layout. Due to changes during construction, alignment, station and elevation information may not be correct. The site was not re-surveyed after construction, so "as-built" locations, elevations and finish grades are approximate and shall be considered "schematic". Details and cross sections may not reflect "as built" conditions. Prepared by: Otter Creek Engineering, Inc., East Middlebury, Vermont.

OTTER CREEK ENGINEERING
 404 East Main Street
 P.O. Box 712
 East Middlebury, VT 05740
 Telephone: 802.382.8522
 Fax: 802.382.8440
 110 Merchants Row
 4th Floor, Suite 15
 Rutland, VT 05701
 Telephone: 802.747.3080
 Fax: 802.747.4820
 E-mail: info@ottercreek.com

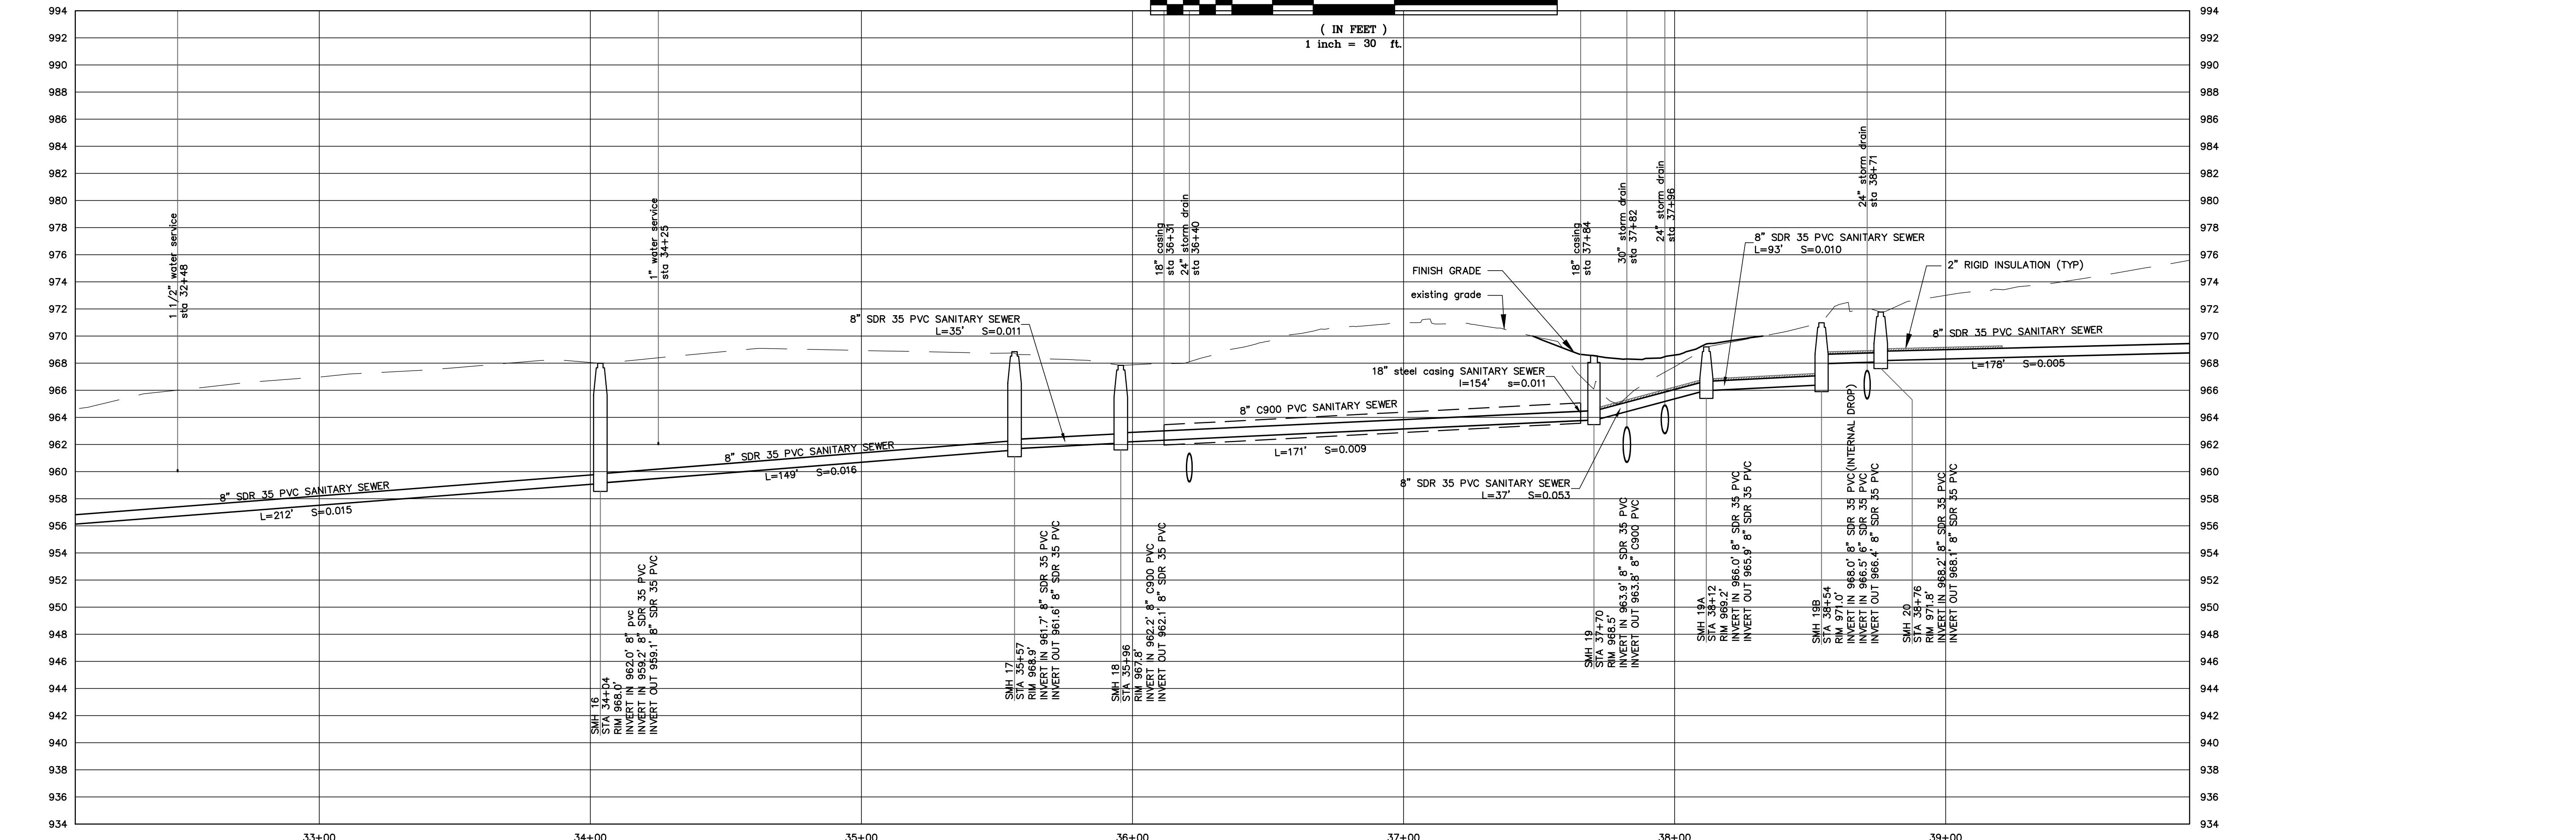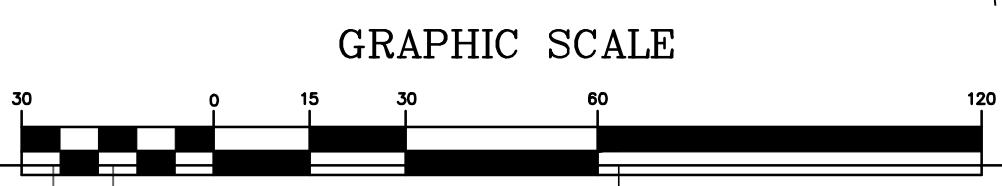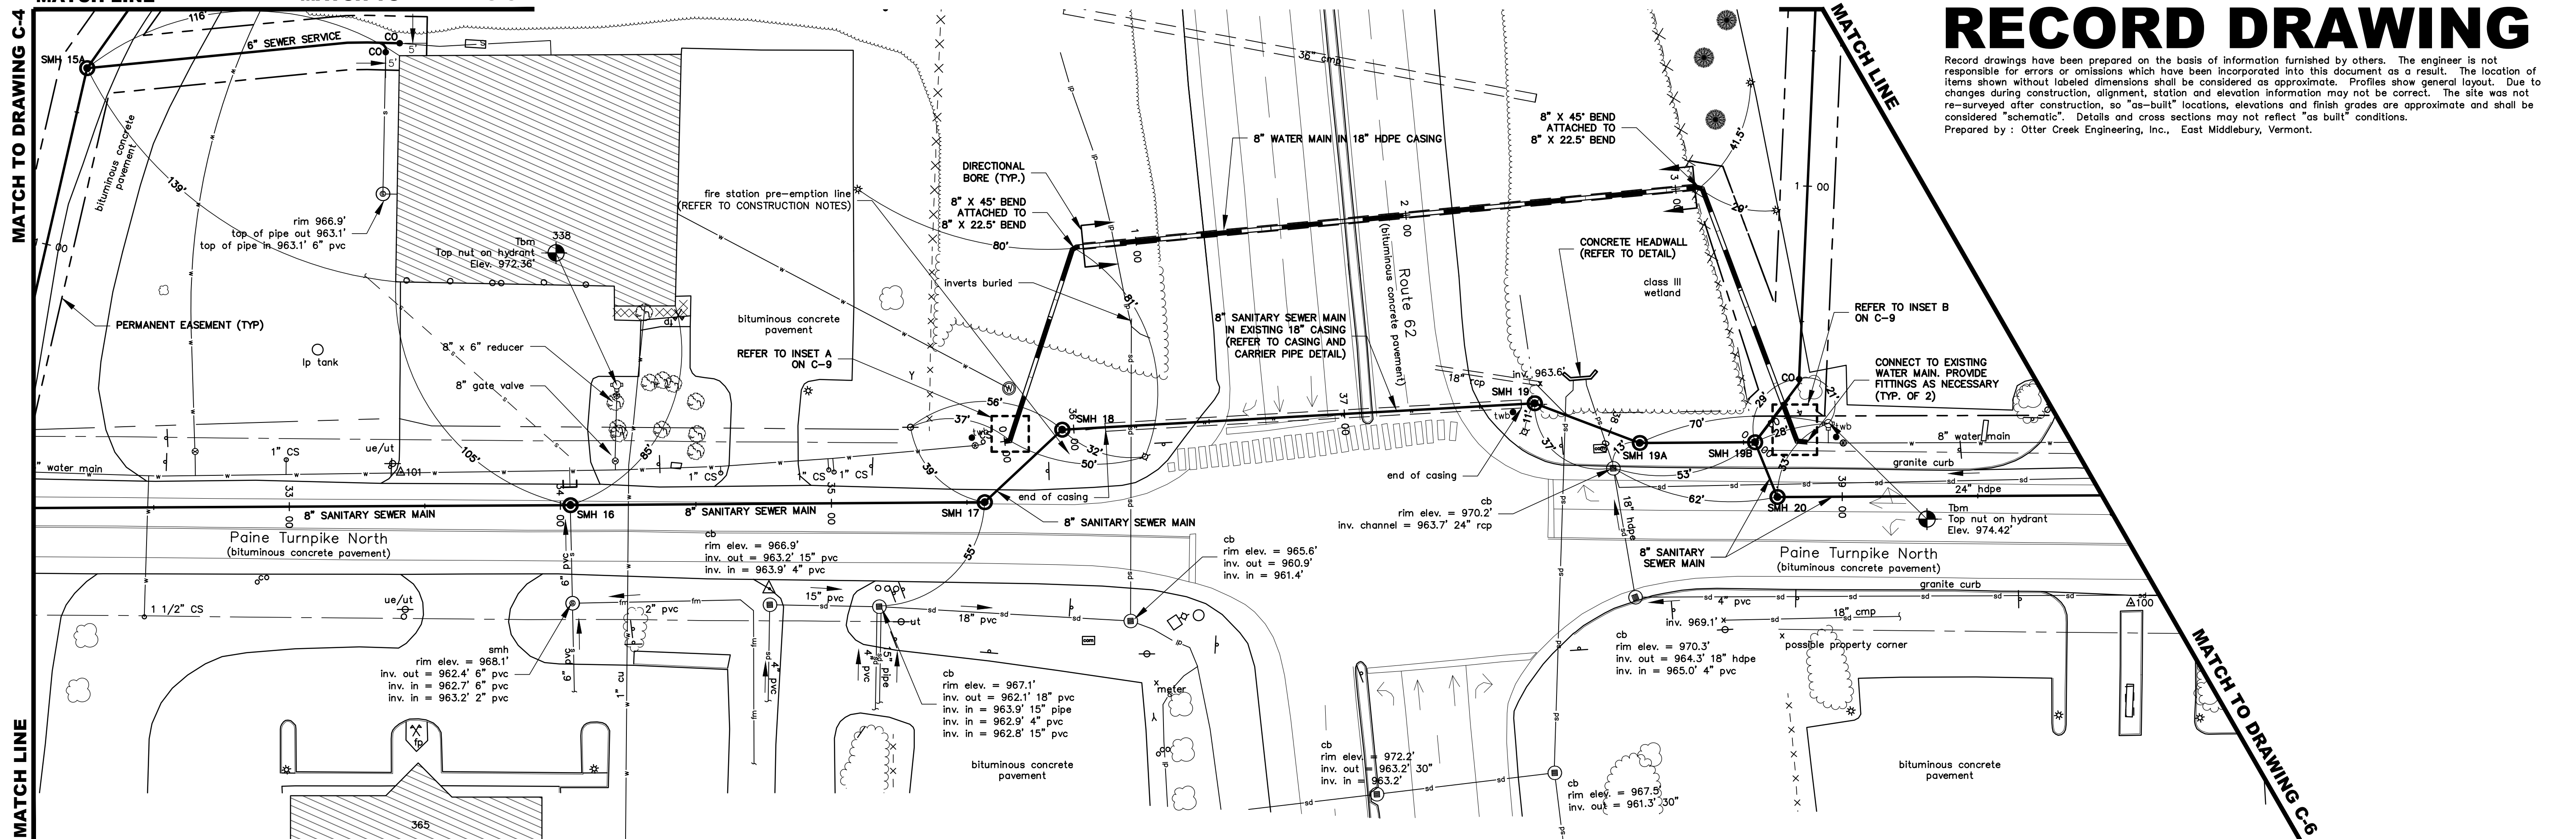


PAINE TURNPIKE NORTH SEWER MAIN PROFILE
 SCALE: 1" = 30' HORIZONTAL
 1" = 6' VERTICAL

STAMP AND SIGNATURE:

 DESIGN ENGINEER

THESE DRAWINGS SHALL NOT BE ALTERED IN ANY WAY WITHOUT THE WRITTEN APPROVAL OF THE ENGINEER. ANY REVISIONS SHALL BE MADE BY THE ENGINEER AND NOTED IN THE REVISION BLOCK. © 2021
 OTTER CREEK ENGINEERING, INC.

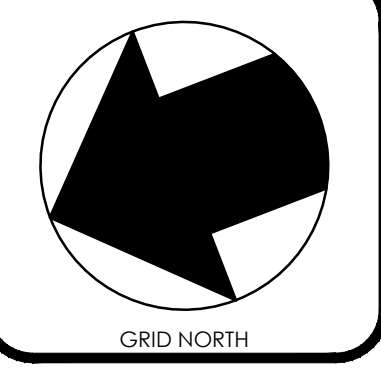

**TOWN OF BERLIN
 PAINE TURNPIKE NORTH
 WASTEWATER
 IMPROVEMENTS
 BERLIN, VERMONT**

RECORD
 DATE ISSUED: 6/30/2021
 REVISIONS:
 DRAWN BY: RR
 CHECKED BY: JK
 SCALE: 1"=30'
 PROJECT NO.: 519.005
 CADD FILE:
 TITLE:
 SITE PLAN AND PROFILE

DRAWING NO.
C-5




OTTER CREEK
ENGINEERING

404 East Main Street
P.O. Box 712
East Middlebury, VT 05740
Telephone: 802.382.8522
Fax: 802.382.8440

110 Merchants Row
4th Floor, Suite 15
Rutland, VT 05701
Telephone: 802.747.3080
Fax: 802.747.4820
E-mail: info@ottercreek.com


STAMP AND SIGNATURE:

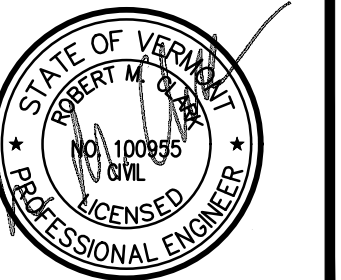

DESIGN ENGINEER

THESE DRAWINGS SHALL NOT
BE ALTERED IN ANY WAY
WITHOUT THE WRITTEN
APPROVAL OF THE ENGINEER.
ANY REVISIONS SHALL BE
MADE BY THE ENGINEER AND
NOTED IN THE REVISION
BLOCK. © 2021

OTTER CREEK ENGINEERING, INC.

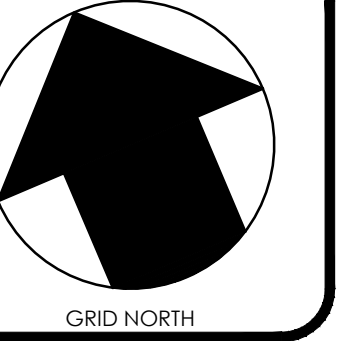

TOWN OF BERLIN
PAINE TURNPIKE NORTH
WASTEWATER
IMPROVEMENTS
BERLIN, VERMONT

RECORD

DATE ISSUED: 6/30/2021

REVISIONS:

DRAWN BY: RR

CHECKED BY: JK

SCALE: 1"=30'

PROJECT NO.: 519.005

CADD FILE: 519-005



TITLE:

SITE PLAN AND
PROFILE



DRAWING NO.

C-6

"SHAW'S" PUMP STATION MATCH LINE

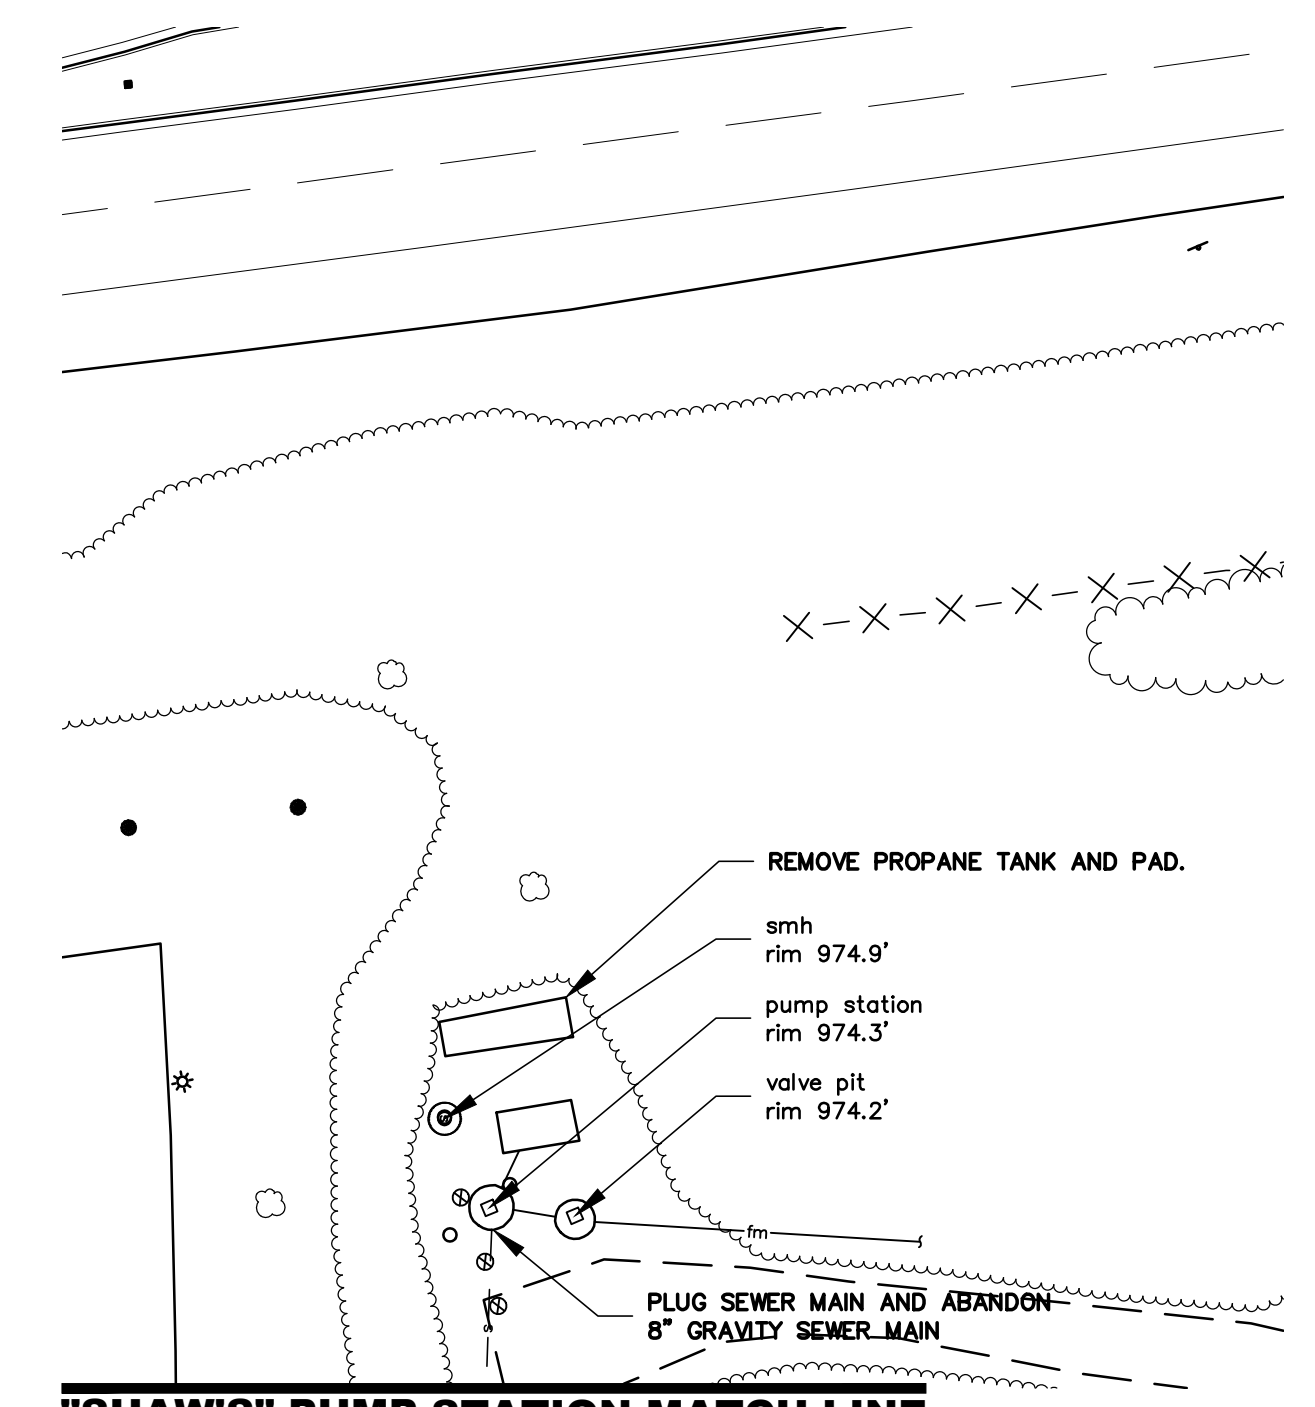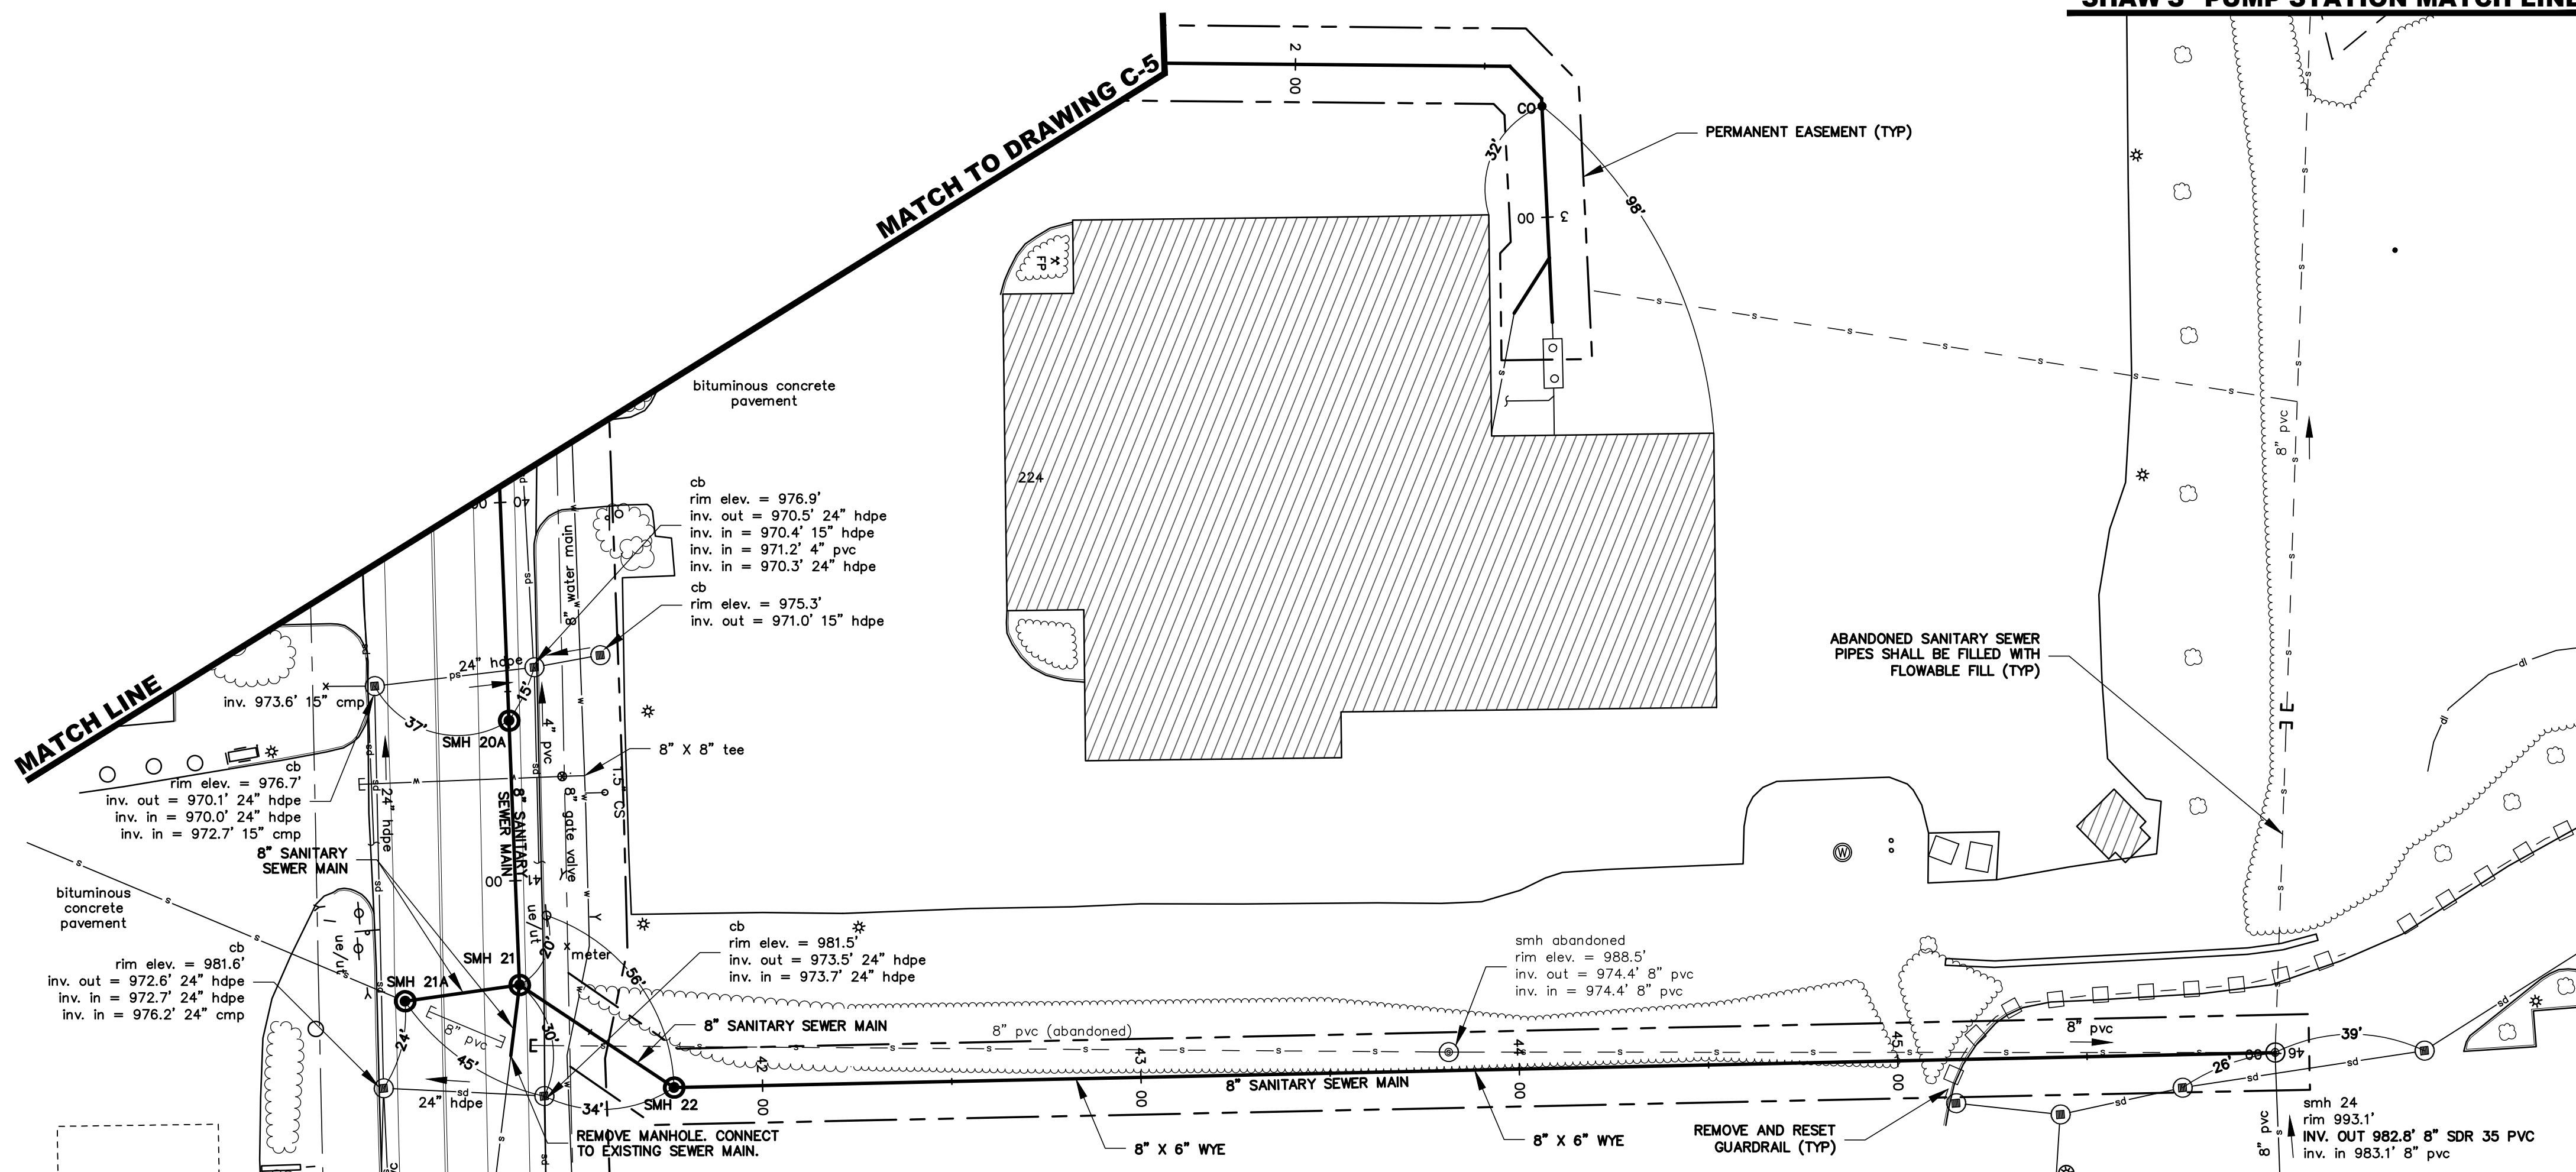

NOTE:
CONTRACTOR TO RETURN HOMA PUMPS AND
GENERATOR TO TOWN OF BERLIN PUBLIC WORKS.

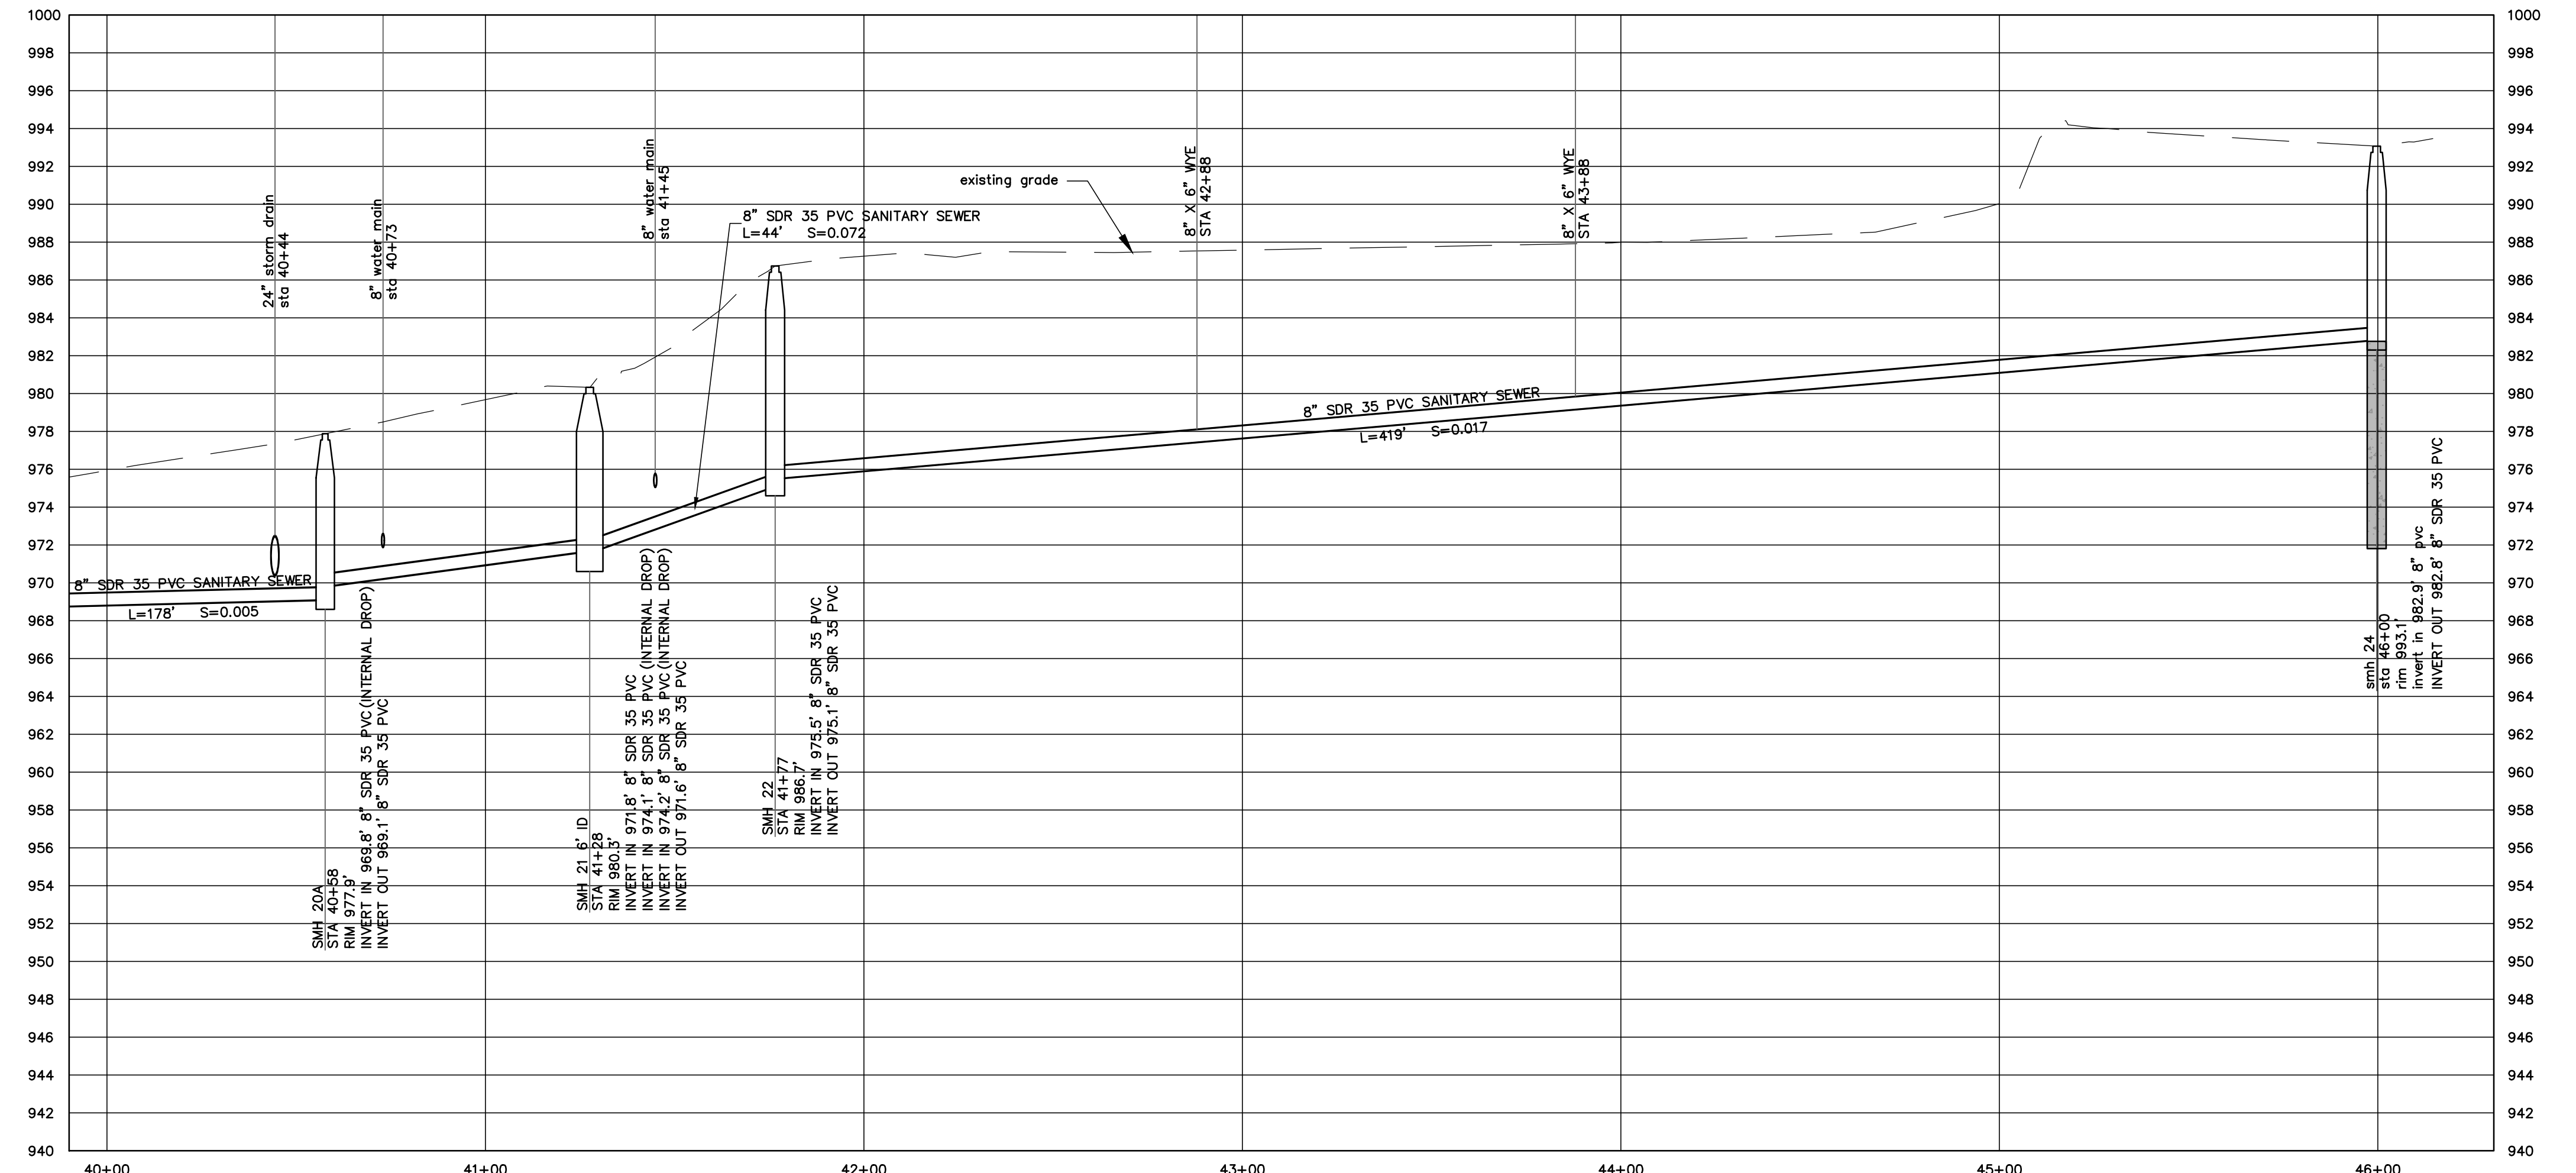
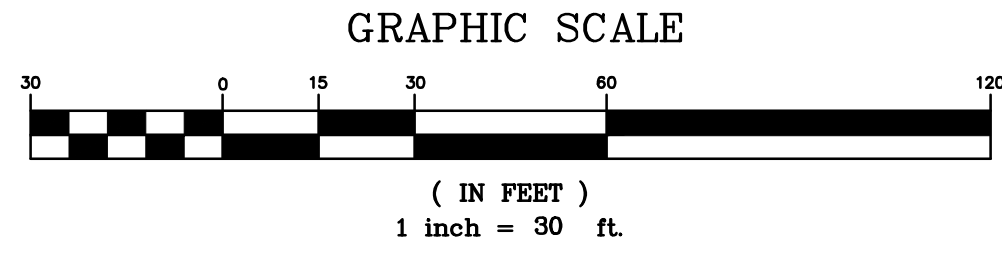


PAINE TURNPIKE NORTH SEWER MAIN PROFILE

SCALE: 1" = 30' HORIZONTAL
1" = 6' VERTICAL

RECORD DRAWING



Record drawings have been prepared on the basis of information furnished by others. The engineer is not responsible for errors or omissions which have been incorporated into this document as a result. The location of items shown without labeled dimensions shall be considered as approximate. Profiles show general layout. Due to changes during construction, alignment, station and elevation information may not be correct. The site was not re-surveyed after construction, so "as-built" locations, elevations and finish grades are approximate and shall be considered "schematic". Details and cross sections may not reflect "as built" conditions.
Prepared by: Otter Creek Engineering, Inc., East Middlebury, Vermont.

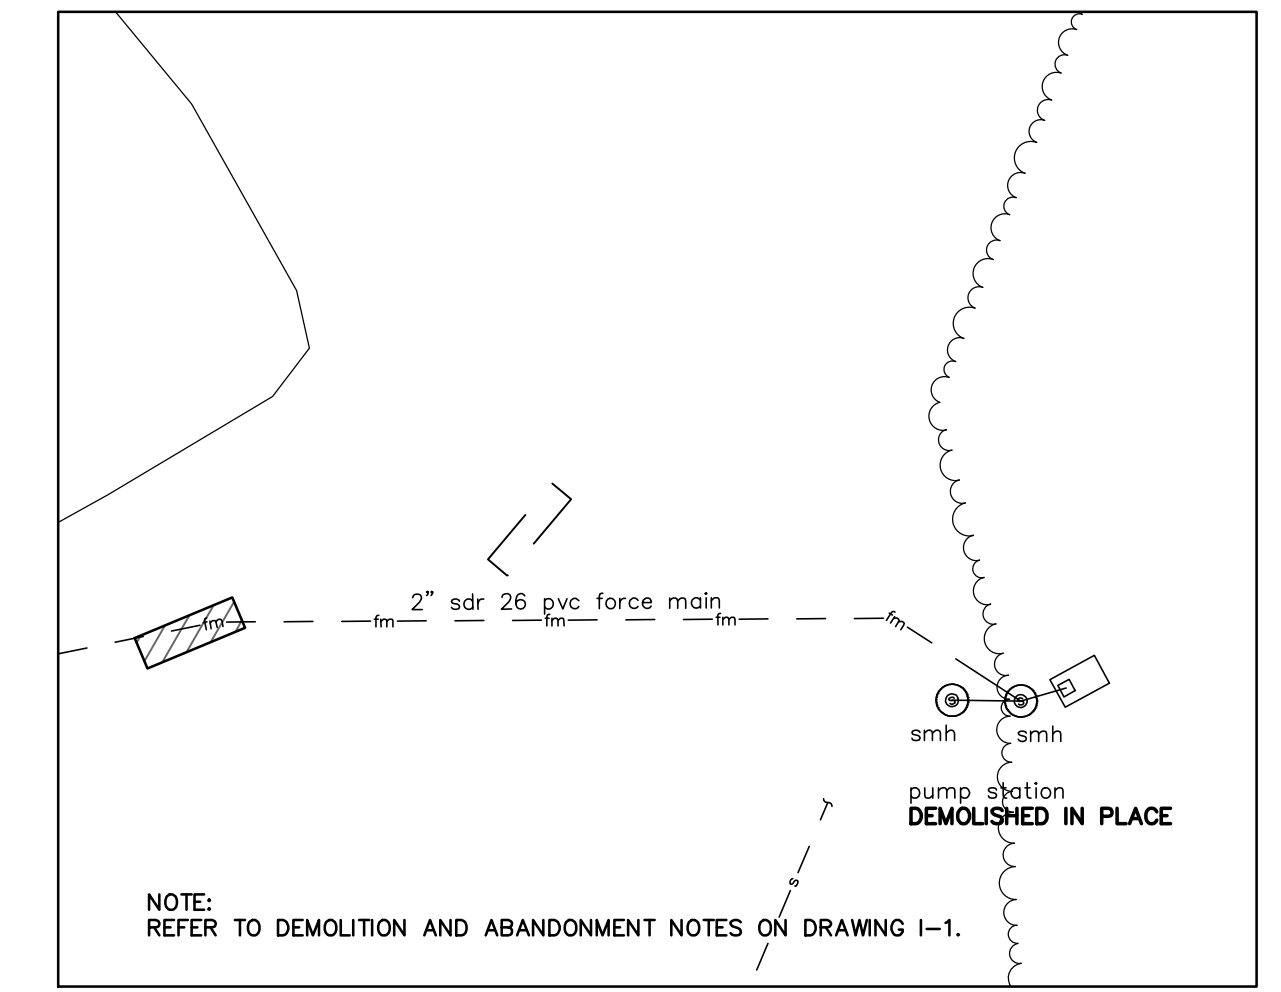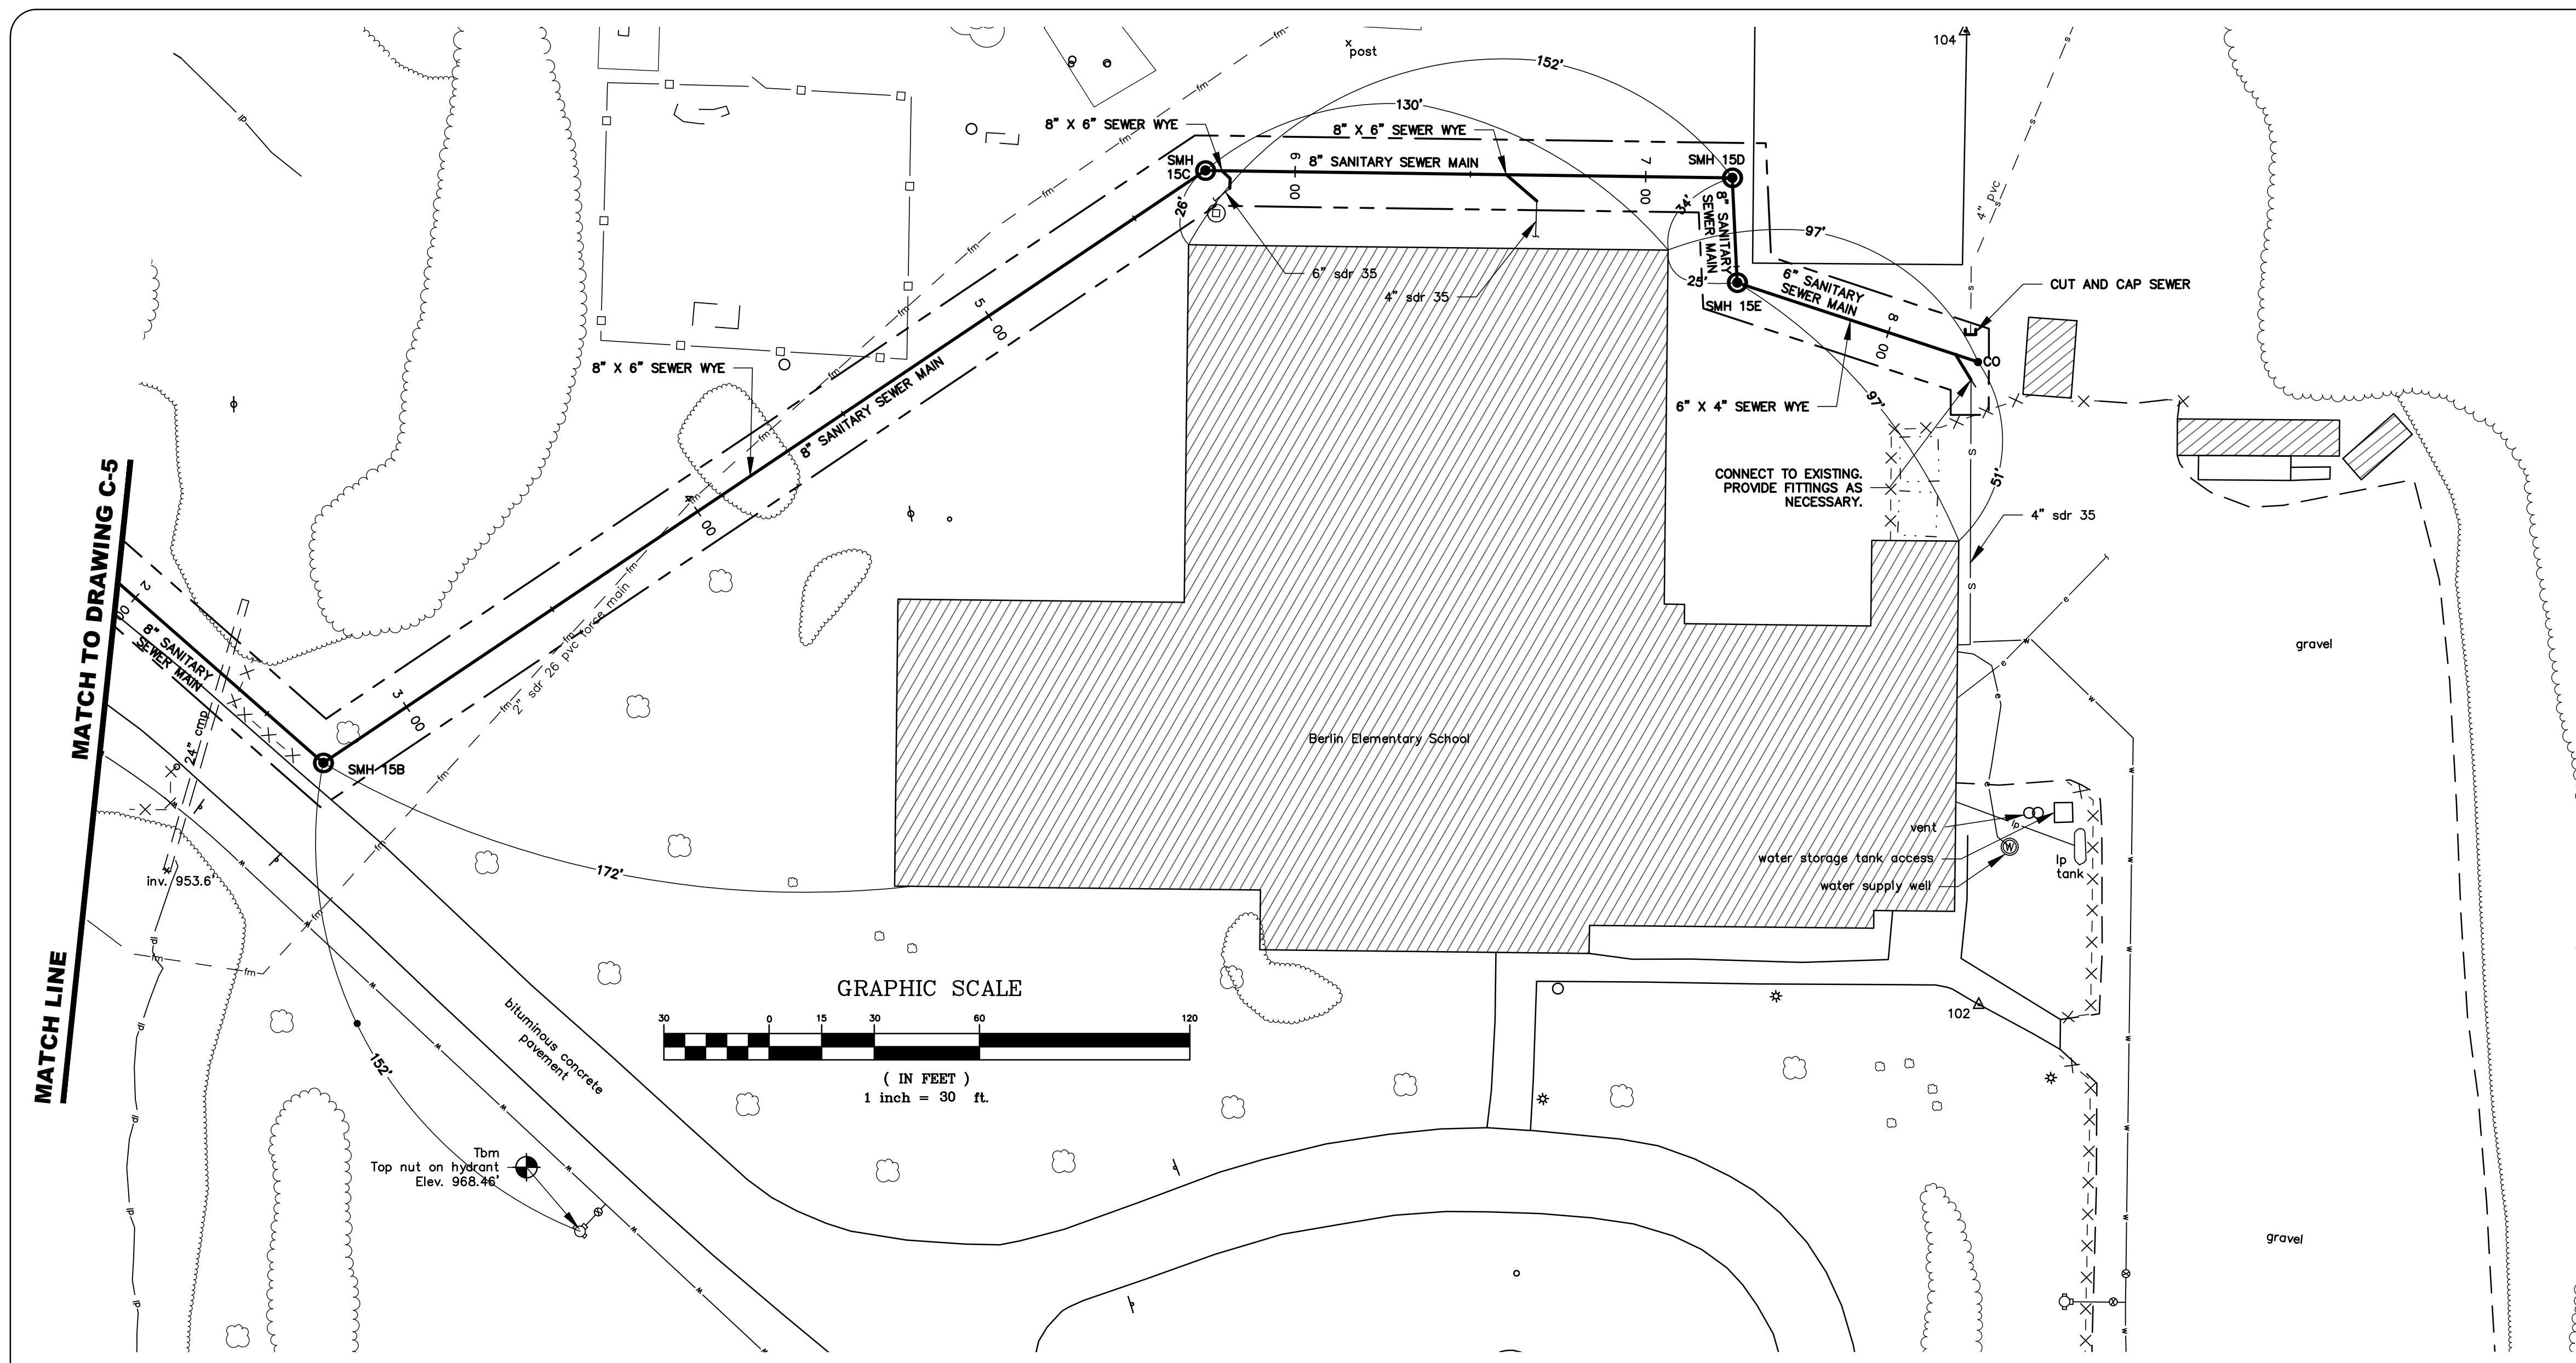

BERLIN ELEMENTARY SCHOOL PUMP STATION INSET
SCALE: 1" = 30'


RECORD DRAWING

Record drawings have been prepared on the basis of information furnished by others. The engineer is not responsible for errors or omissions which have been incorporated into this document as a result. The location of items shown without labeled dimensions shall be considered as approximate. Profiles show general layout. Due to changes during construction, alignment, station and elevation information may not be correct. The site was not re-surveyed after construction, so "as-built" locations, elevations and finish grades are approximate and shall be considered "schematic". Details and cross sections may not reflect "as built" conditions.
Prepared by: Otter Creek Engineering, Inc., East Middlebury, Vermont.

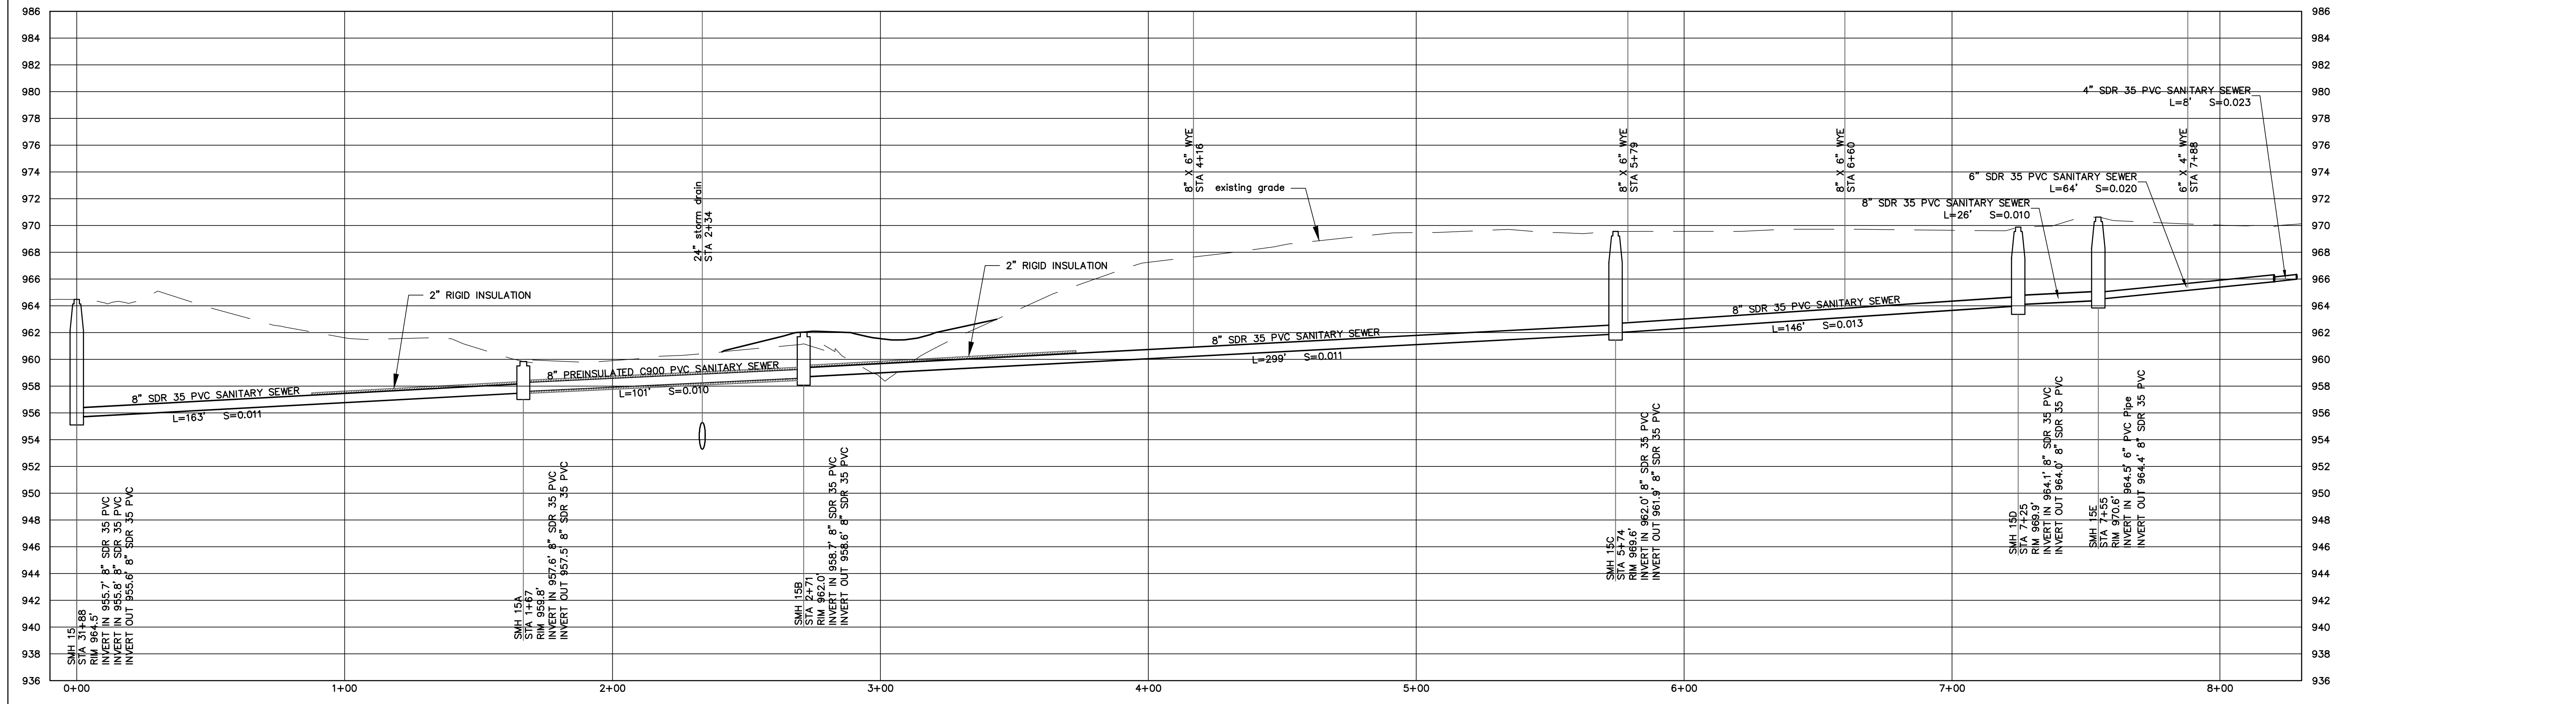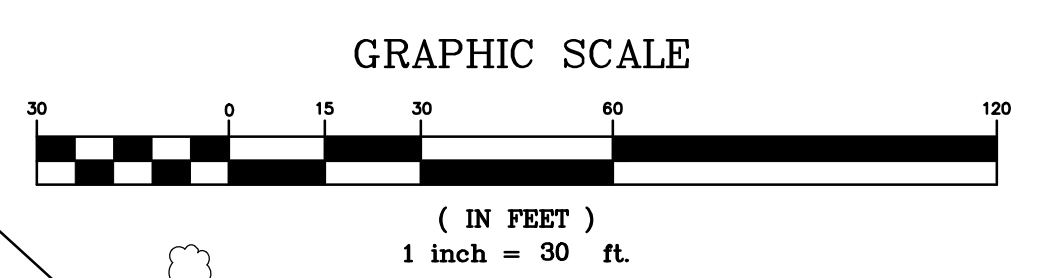


BERLIN ELEMENTARY SCHOOL SEWER PROFILE
HORIZ. 1" = 30'
VERT. 1" = 6'

OTTER CREEK ENGINEERING
404 East Main Street
P.O. Box 712
East Middlebury, VT 05740
Telephone: 802.382.8522
Fax: 802.382.8440
110 Merchants Row
4th Floor, Suite 15
Rutland, VT 05701
Telephone: 802.747.3080
Fax: 802.747.4820
E-mail: info@ottercreek.com

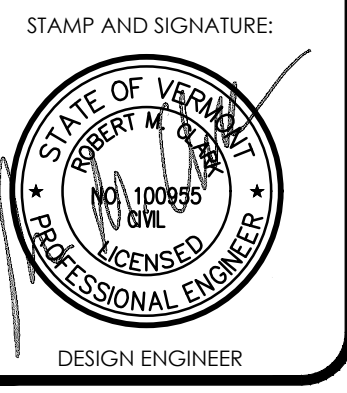

DESIGN ENGINEER
THESE DRAWINGS SHALL NOT BE ALTERED IN ANY WAY WITHOUT THE WRITTEN APPROVAL OF THE ENGINEER. ANY REVISIONS SHALL BE MADE BY THE ENGINEER AND NOTED IN THE REVISION BLOCK. © 2021
OTTER CREEK ENGINEERING, INC.

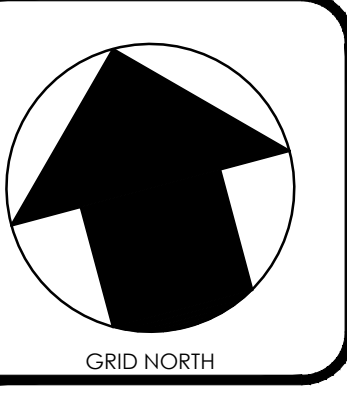

TOWN OF BERLIN
PAINÉ TURNPIKE NORTH WASTEWATER IMPROVEMENTS
BERLIN, VERMONT

RECORD
DATE ISSUED: 6/30/2021
REVISIONS:
DRAWN BY: RR
CHECKED BY: JK
SCALE: 1"=30'
PROJECT NO.: 519.005
CADD FILE: 519-005
TITLE: **SITE PLAN AND PROFILE**

DRAWING NO. **C-7**




OTTER CREEK ENGINEERING

404 East Main Street
P.O. Box 712
East Middlebury, VT 05740
Telephone: 802.382.8522
Fax: 802.382.8640

110 Merchants Row
4th Floor, Suite 15
Rutland, VT 05701
Telephone: 802.747.3080
Fax: 802.747.4820
E-mail: info@ottercreek.com


STAMP AND SIGNATURE:

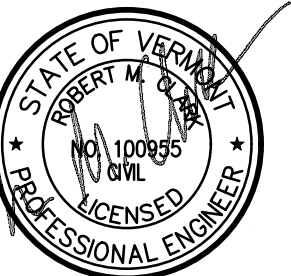

DESIGN ENGINEER

THESE DRAWINGS SHALL NOT BE ALTERED IN ANY WAY WITHOUT THE WRITTEN APPROVAL OF THE ENGINEER. ANY REVISIONS SHALL BE MADE BY THE ENGINEER AND NOTED IN THE REVISION BLOCK. © 2021

OTTER CREEK ENGINEERING, INC.

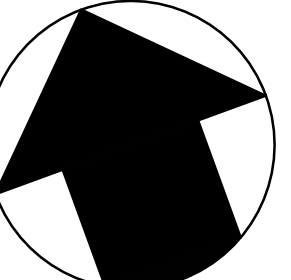

GRID NORTH

TOWN OF BERLIN
PAINÉ TURNPIKE NORTH
WASTEWATER
IMPROVEMENTS
BERLIN, VERMONT

RECORD

DATE ISSUED: 6/30/2021

REVISIONS:

DRAWN BY: RR

CHECKED BY: JK

SCALE: 1"=30'

PROJECT NO.: 519.005



CADD FILE: 519-005

TITLE:

SITE PLAN AND
PROFILE

DRAWING NO.

C-8

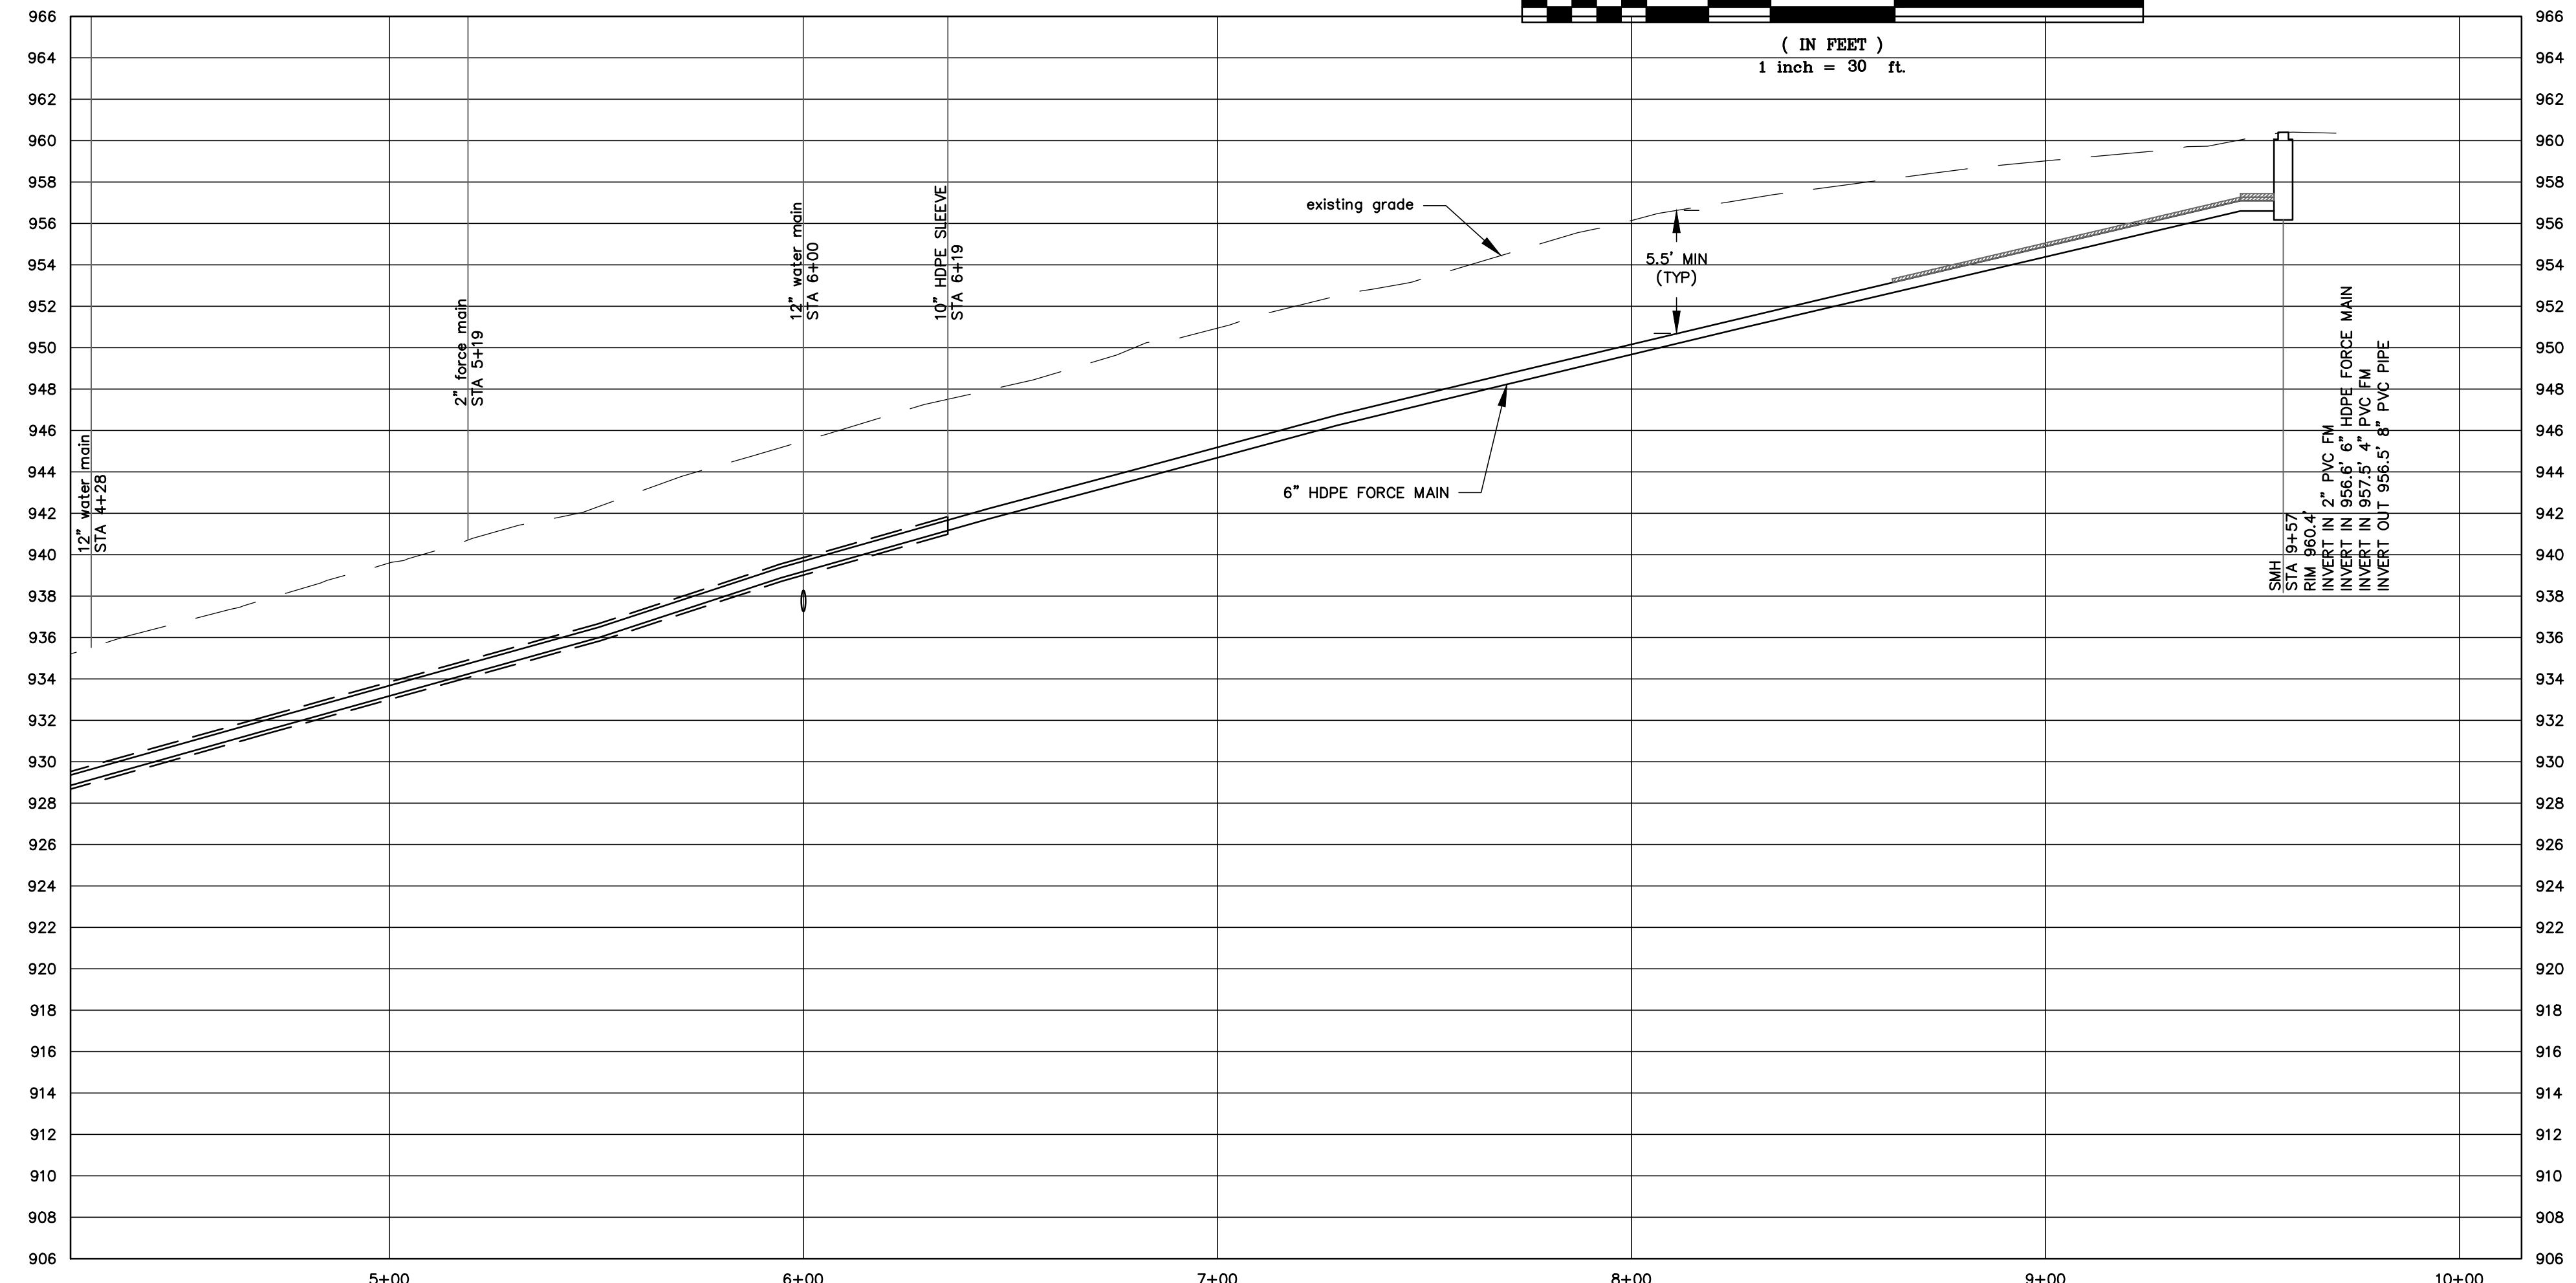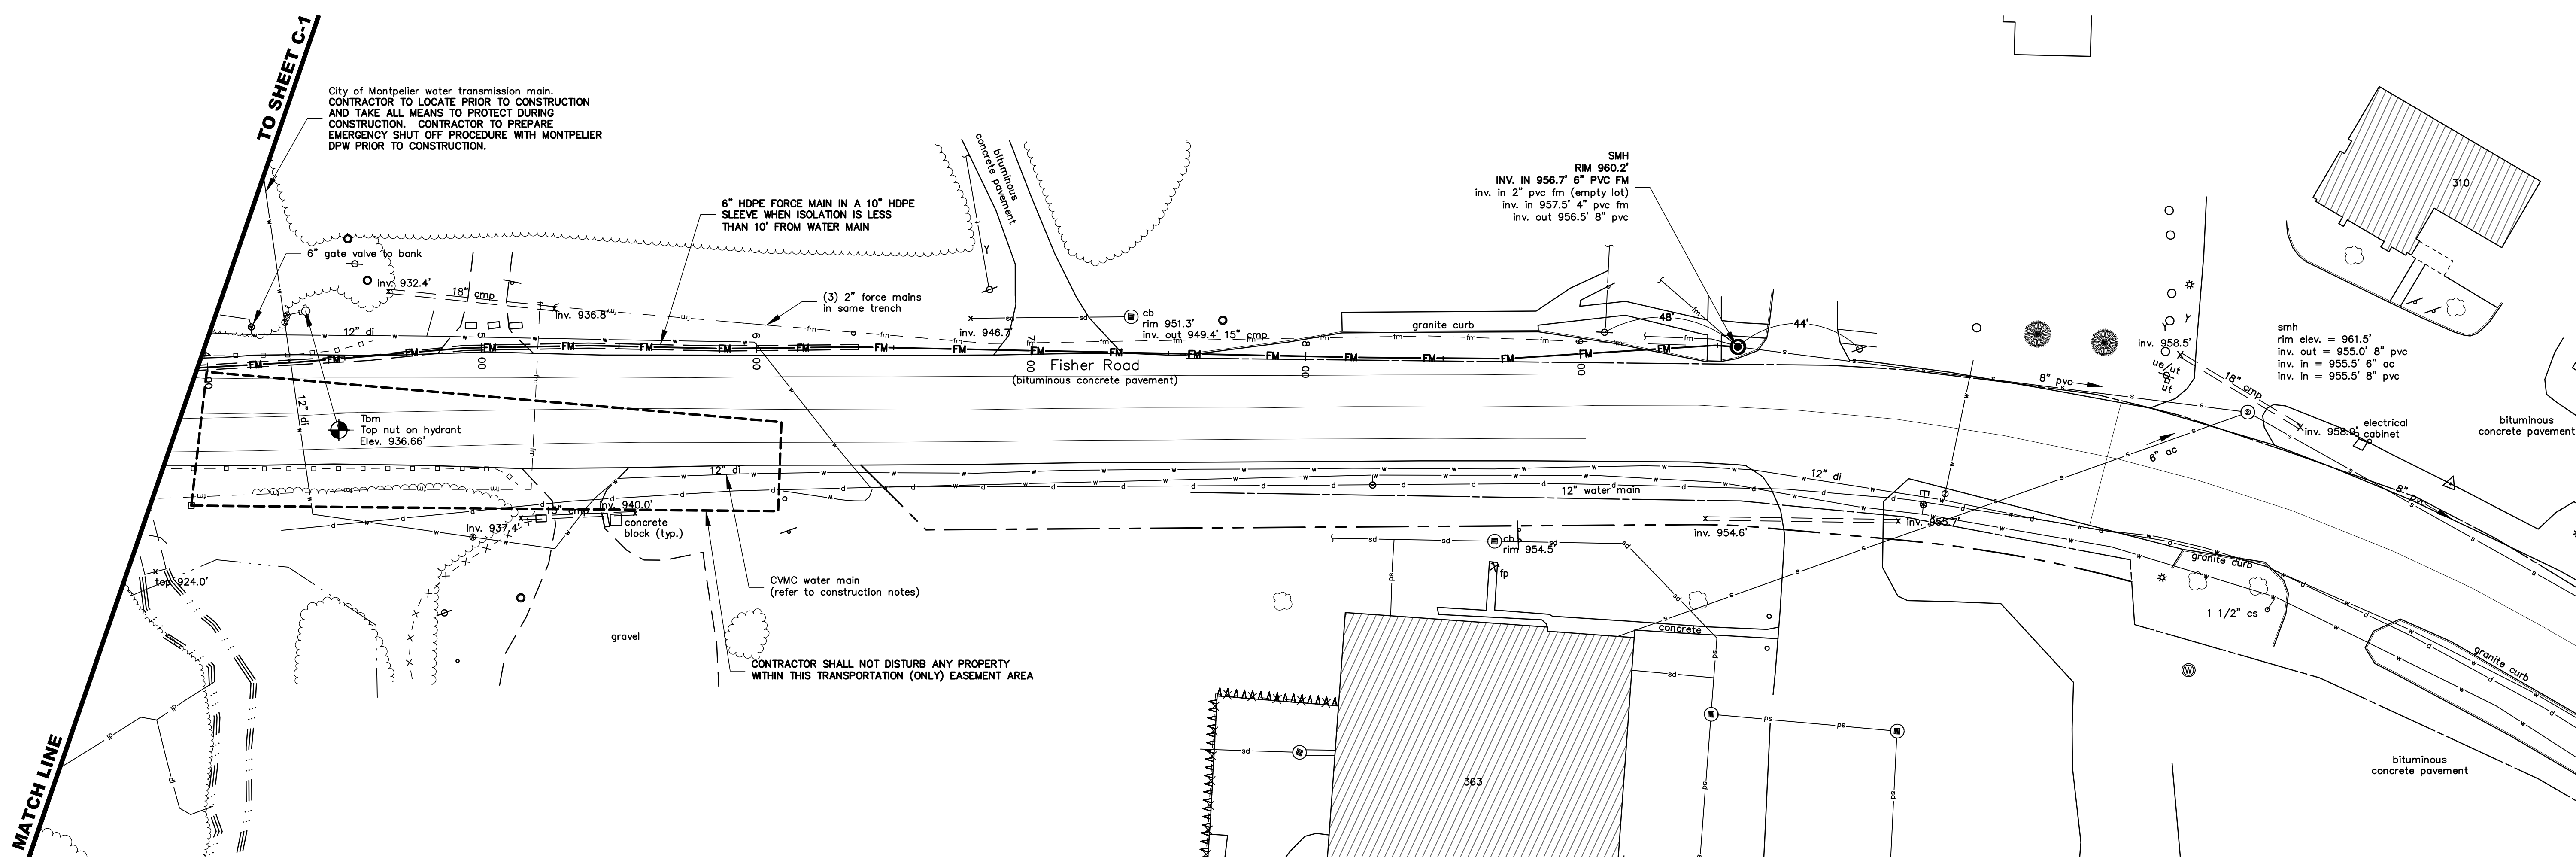

SEWER FORCE MAIN PROFILE
SCALE: 1" = 30' HORIZONTAL
1" = 6' VERTICAL


RECORD DRAWING

Record drawings have been prepared on the basis of information furnished by others. The engineer is not responsible for errors or omissions which have been incorporated into this document as a result. The location of items shown without labeled dimensions shall be considered as approximate. Profiles show general layout. Due to changes during construction, alignment, station and elevation information may not be correct. The site was not re-surveyed after construction, so "as-built" locations, elevations and finish grades are approximate and shall be considered "schematic". Details and cross sections may not reflect "as built" conditions.
Prepared by : Otter Creek Engineering, Inc., East Middlebury, Vermont.


RECORD DRAWING

Record drawings have been prepared on the basis of information furnished by others. The engineer is not responsible for errors or omissions which have been incorporated into this document as a result. The location of items shown without labeled dimensions shall be considered as approximate. Profiles show general layout. Due to changes during construction, alignment, station and elevation information may not be correct. The site was not re-surveyed after construction, so "as-built" locations, elevations and finish grades are approximate and shall be considered "schematic". Details and cross sections may not reflect "as built" conditions.


Prepared by: Otter Creek Engineering, Inc., East Middlebury, Vermont.

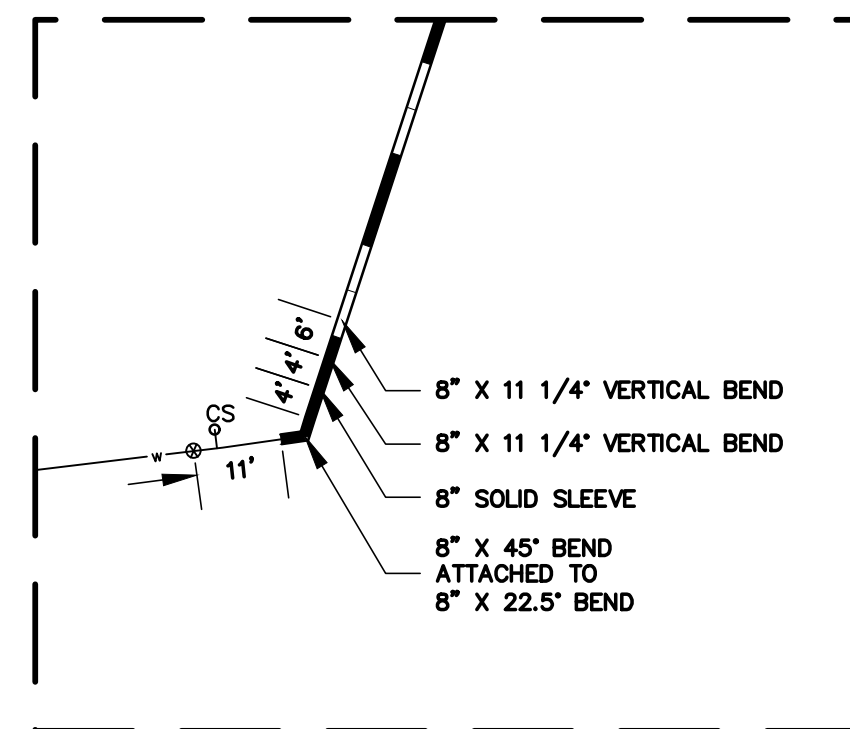

INSET A
NOT TO SCALE

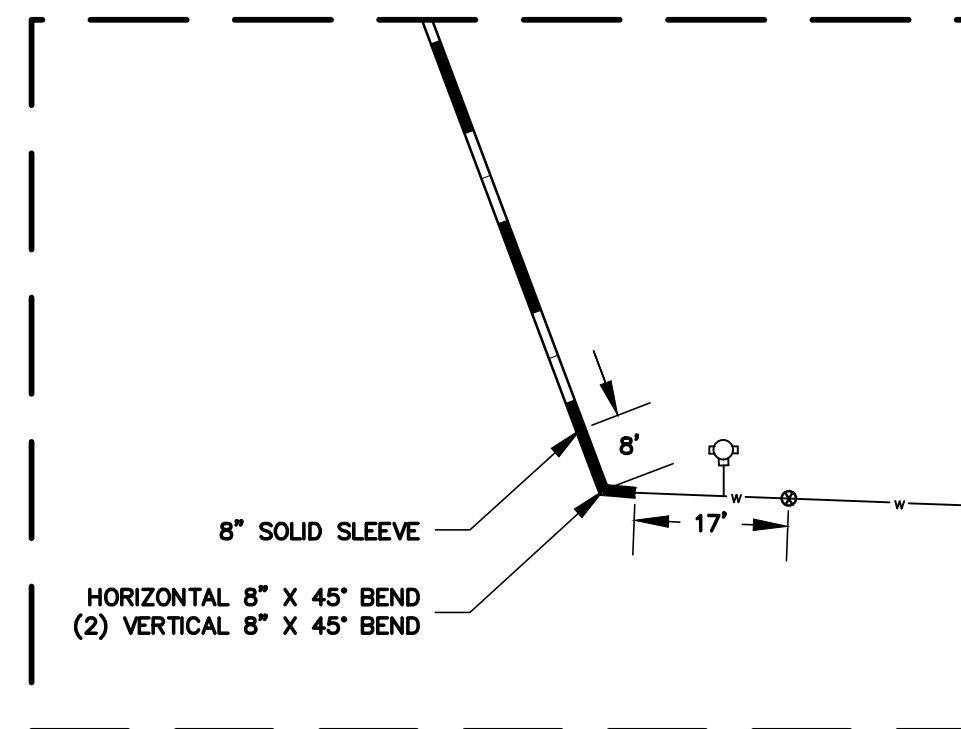


INSET B
NOT TO SCALE

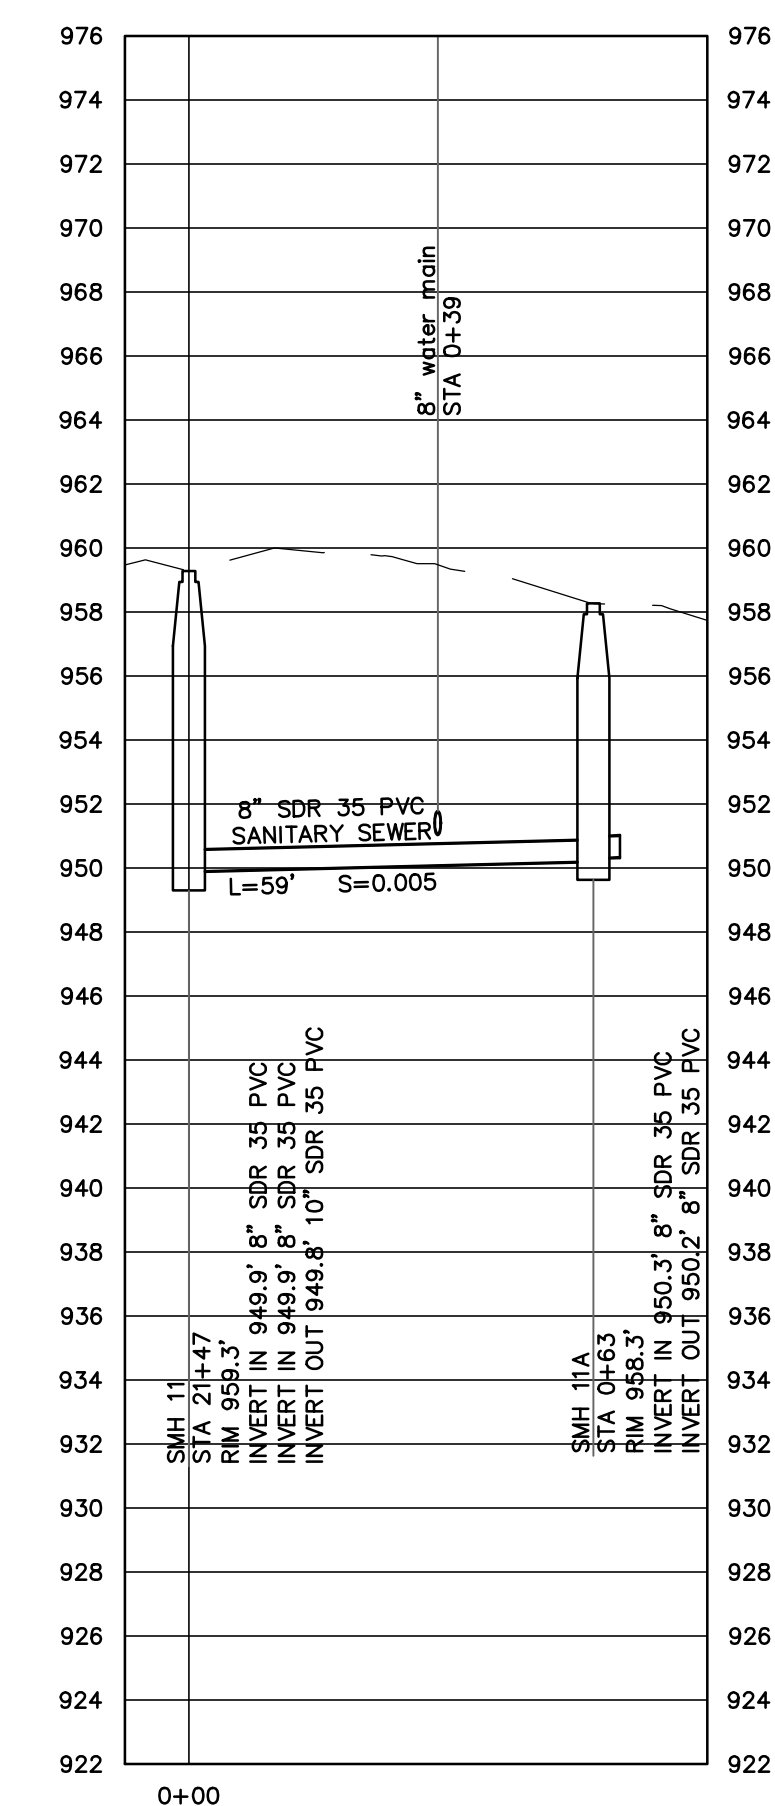


RICHARDSON ROAD SEWER MAIN PROFILE

HORIZ. 1" = 30'
VERT. 1" = 6'

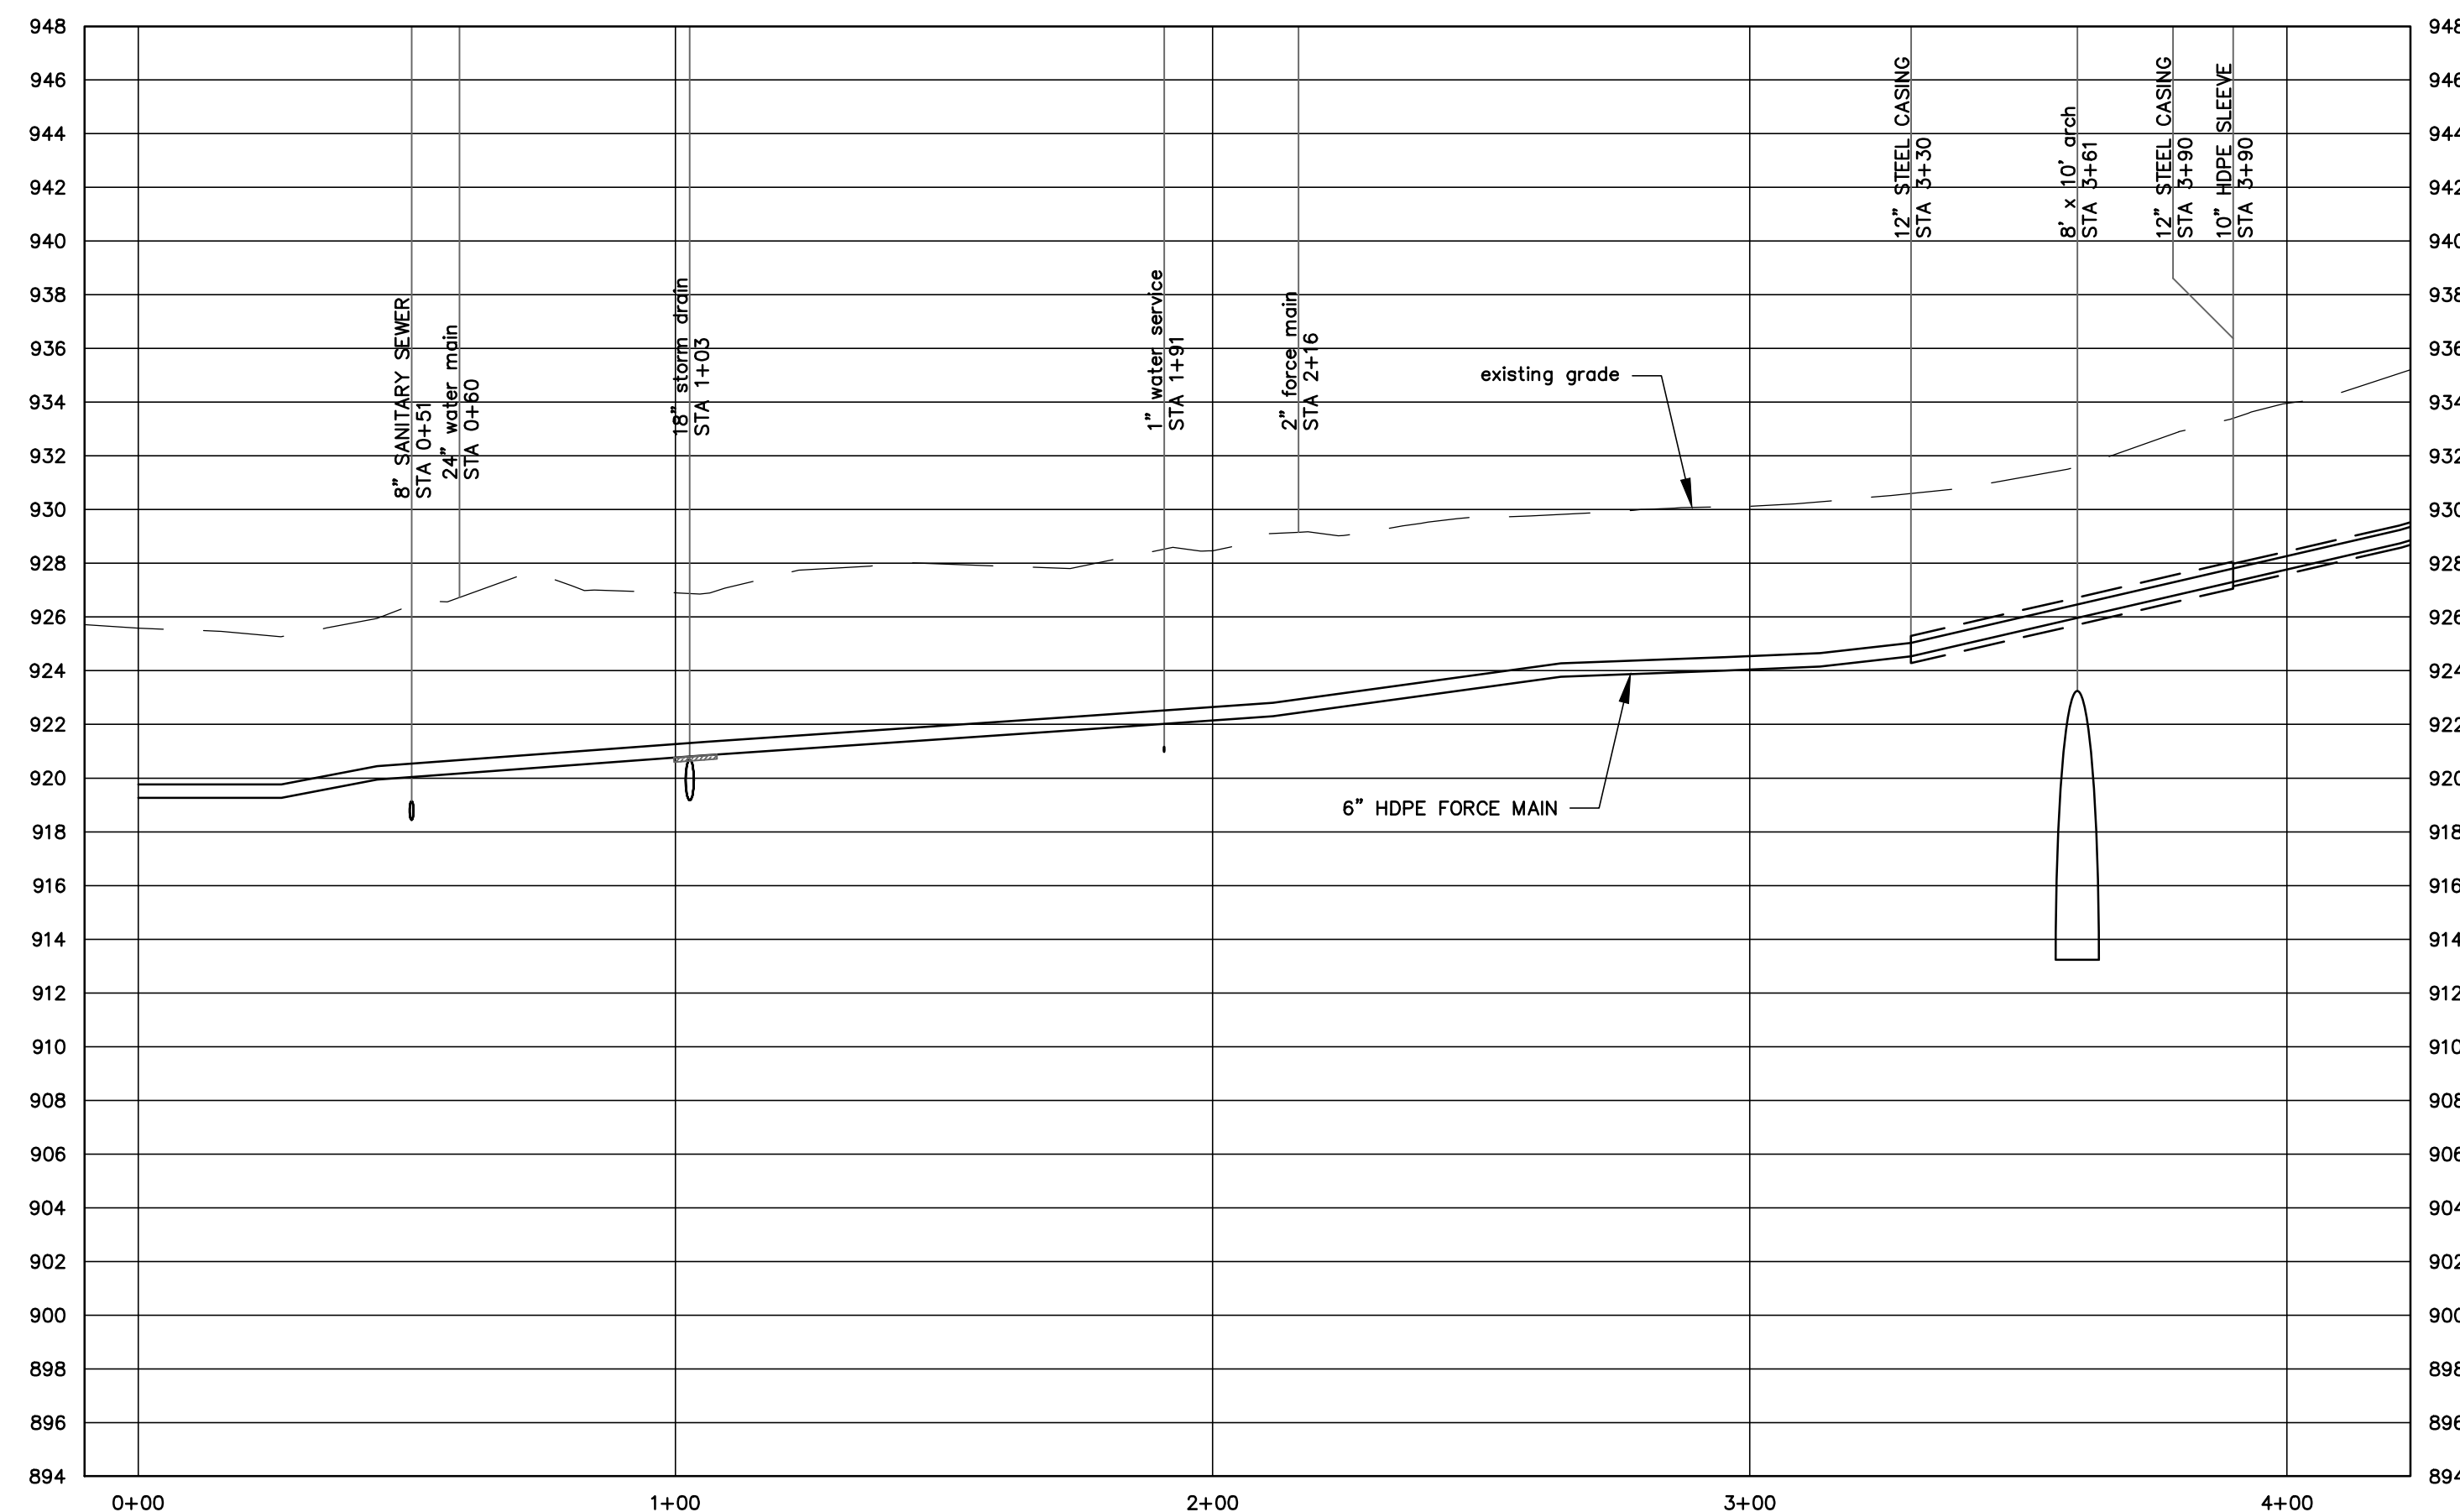

SEWER FORCE MAIN PROFILE

SCALE: 1" = 30' HORIZONTAL
1" = 6' VERTICAL

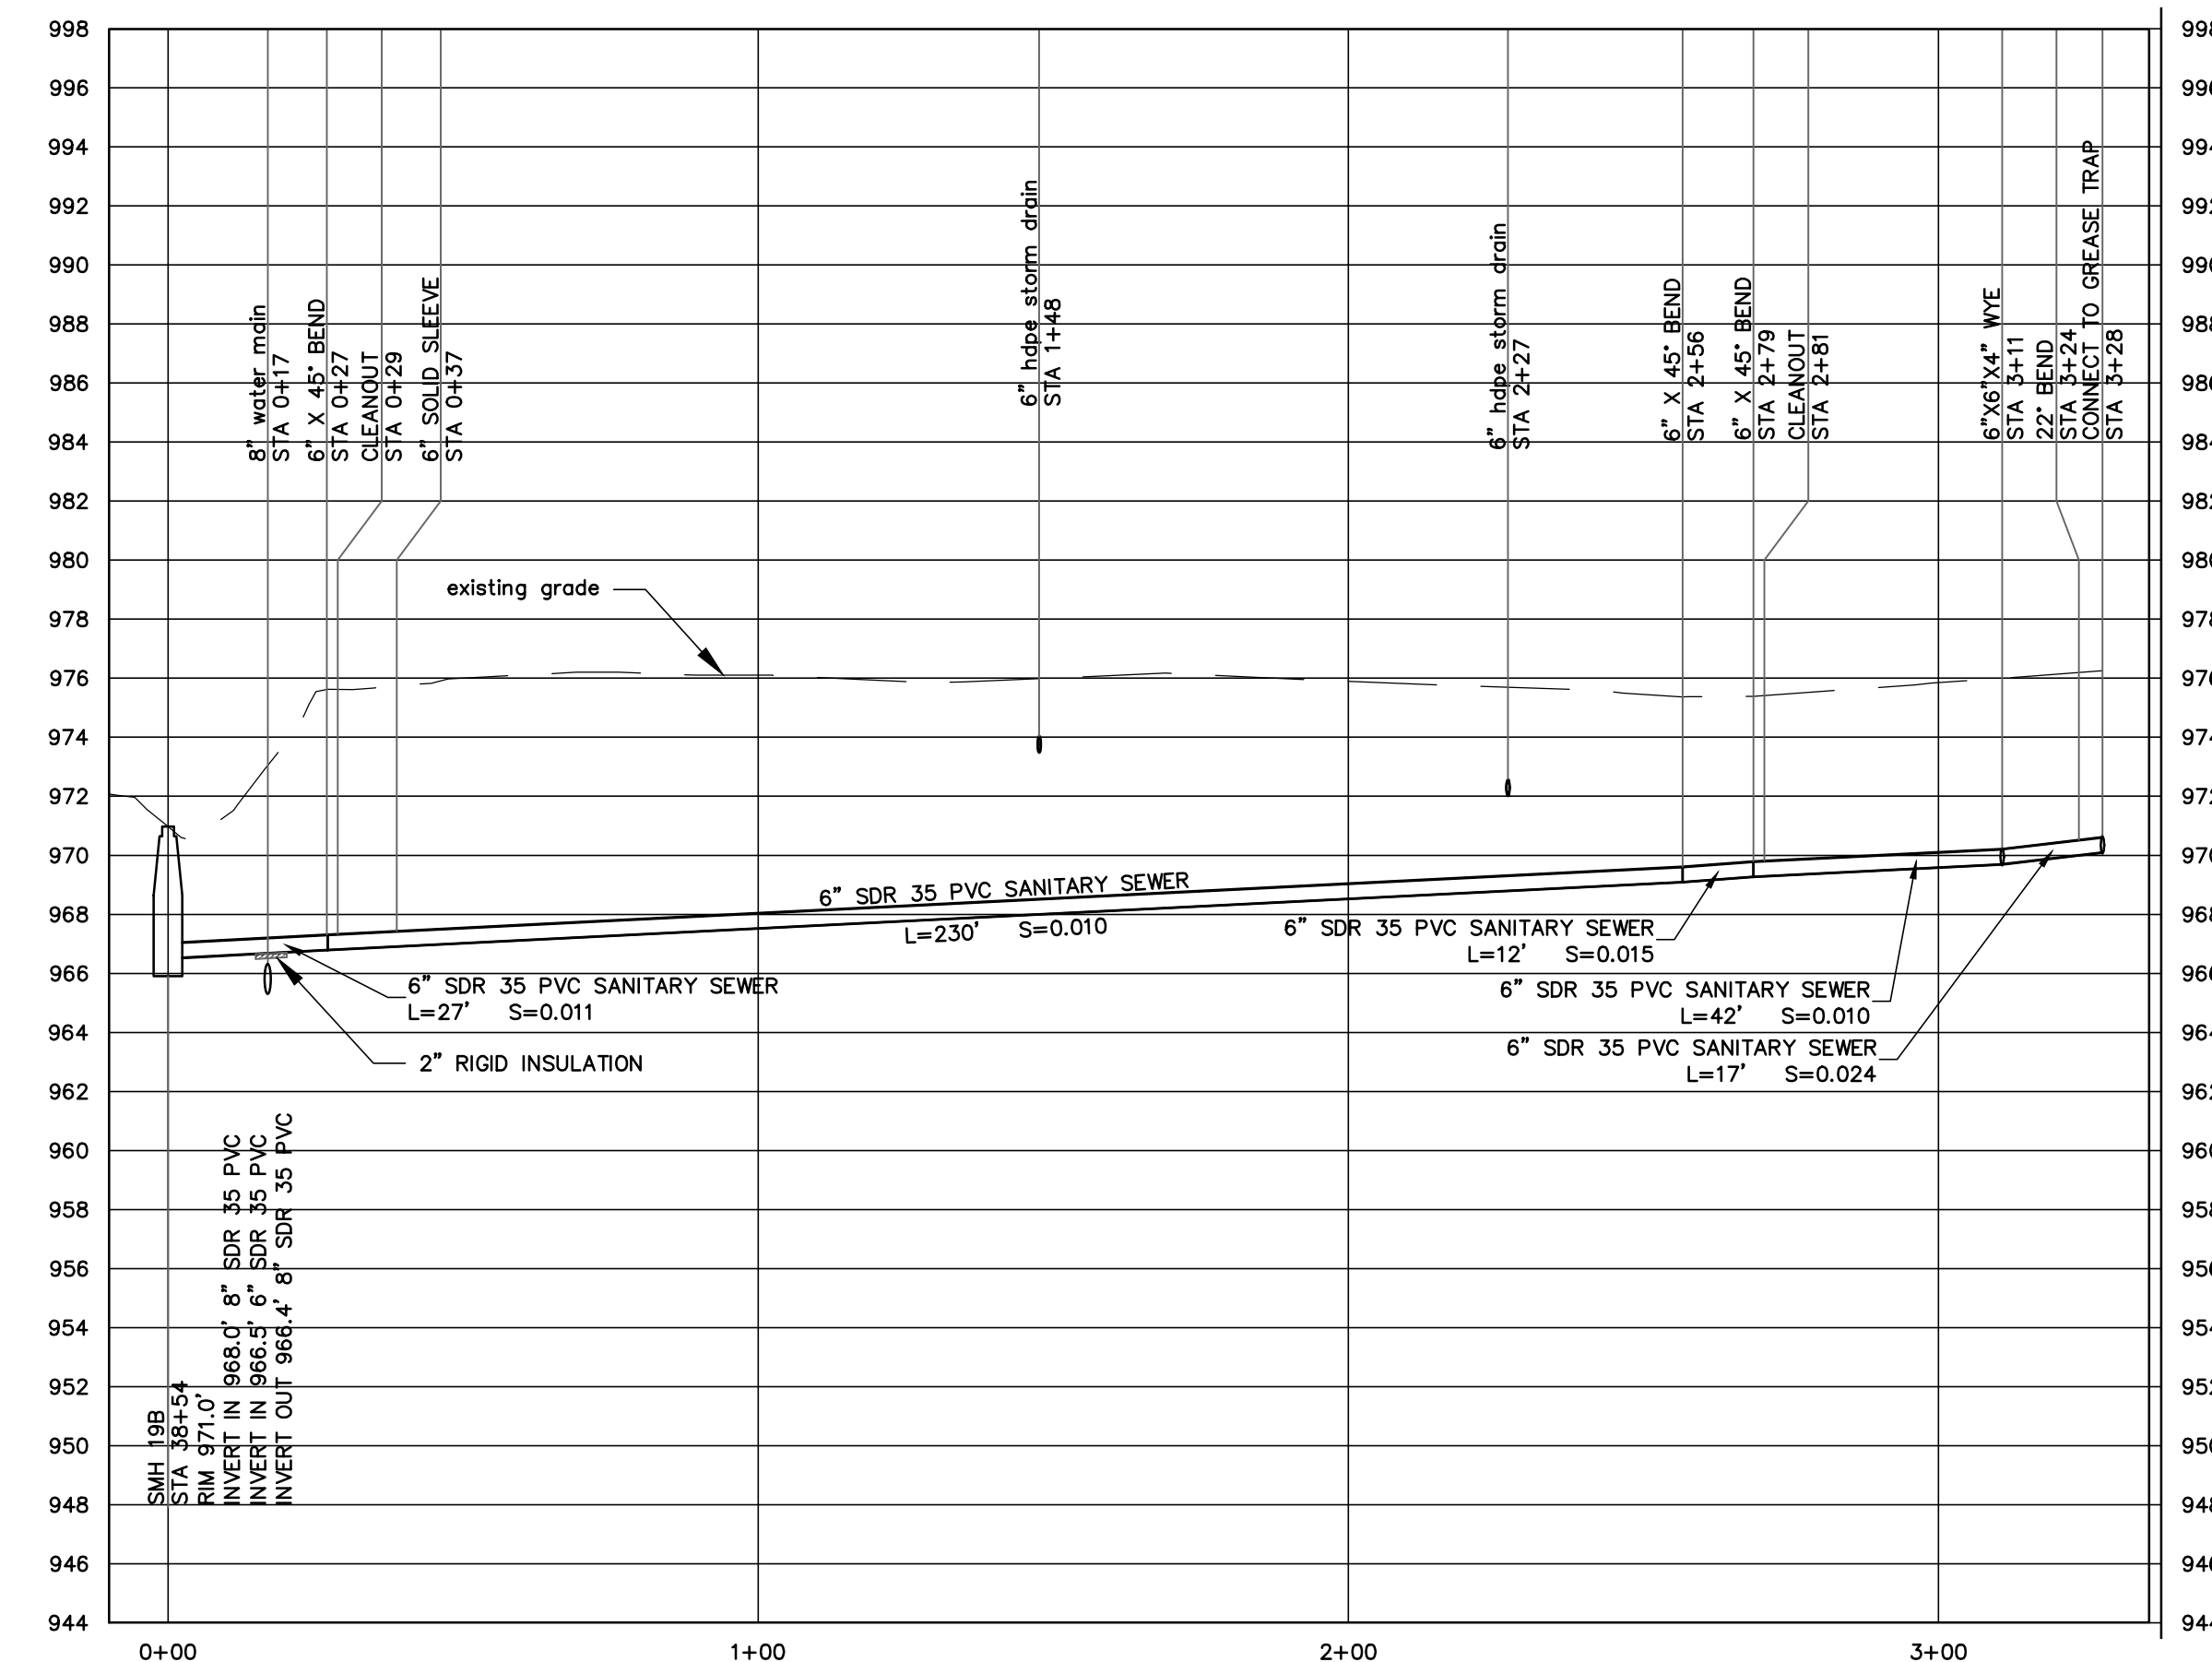

224 PAINE TURNPIKE NORTH SEWER SERVICE PROFILE

SCALE: 1" = 30' HORIZONTAL
1" = 6' VERTICAL




OTTER CREEK ENGINEERING

404 East Main Street
P.O. Box 712
East Middlebury, VT 05740
Telephone: 802-382-8522
Fax: 802-382-8640

110 Merchants Row
4th Floor, Suite 15
Rutland, VT 05701
Telephone: 802-747-3080
Fax: 802-747-4820
E-mail: info@ottercrk.com

STAMP AND SIGNATURE:

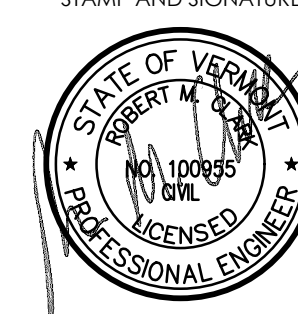

DESIGN ENGINEER

THESE DRAWINGS SHALL NOT BE ALTERED IN ANY WAY WITHOUT THE WRITTEN APPROVAL OF THE ENGINEER. ANY REVISIONS SHALL BE MADE BY THE ENGINEER AND NOTED IN THE REVISION BLOCK. © 2021

OTTER CREEK ENGINEERING, INC.

**TOWN OF BERLIN
PAINE TURNPIKE NORTH
WASTEWATER
IMPROVEMENTS
BERLIN, VERMONT**

RECORD

DATE ISSUED: 6/30/2021

REVISIONS:

DRAWN BY: RR

CHECKED BY: JK

SCALE: AS SHOWN

PROJECT NO.: 519.005

CADD FILE:

TITLE:

PROFILES

DRAWING NO.

C-9




OTTER CREEK
ENGINEERING

404 East Main Street
P.O. Box 712
East Middlebury, VT 05740
Telephone: 802.382.8522
Fax: 802.382.8440

110 Merchants Row
4th Floor, Suite 15
Rutland, VT 05701
Telephone: 802.747.3080
Fax: 802.747.4820
E-mail: info@ottercreek.com

STAMP AND SIGNATURE:

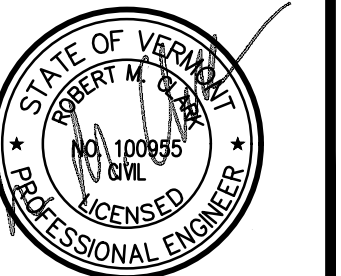

DESIGN ENGINEER

THESE DRAWINGS SHALL NOT
BE ALTERED IN ANY WAY
WITHOUT THE WRITTEN
APPROVAL OF THE ENGINEER.
ANY REVISIONS SHALL BE
MADE BY THE ENGINEER AND
NOTED IN THE REVISION
BLOCK. © 2021

OTTER CREEK ENGINEERING, INC.

TOWN OF BERLIN
PAINÉ TURNPIKE NORTH
WASTEWATER
IMPROVEMENTS
BERLIN, VERMONT

RECORD

DATE ISSUED: 6/30/2021

REVISIONS:

DRAWN BY: RR

CHECKED BY: JK

SCALE: AS SHOWN






PROJECT NO.: 519.005

CADD FILE: 519-005 DETAILS

TITLE:
PUMP STATION
DETAILS


DRAWING NO.

C-10

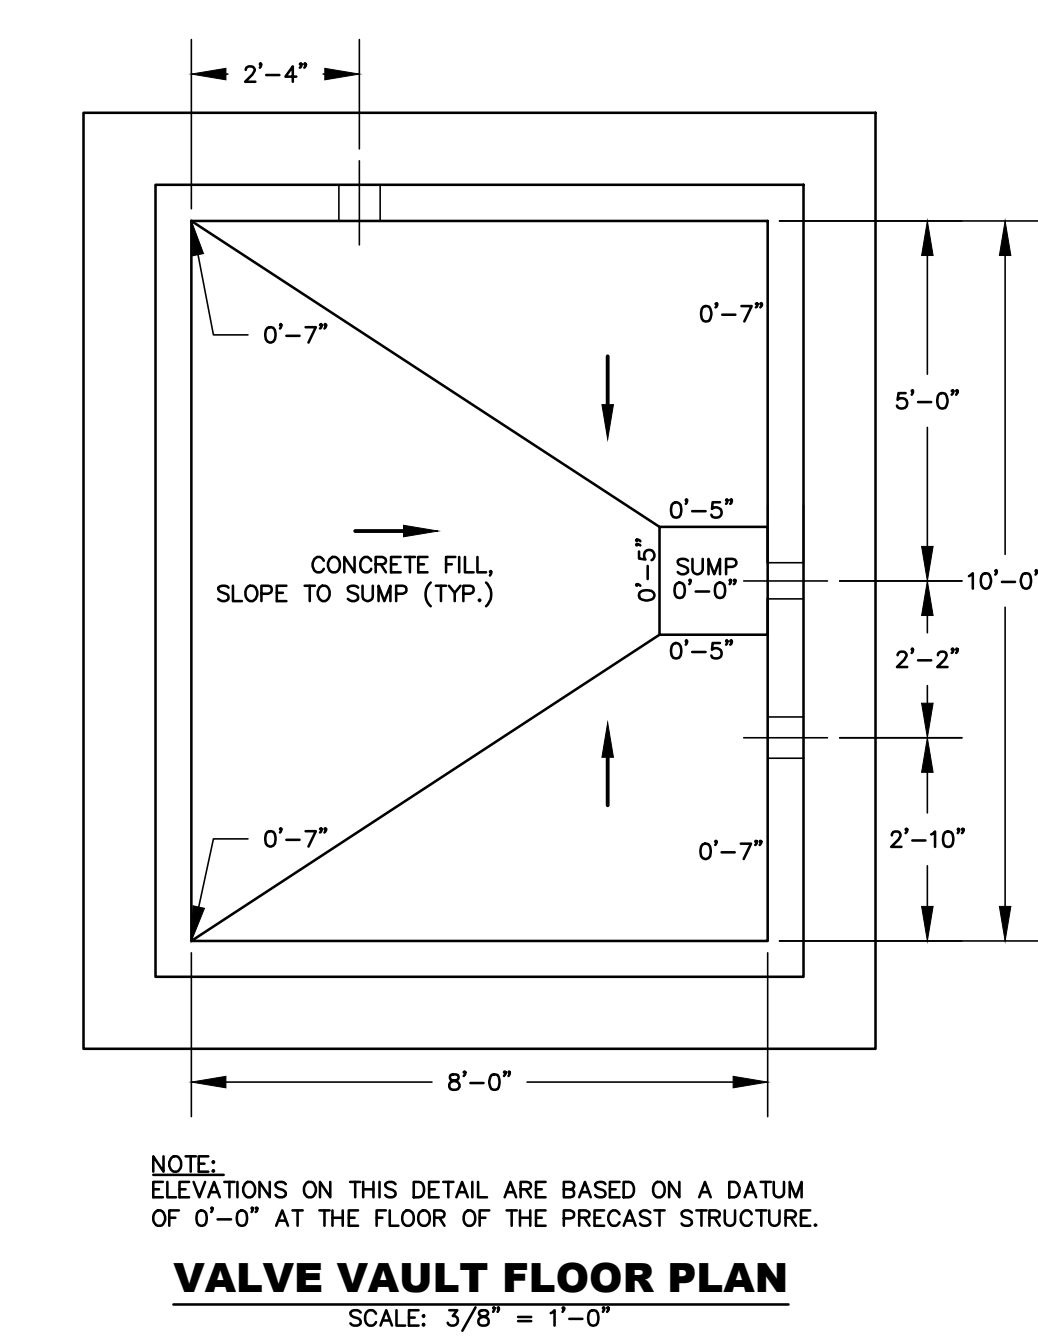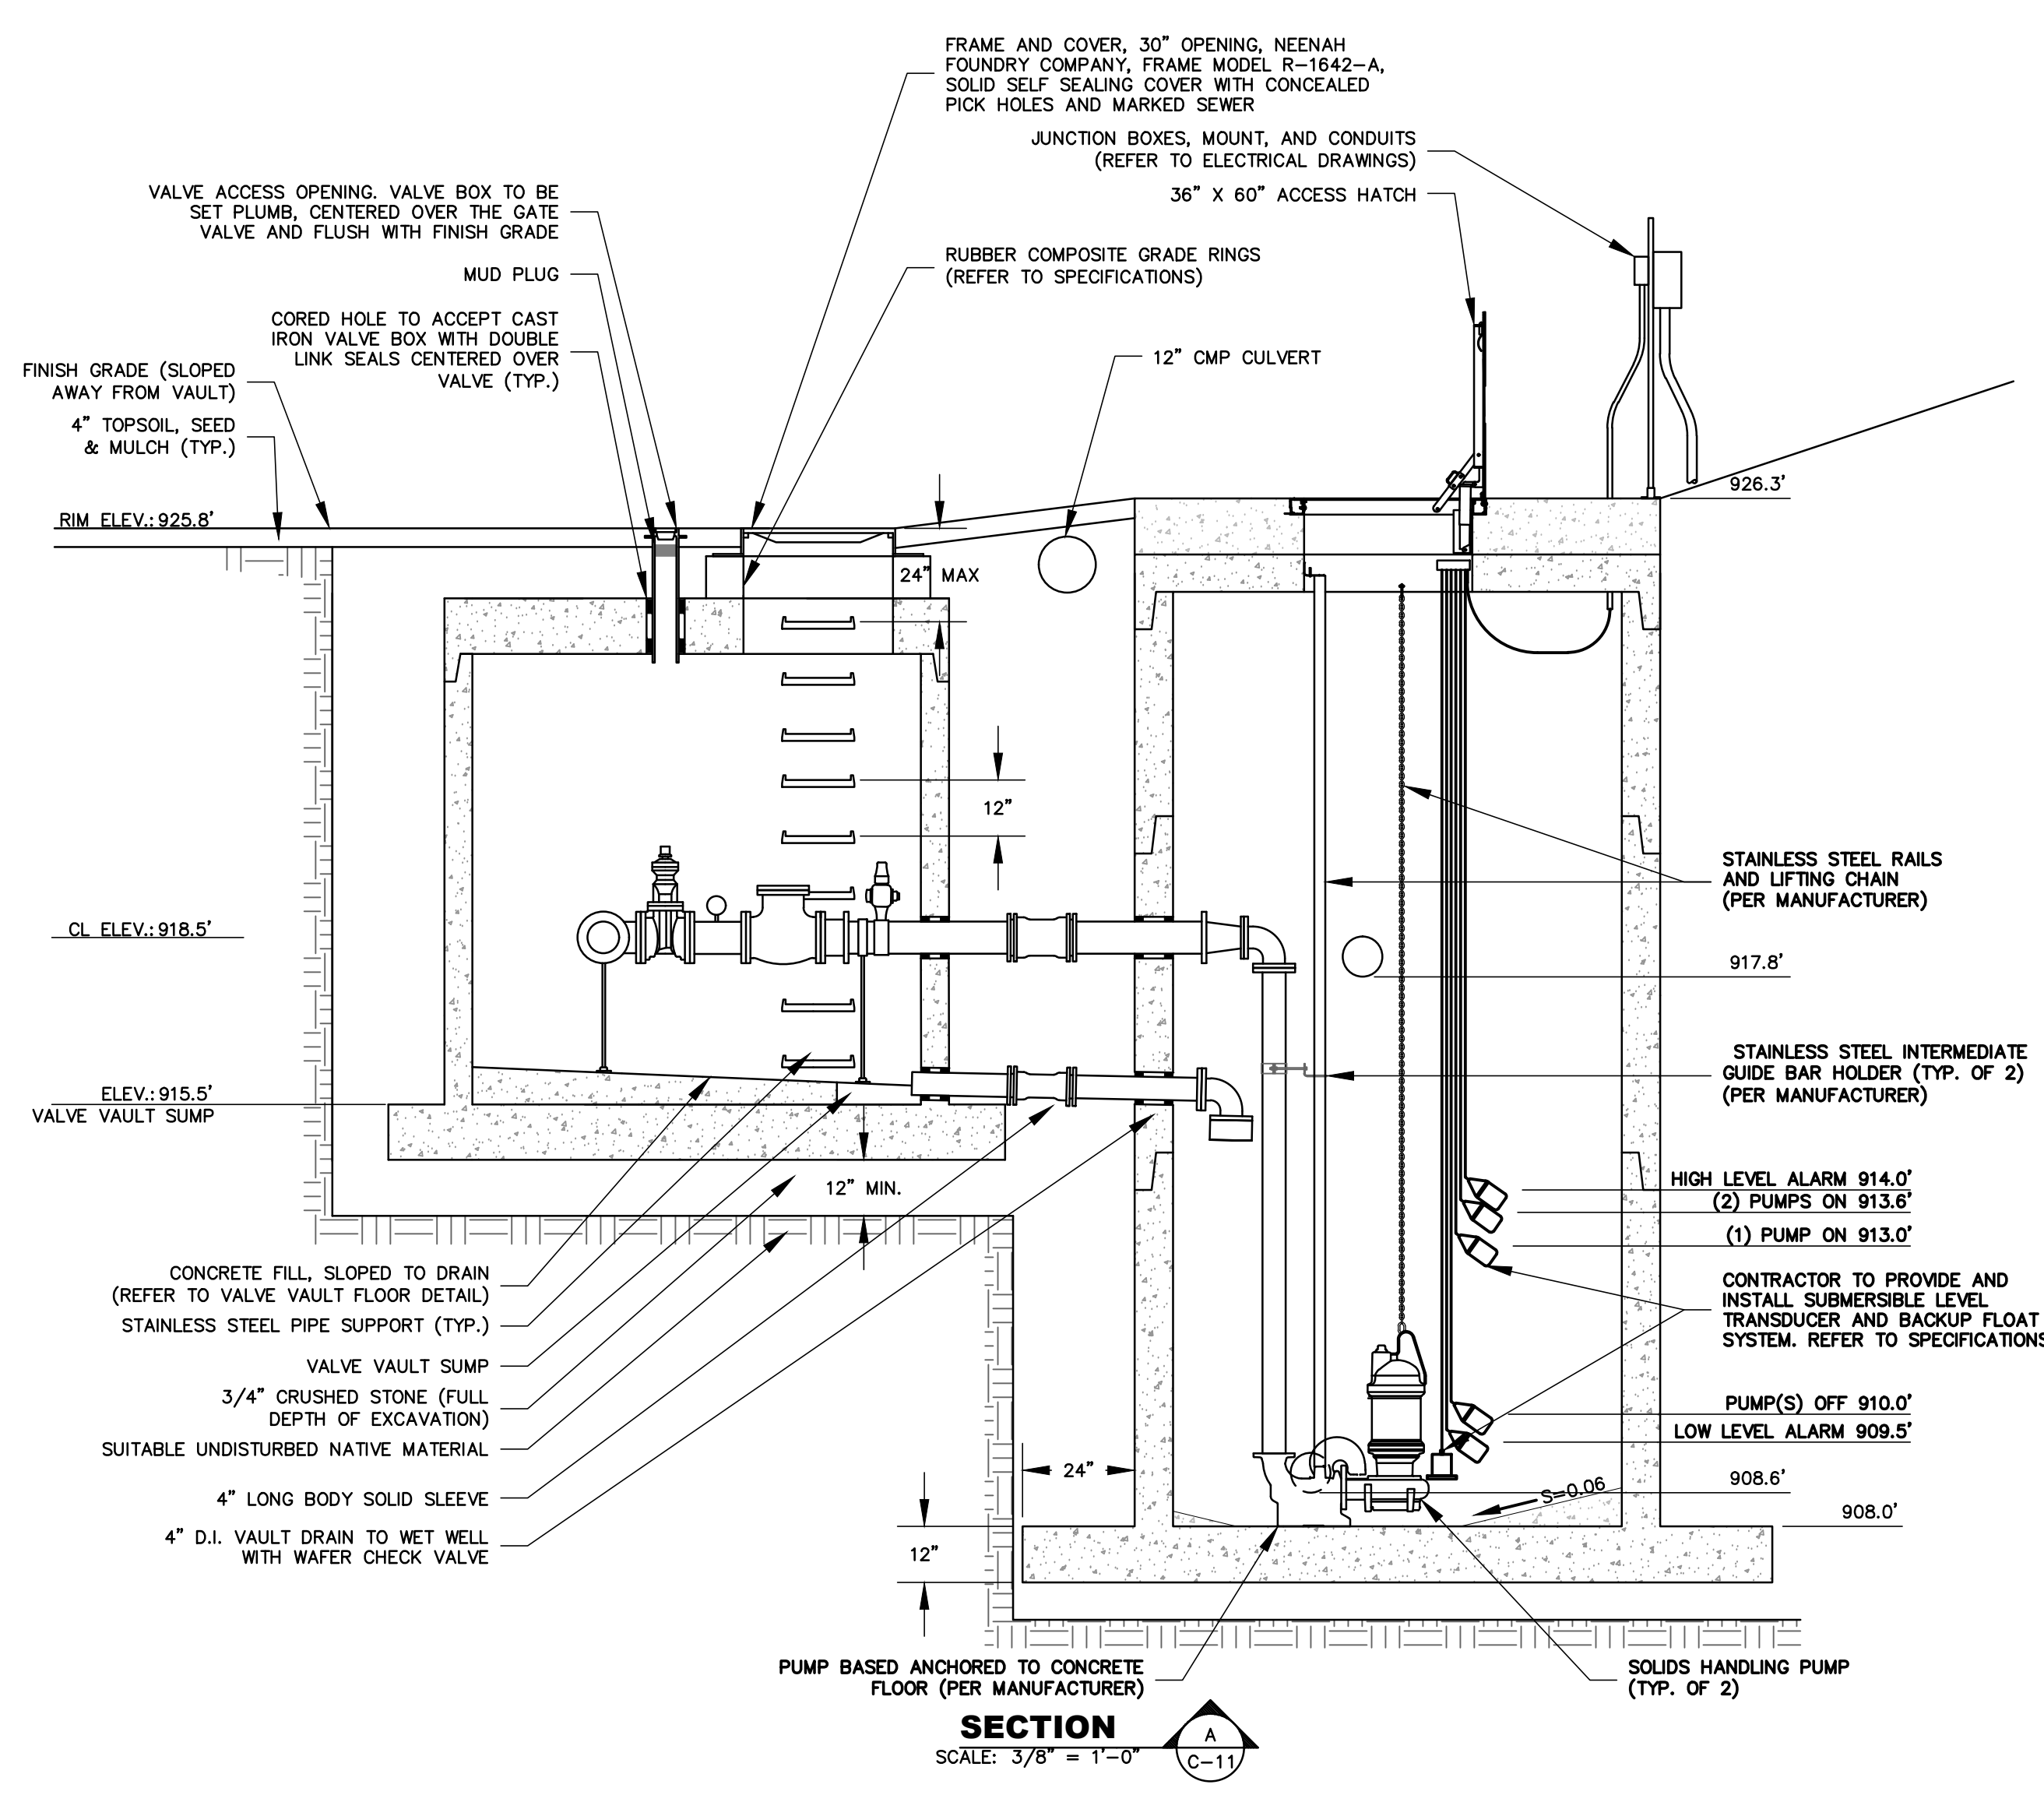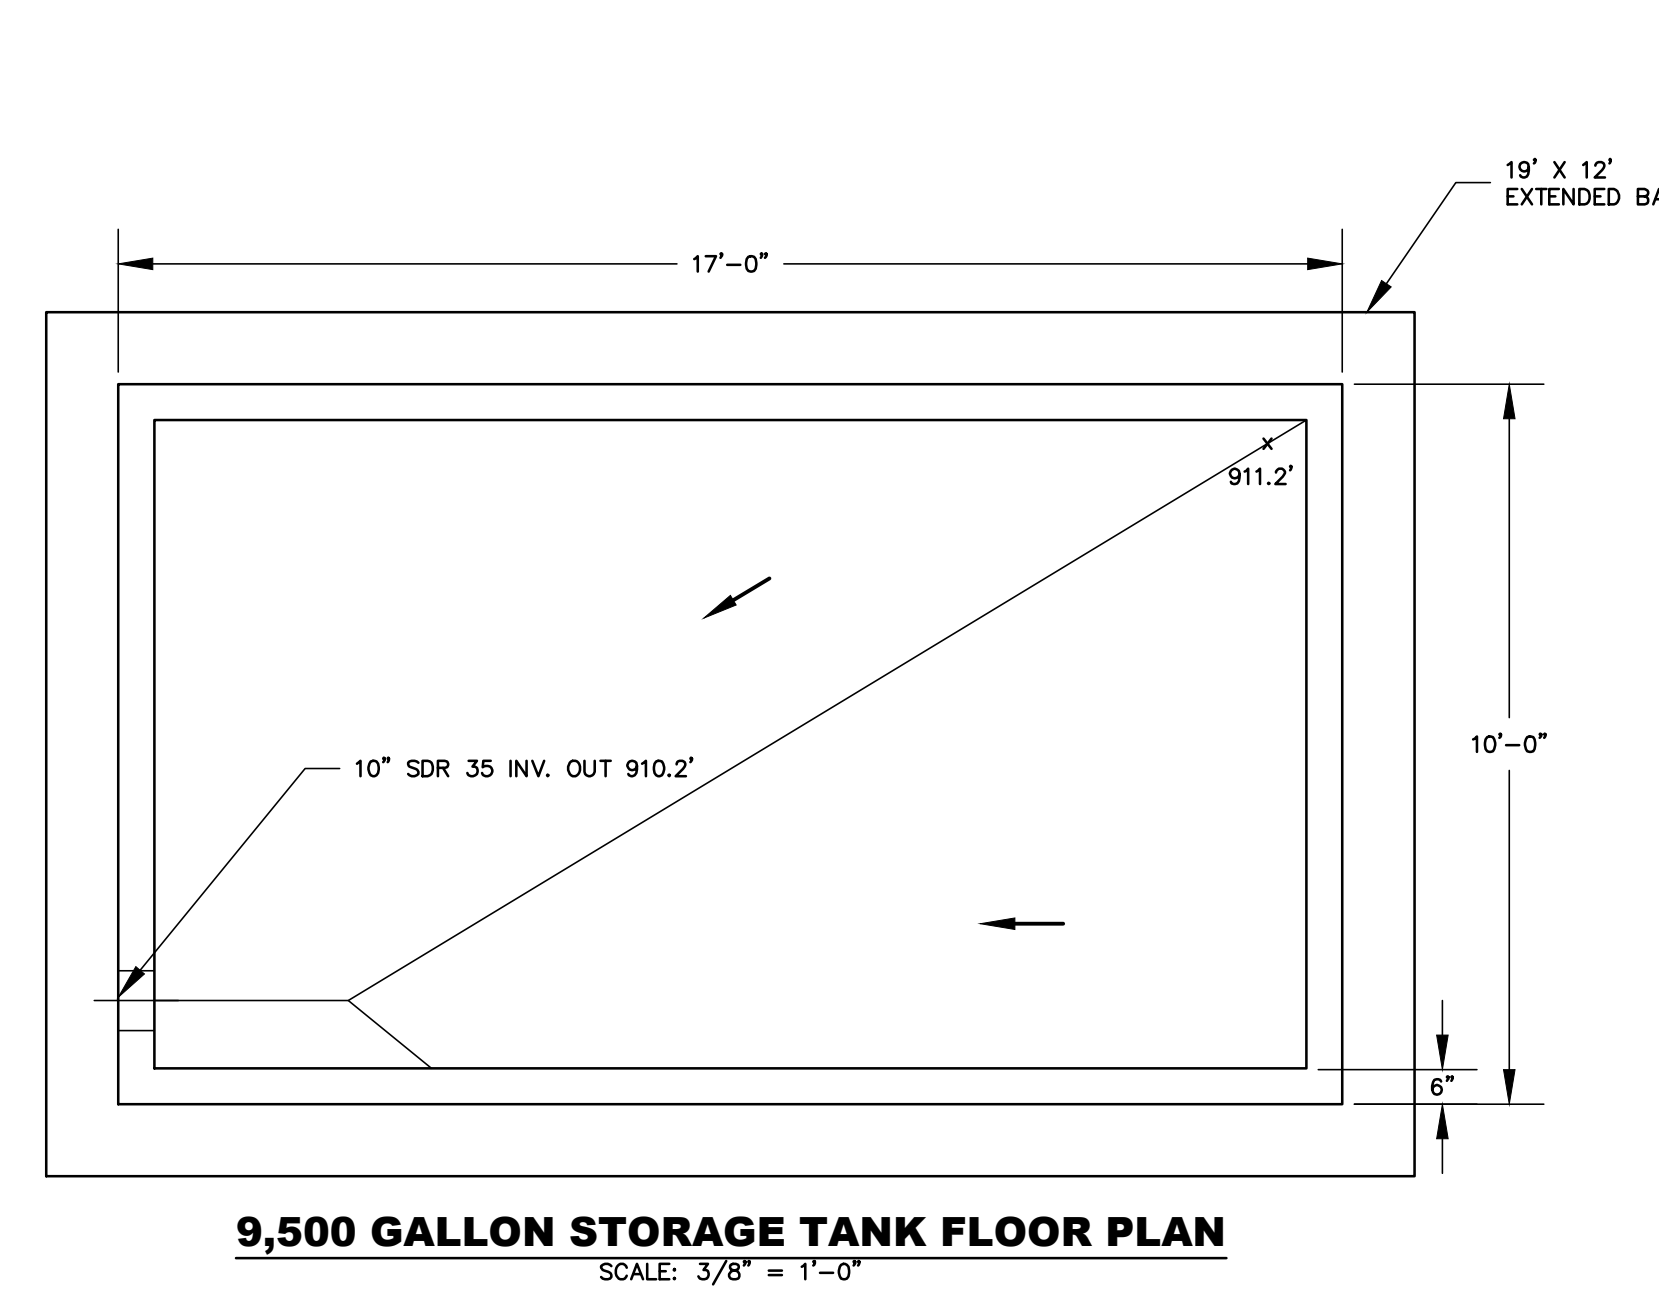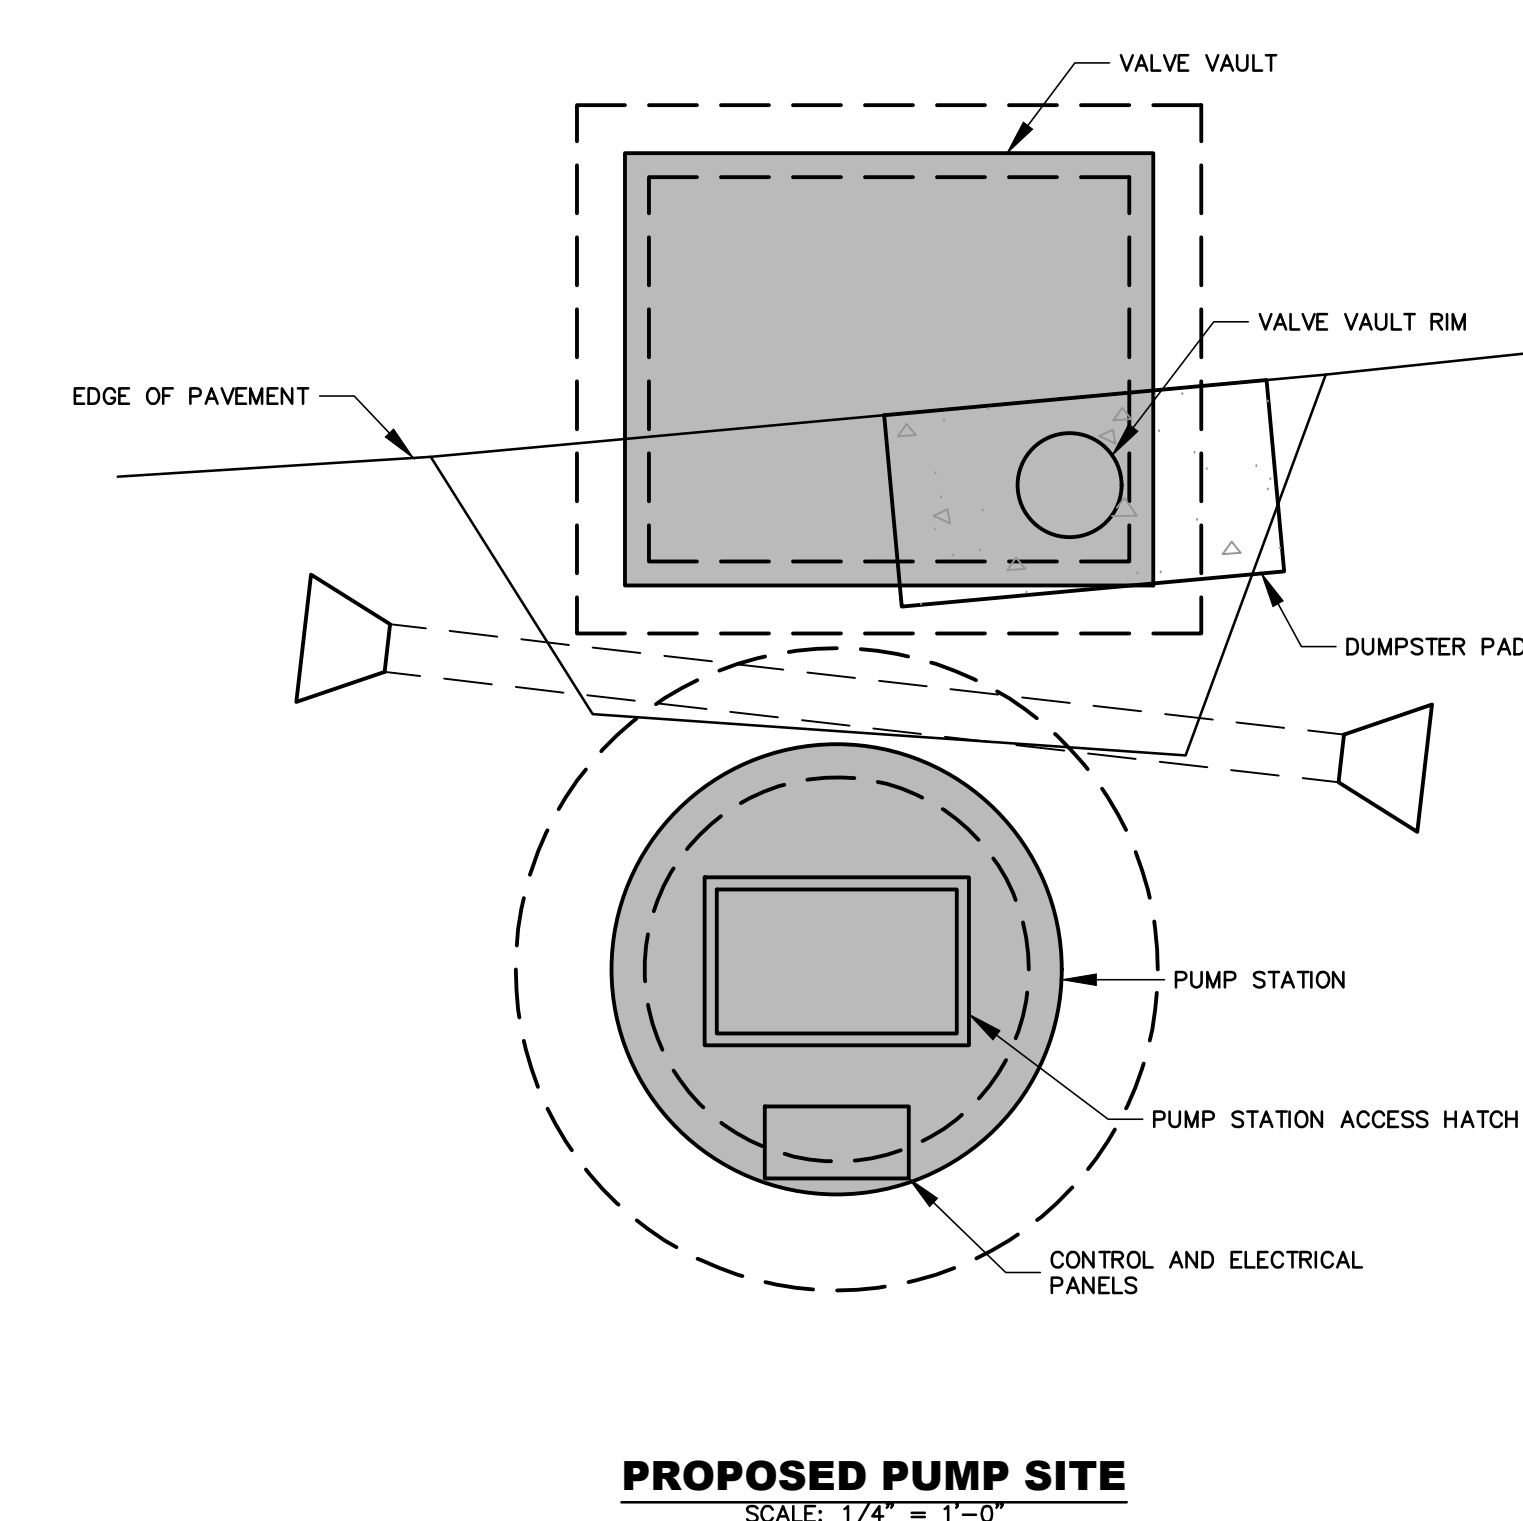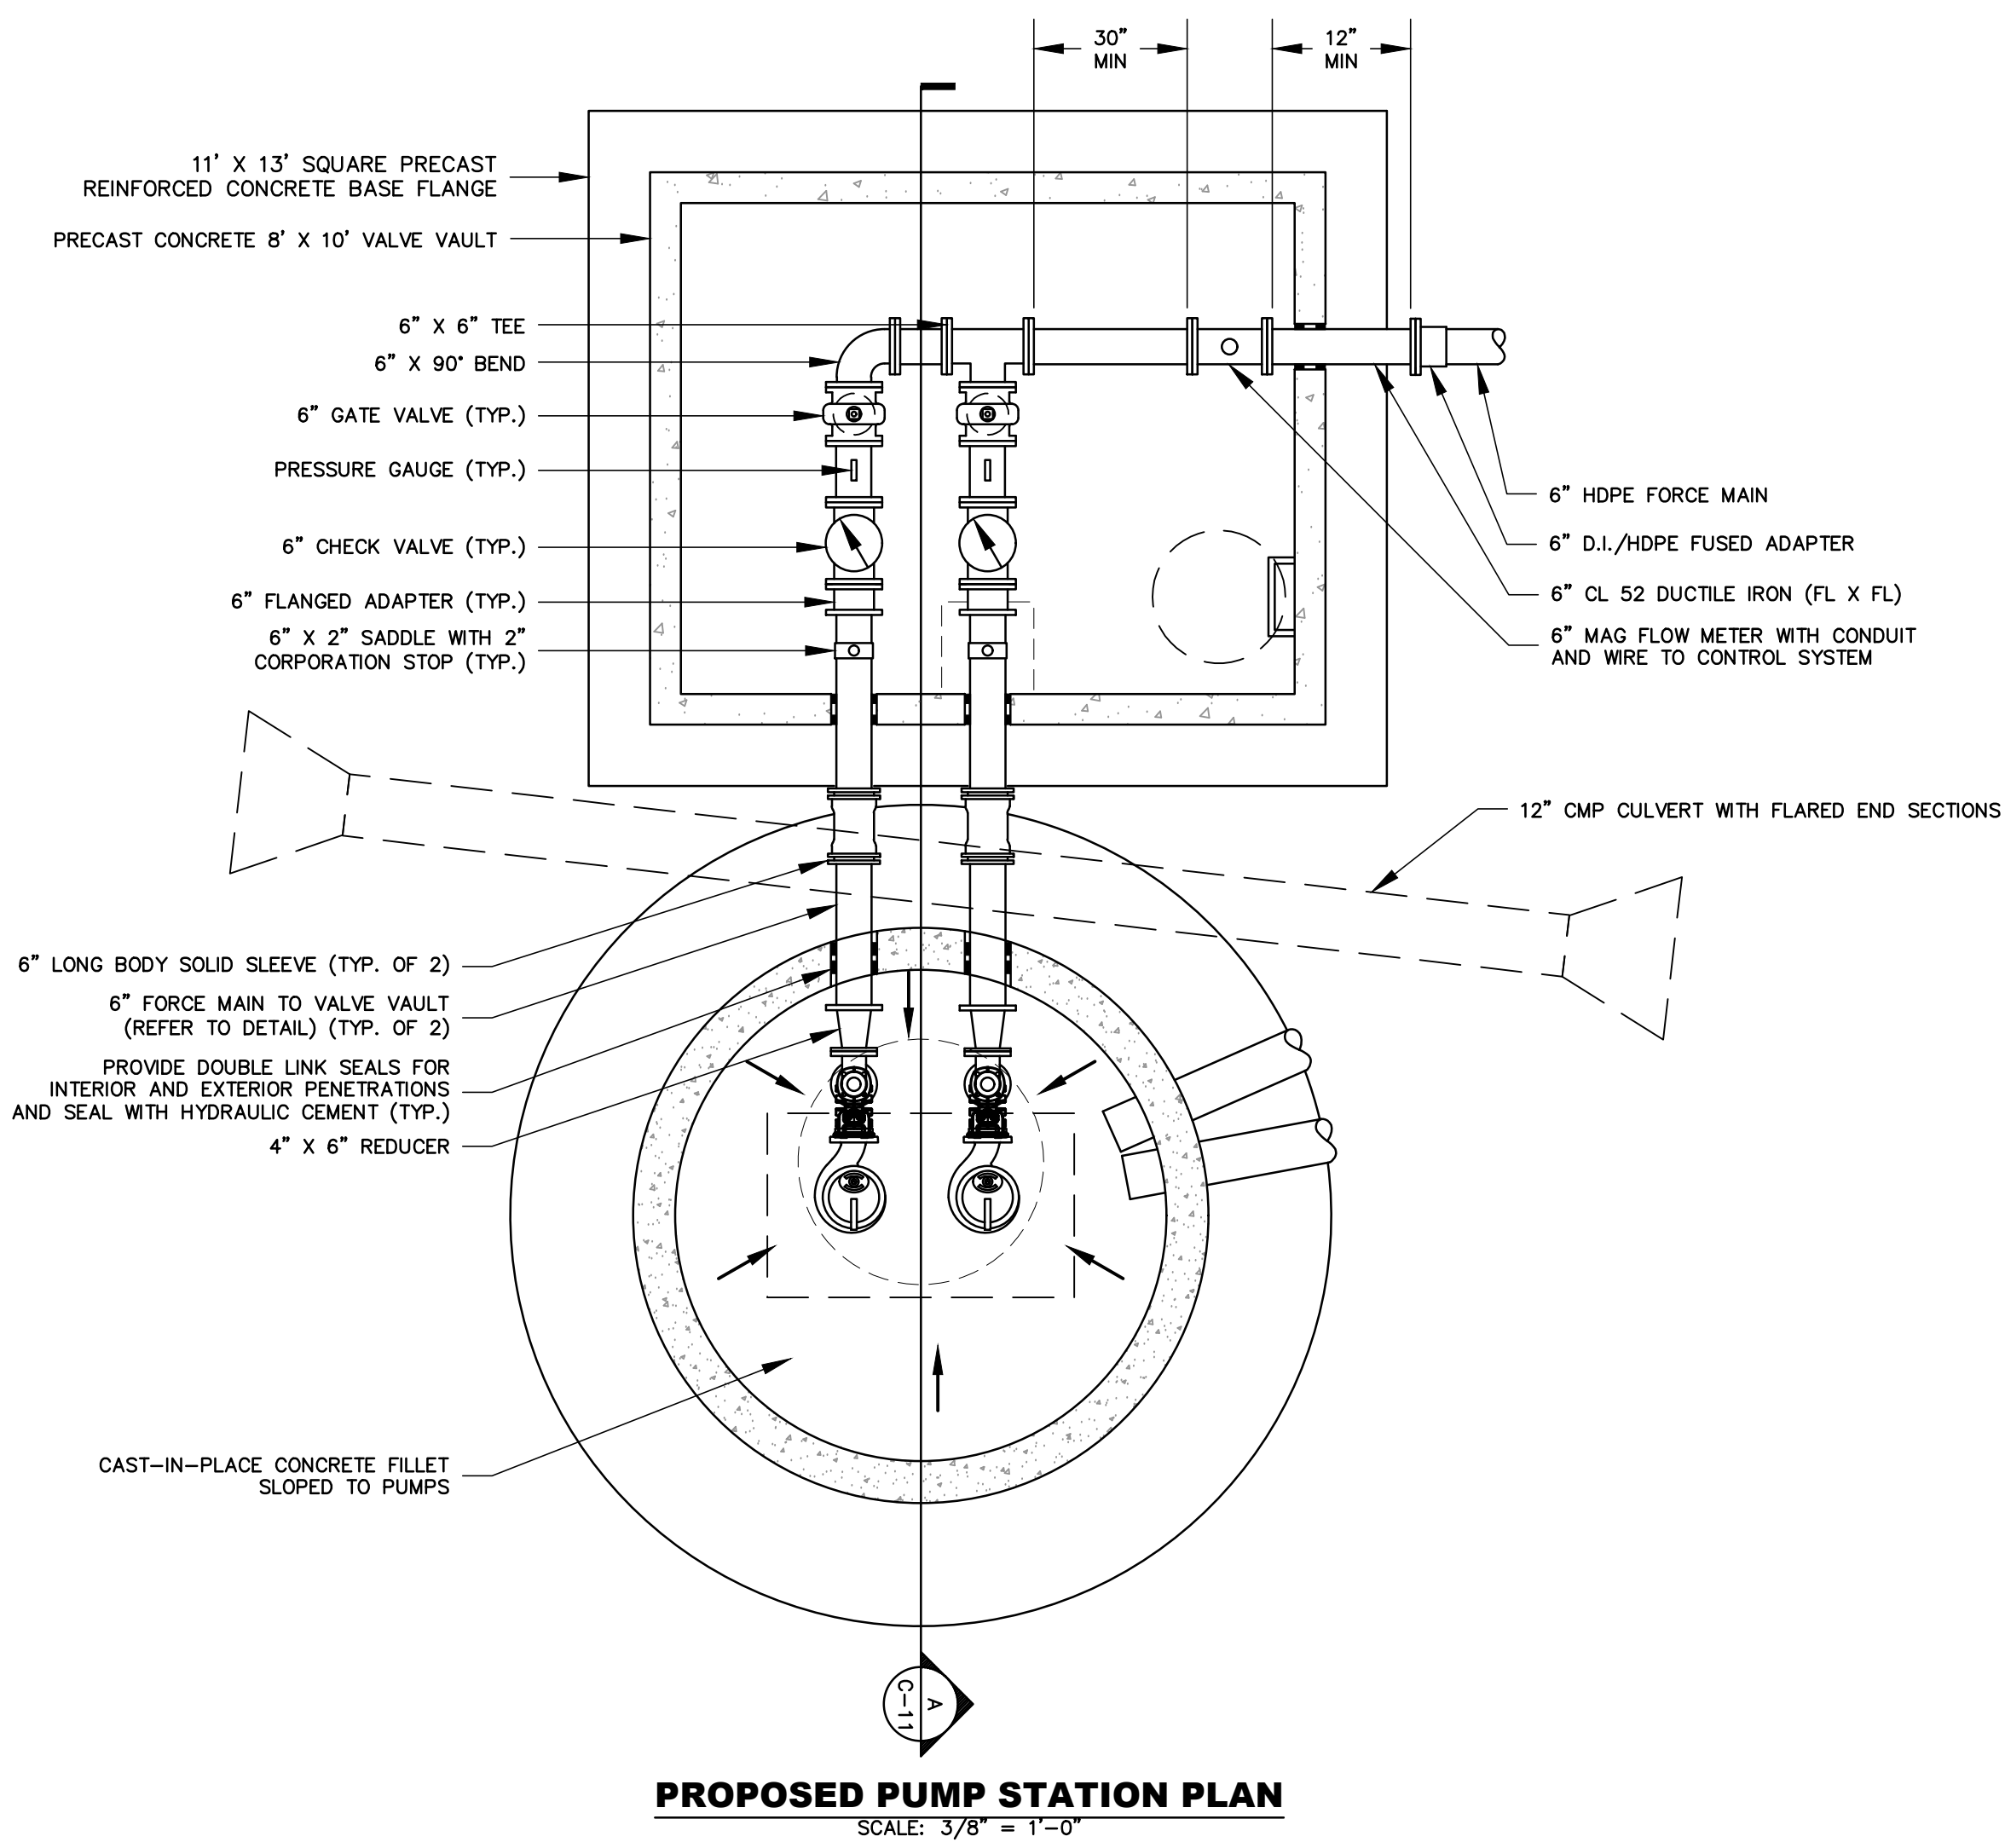

ANTI-BUOYANCY DESIGN NOTES:

1. ANTI-BUOYANCY DESIGN IS BASED ON GROUNDWATER TABLE AT FINISHED GRADE, A UNIT WEIGHT OF SATURATED SOIL OF 120 POUNDS PER CUBIC FOOT, AND A SAFETY FACTOR OF 1.80.
2. THE DESIGN INCLUDES A COMBINATION OF EXTENDED PRECAST BASE SLABS AND CONCRETE FILL ABOVE TANKS.
3. ALTERNATIVE DESIGNS WILL BE ACCEPTED FROM PRECAST SUPPLIERS WITH DRAWINGS STAMPED BY A VERMONT PROFESSIONAL ENGINEER AND ASSOCIATED DESIGN CALCULATIONS DURING THE SUBMITTAL PROCESS.

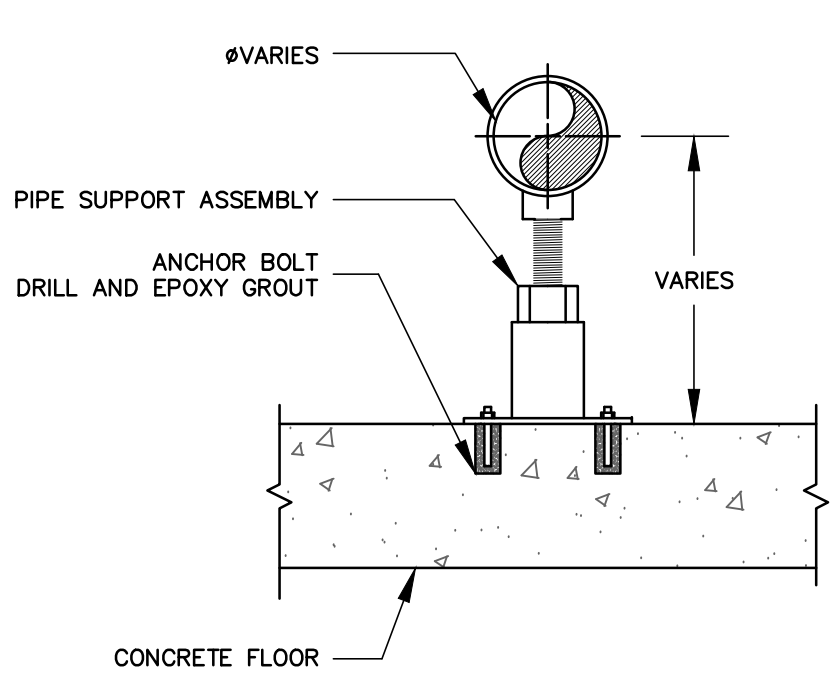


PIPE STAND GENERAL NOTES:

1. FINAL QUANTITY, LOCATION, SIZE AND TYPE OF PIPE HANGERS, SUPPORTS, AND ANCHOR BOLTS SHALL BE SELECTED PER MANUFACTURER'S RECOMMENDATIONS BASED ON THE INSTALLED PIPE SIZE AND TYPE.
2. PIPE HANGERS AND SUPPORTS TO BE FULLY ADJUSTABLE TO ALLOW FOR PROPER VERTICAL ALIGNMENT.
3. HANGERS AND SUPPORTS TO BE PLUMB AND TRUE.
4. PAINT TO MATCH PIPE.
5. REFER TO PROCESS WATER PIPING SPECIFICATION.



RECORD DRAWING

Record drawings have been prepared on the basis of information furnished by others. The engineer is not responsible for errors or omissions which have been incorporated into this document as a result. The location of items shown without labeled dimensions shall be considered as approximate. Profiles show general layout. Due to changes during construction, alignment, station and elevation information may not be correct. The site was not re-surveyed after construction, so "as-built" locations, elevations and finish grades are approximate and shall be considered "schematic". Details and cross sections may not reflect "as built" conditions.
Prepared by: Otter Creek Engineering, Inc., East Middlebury, Vermont.

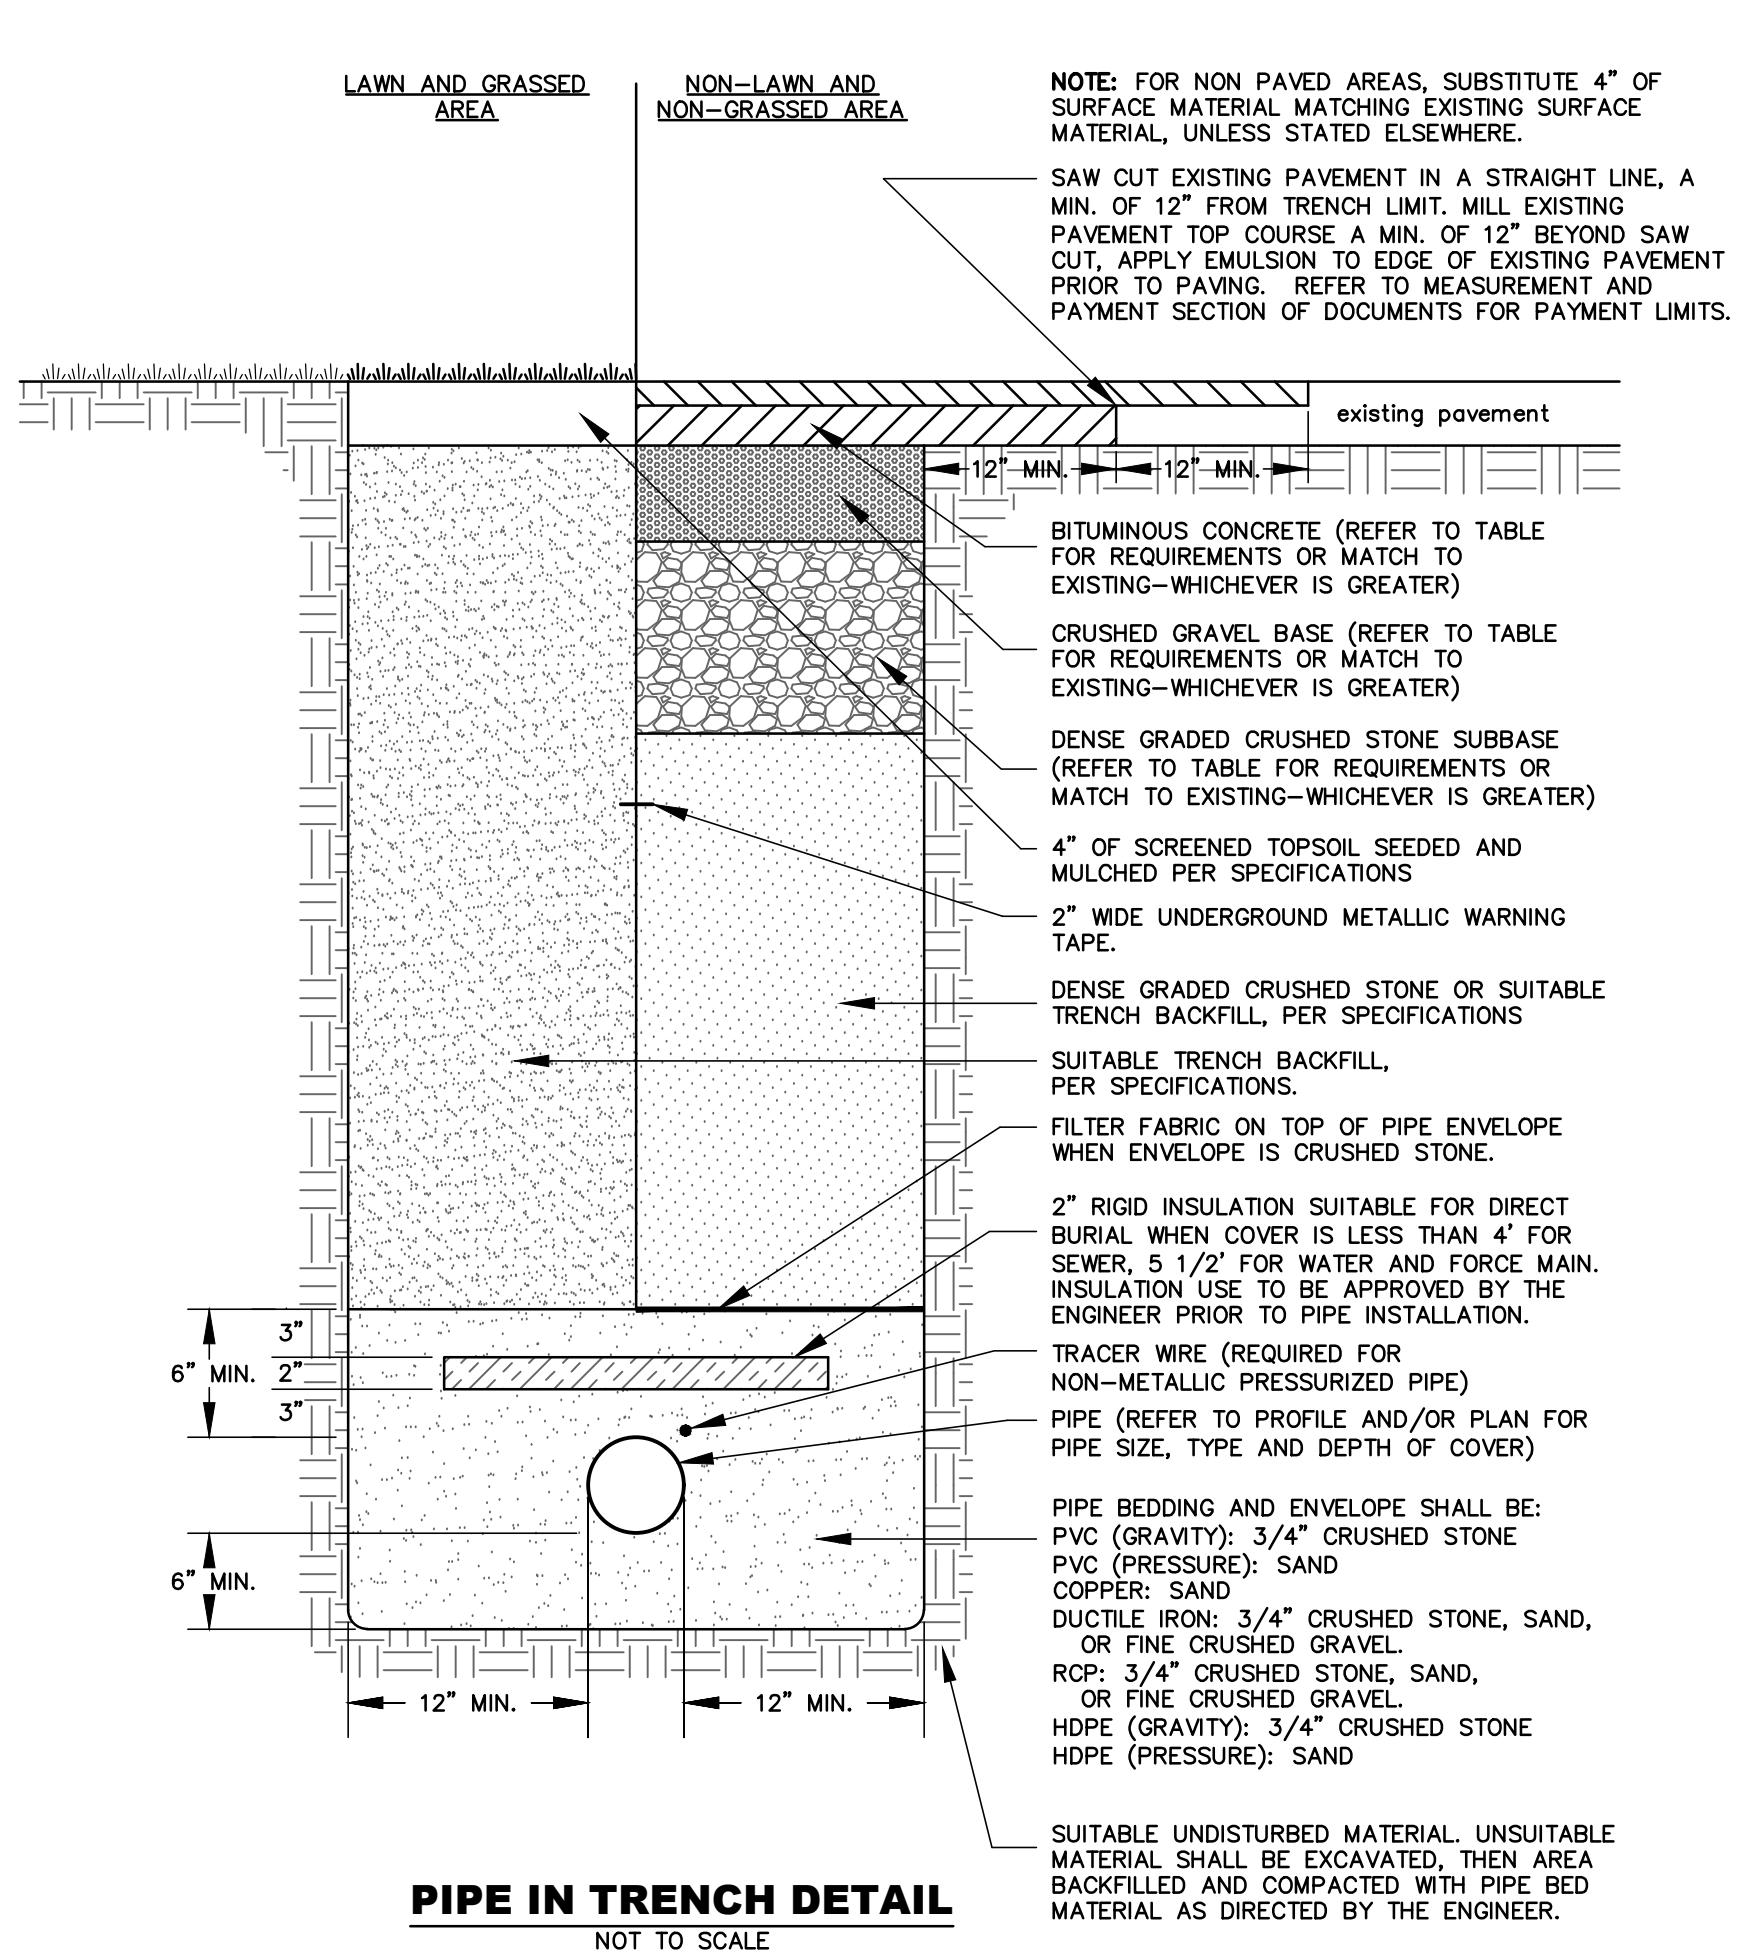


TRENCH RESTORATION TABLE

LOCATION	BITUMINOUS PAVEMENT (THICKNESS/TYPE)	CRUSHED GRAVEL BASE	DENSE GRADED CRUSHED STONE SUBBASE
STATE VTRANS	TOP: 1.5"/TYPE 3 (1/2") BASE: 2.5"/TYPE 2 (3/4")	6"	18"
TOWN ROADS	TOP: 1.5"/TYPE 4 (3/8") BASE: 2.5"/TYPE 2 (3/4")	6"	18"
PRIVATE/DRIVE	TOP: 1.5"/TYPE 4 (3/8") BASE: 2.5"/TYPE 2 (3/4")	6"	18"

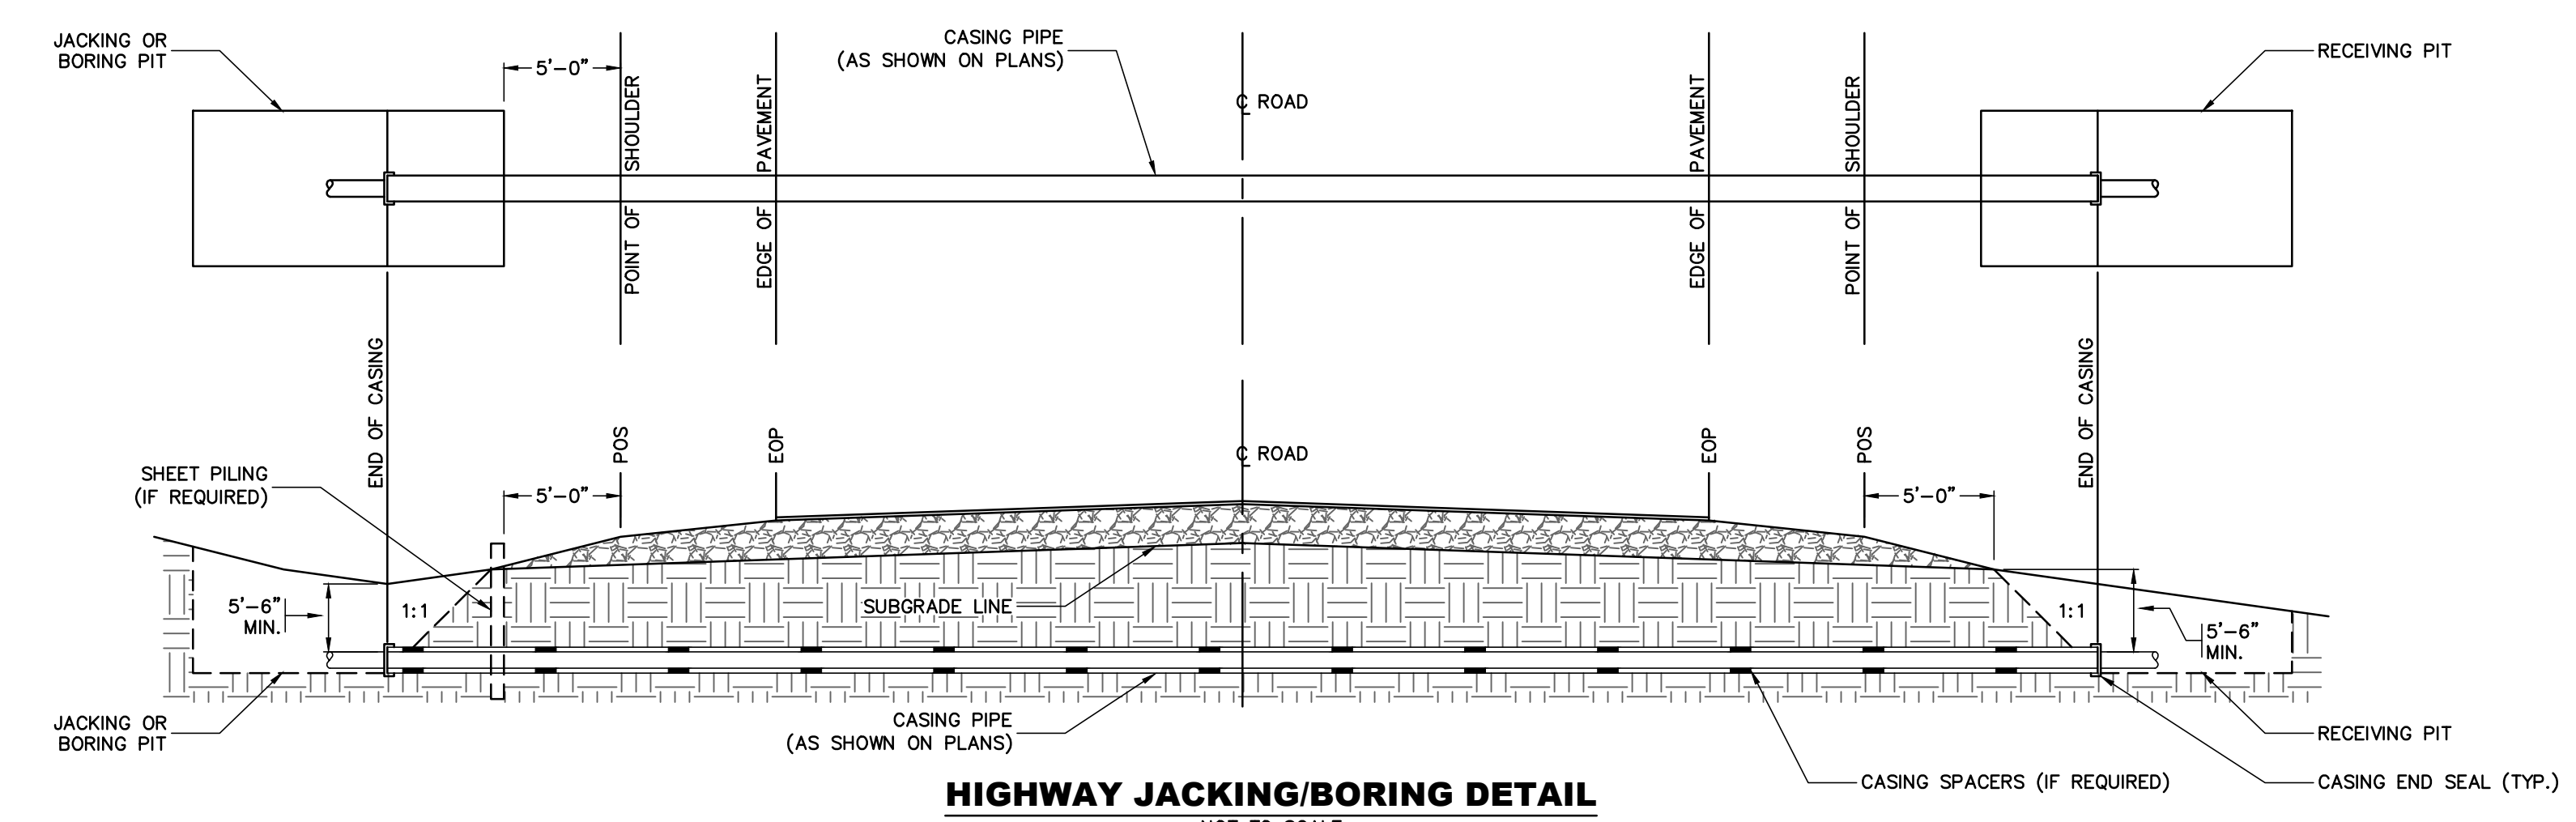
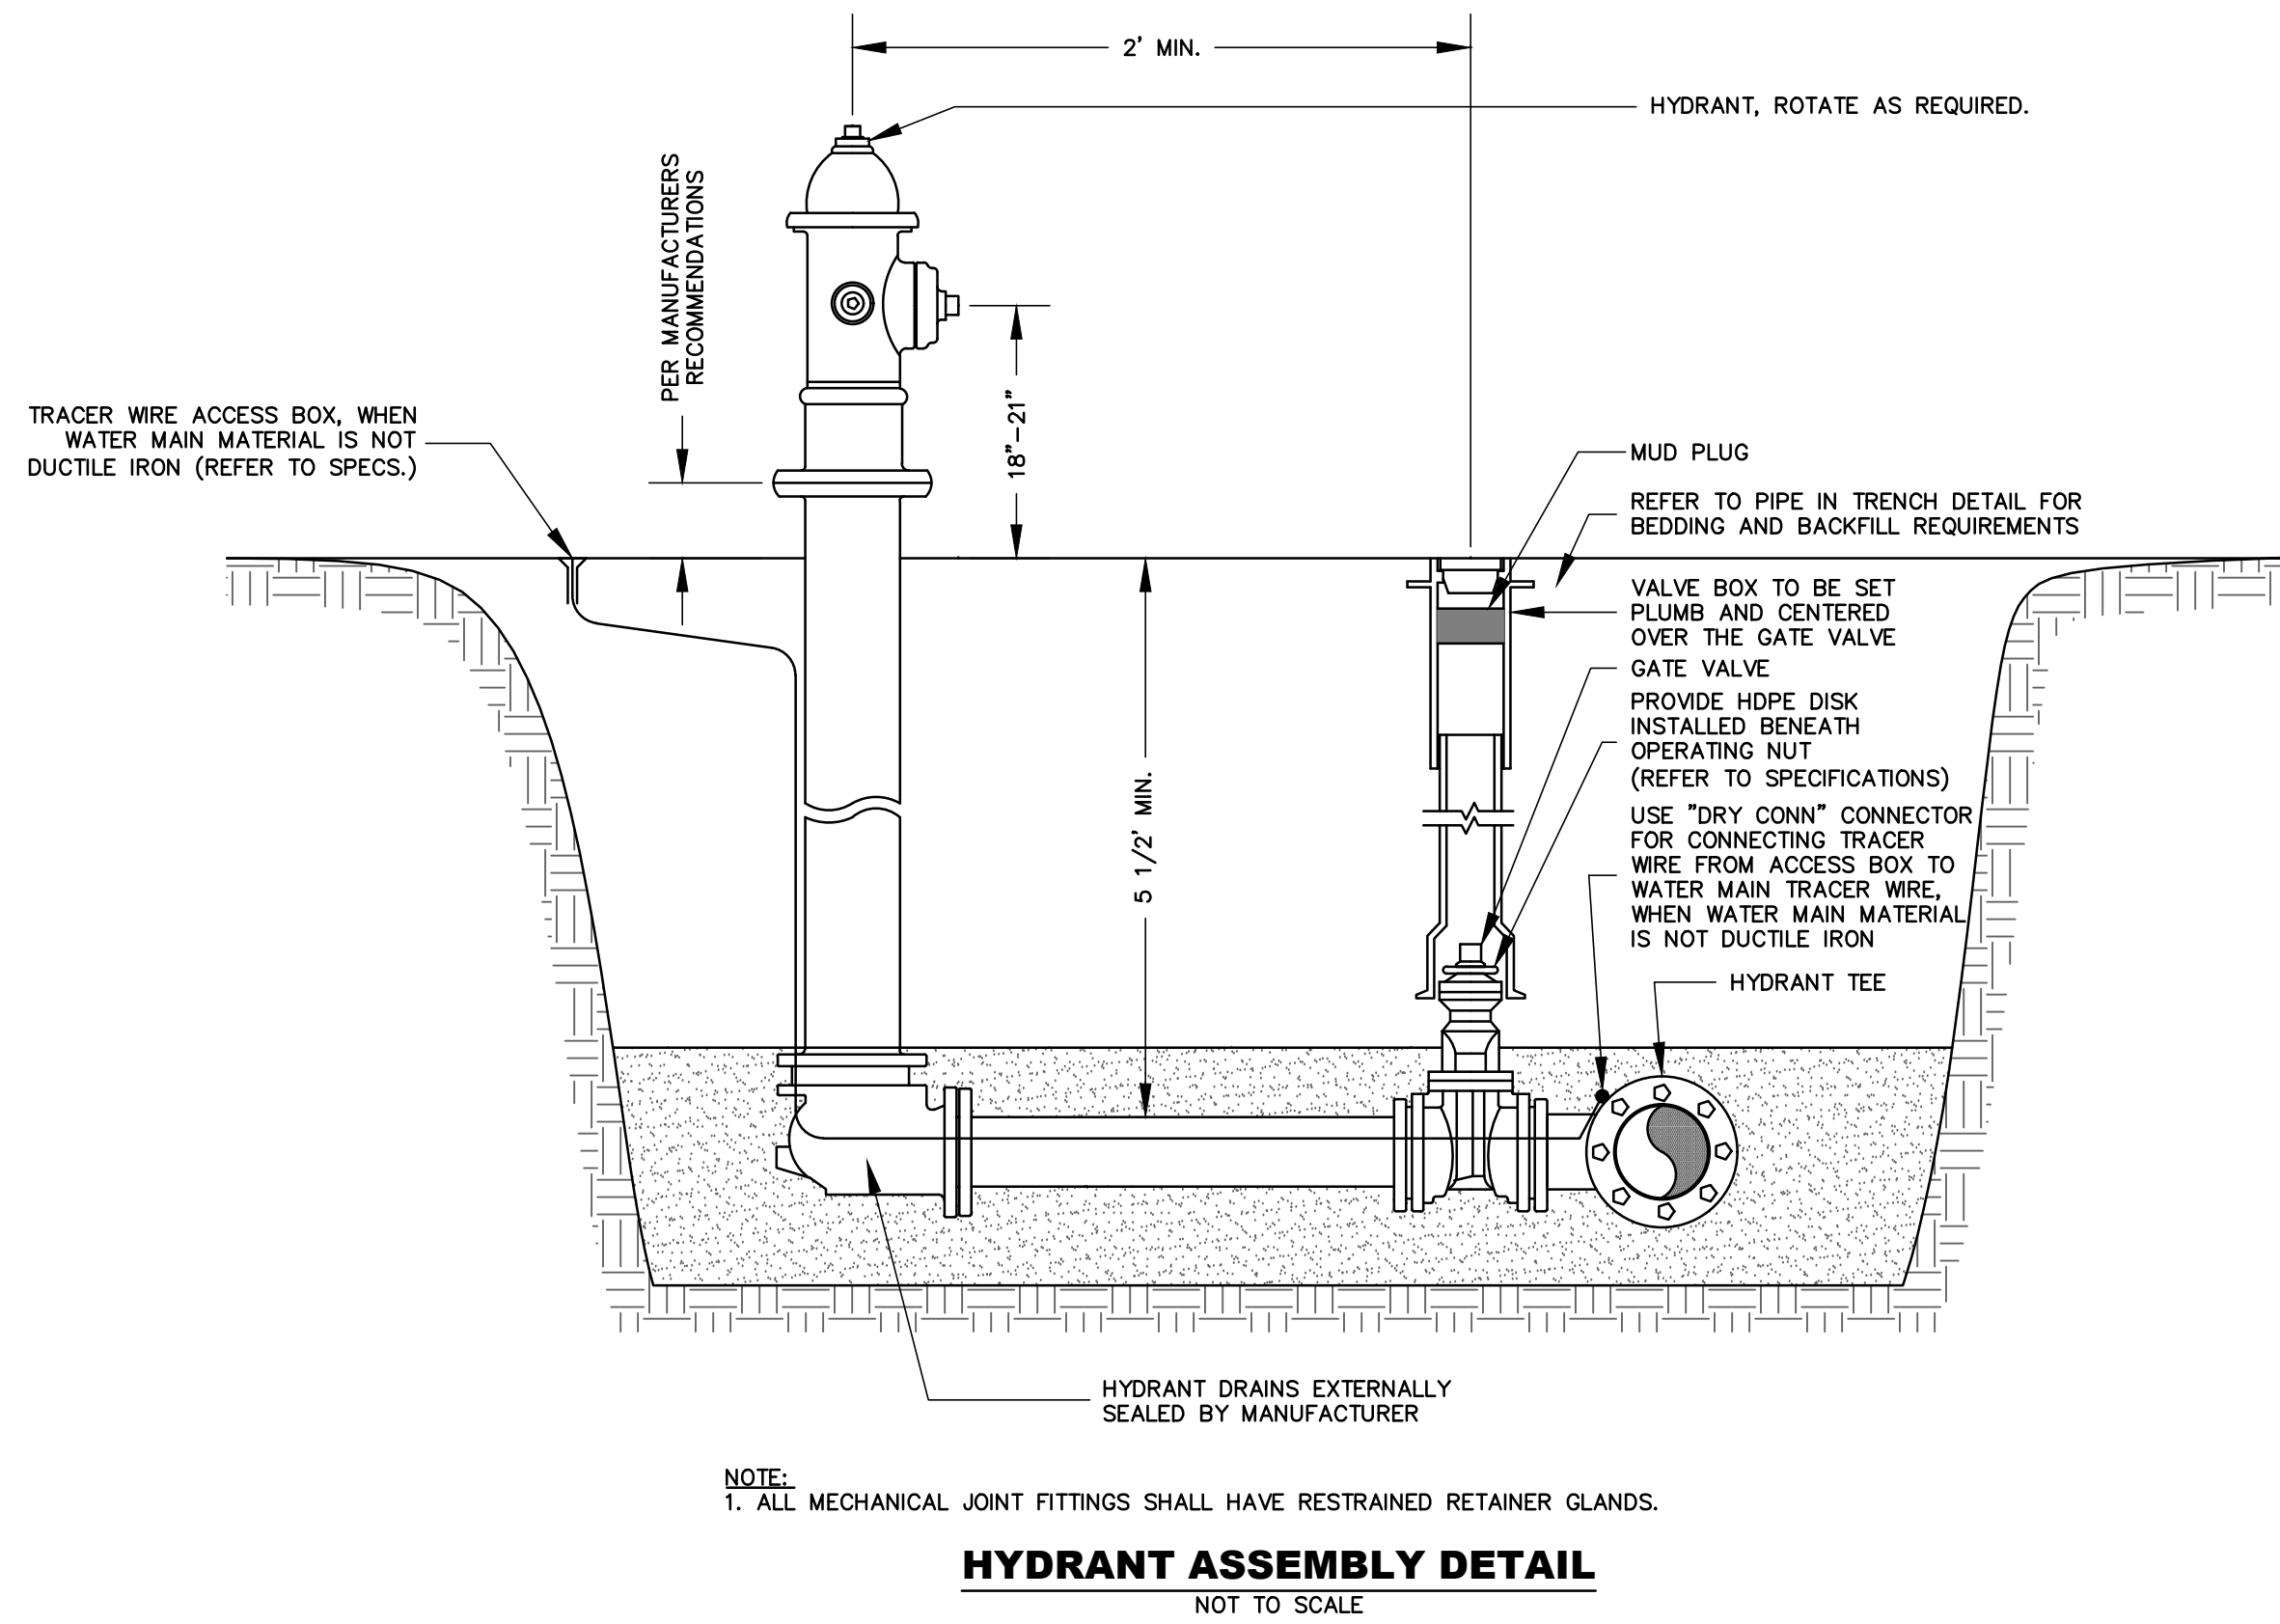


- NOTES:**
1. SHEET PILING MAY BE DRIVEN VERTICALLY FIVE (5) FEET OUTSIDE THE SHOULDER POINT, TO ALLOW FOR A SHORTER SLEEVE.
 2. EARTH BACKFILL TO BE MADE IN SIX (6) INCH LIFTS AND COMPACTED TO NOT LESS THAN 95% MAXIMUM DRY DENSITY.
 3. SEE PLANS FOR DETERMINING SLEEVE LENGTH.
 4. IN THE EVENT THAT PERMISSION IS GRANTED TO CUT EXISTING BITUMINOUS PAVEMENT, ALL CUTS, IF POSSIBLE, SHALL BE MADE WITH A SAW TO A MINIMUM DEPTH OF 1 1/2".
 5. SUB-BASE TO BE REPLACED IN KIND. MATERIAL BELOW SUB-GRADE TO BE REPLACED WITH EXCAVATED MATERIAL OR AS DIRECTED BY THE ENGINEER.
 6. SUB-BASE TO BE PLACED IN SIX (6) INCH COMPACTED LAYERS.

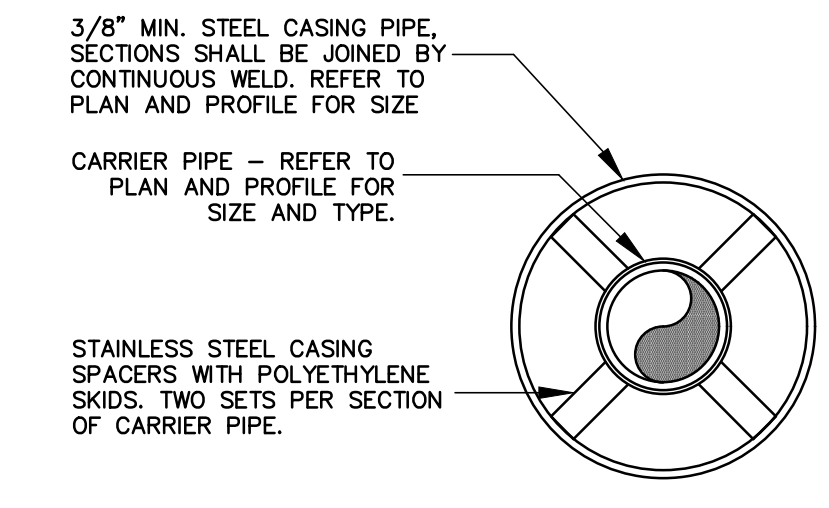

- NOTES:**
1. BOTH ENDS OF CASING PIPE SHALL BE SEALED WITH END SEALS WITH STAINLESS STEEL BAND CLAMPS.
 2. LIMITS OF BORING AND RECEIVING PIT SHALL BE NO LESS THAN 5' FROM THE POINT OF SHOULDER.

CASING AND CARRIER PIPE DETAIL
NOT TO SCALE

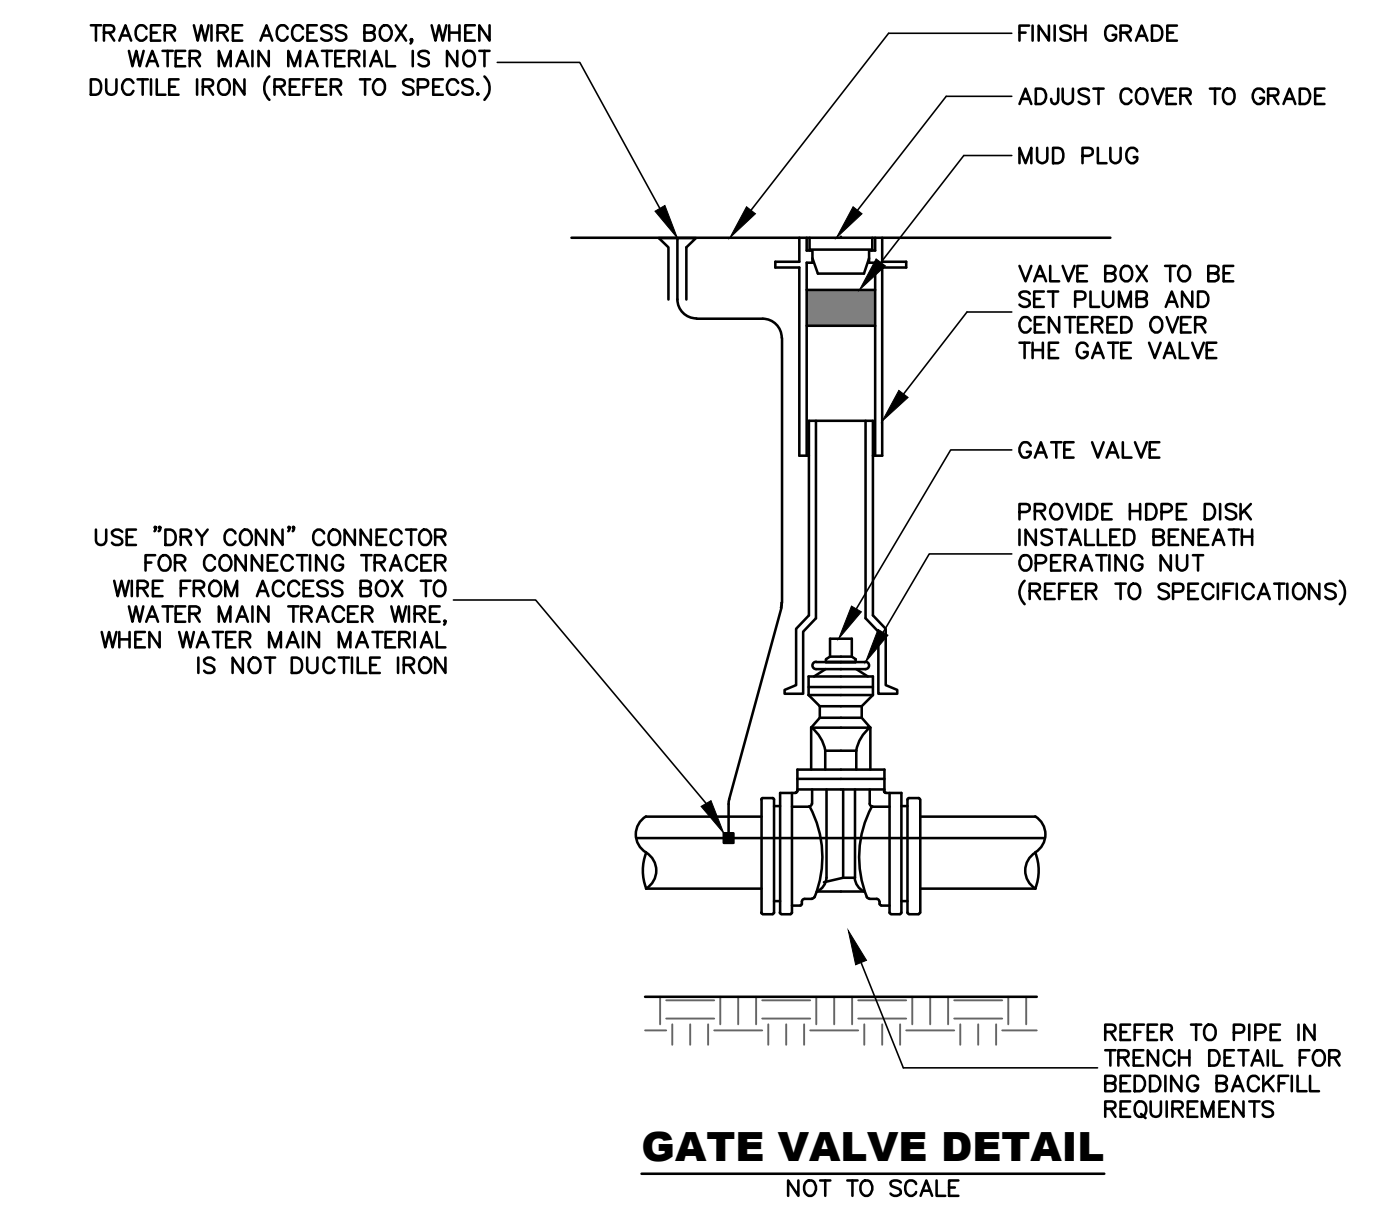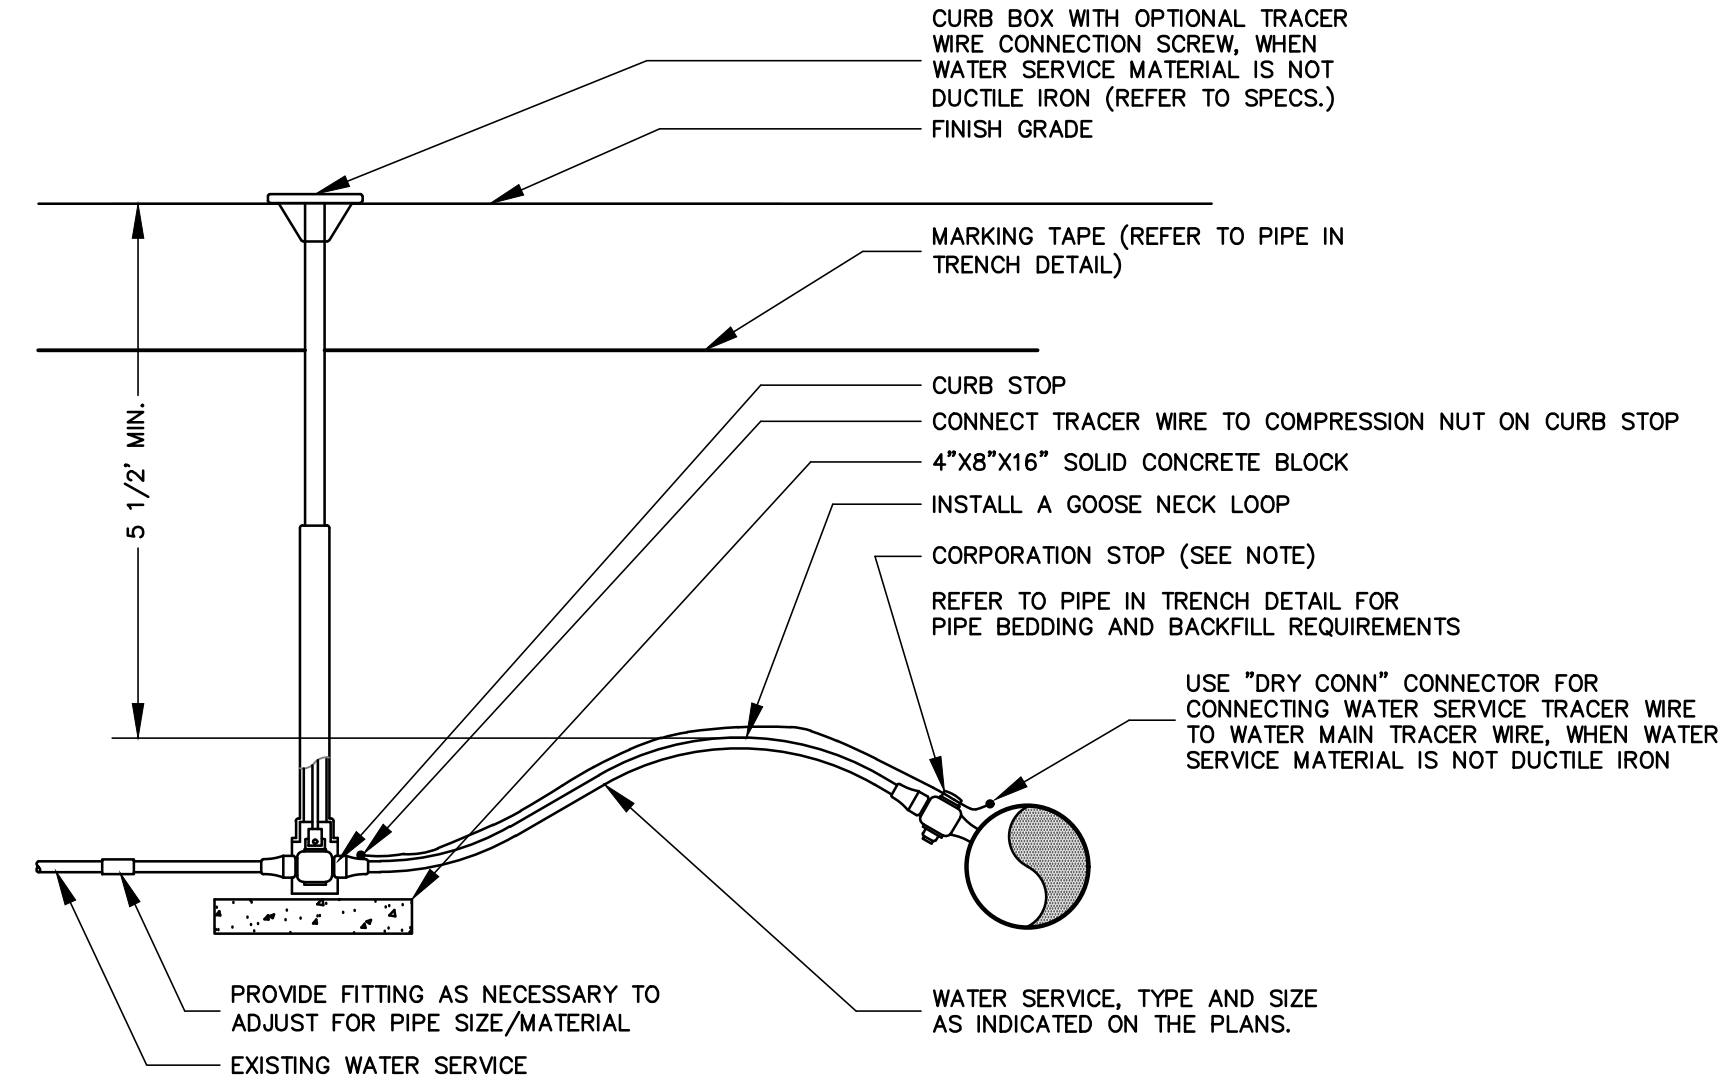

OTTER CREEK ENGINEERING
404 East Main Street
P.O. Box 712
East Middlebury, VT 05740
Telephone: 802-382-8522
Fax: 802-382-8640

110 Merchants Row
4th Floor, Suite 15
Rutland, VT 05701
Telephone: 802-747-3080
Fax: 802-747-4820
E-mail: info@ottercreek.com

STAMP AND SIGNATURE:
STATE OF VERMONT
ROBERT M. BERRY
LICENSED PROFESSIONAL ENGINEER
DESIGN ENGINEER

THESE DRAWINGS SHALL NOT BE ALTERED IN ANY WAY WITHOUT THE WRITTEN APPROVAL OF THE ENGINEER. ANY REVISIONS SHALL BE MADE BY THE ENGINEER AND NOTED IN THE REVISION BLOCK. © 2021
OTTER CREEK ENGINEERING, INC.

**TOWN OF BERLIN
PAINÉ TURNPIKE NORTH
WASTEWATER
IMPROVEMENTS
BERLIN, VERMONT**

RECORD

DATE ISSUED: 6/30/2021

REVISIONS:

DRAWN BY: RR
CHECKED BY: JK
SCALE: AS SHOWN
PROJECT NO.: 519.005
CADD FILE: 519-005 DETAILS
TITLE: DETAILS

DRAWING NO.
C-11

RECORD DRAWING

Record drawings have been prepared on the basis of information furnished by others. The engineer is not responsible for errors or omissions which have been incorporated into this document as a result. The location of items shown without labeled dimensions shall be considered as approximate. Profiles show general layout. Due to changes during construction, alignment, station and elevation information may not be correct. The site was not re-surveyed after construction, so "as-built" locations, elevations and finish grades are approximate and shall be considered "schematic". Details and cross sections may not reflect "as built" conditions.
Prepared by: Otter Creek Engineering, Inc., East Middlebury, Vermont.

DESCRIPTION	Ø	L (FEET)						
		3"	4"	6"	8"	10"	12"	16"
VERTICAL DOWN BEND	11 1/4"	5	5	7	9	11	13	16
	22 1/2"	9	10	14	19	22	26	31
	45"	19	21	29	38	46	55	64
VERTICAL UP BEND OR HORIZONTAL BEND	11 1/4"	2	2	2	3	4	4	5
	22 1/2"	3	3	5	6	7	8	10
	45"	6	6	9	12	14	16	21
	90°	14	15	21	27	32	38	50
SIZE		L (BRANCH) (FEET)		L (RUN) (FEET)				
4" x 4"		1		10				
6" x 4"		1		10				
6" x 6"		1		10				
8" x 4"		1		10				
8" x 6"		1		10				
8" x 8"		1		10				
10" x 4"		1		10				
10" x 6"		1		10				
10" x 8"		1		10				
10" x 10"		11		10				
12" x 4"		1		10				
12" x 6"		1		10				
12" x 8"		1		10				
12" x 10"		1		10				
12" x 12"		28		10				
16" x 4"		1		10				
16" x 6"		1		10				
16" x 8"		1		10				
16" x 10"		1		10				
16" x 12"		1		10				
16" x 16"		61		10				
SIZE		L (FEET)						
4" x 3"		14						
6" x 3"		39						
6" x 4"		30						
8" x 4"		56						
8" x 6"		33						
10" x 4"		76						
10" x 6"		57						
10" x 8"		32						
12" x 4"		96						
12" x 6"		81						
12" x 8"		59						
12" x 10"		33						
16" x 6"		122						
16" x 8"		105						
16" x 10"		86						
16" x 12"		62						
24" x 12"		155						
SIZE		L (FEET)						
3"		38						
4"		41						
6"		59						
8"		77						
10"		93						
12"		111						
16"		144						
24"		209						
SIZE		L (FEET)						
3"		40						
4"		40						
6"		40						
8"		40						
10"		60						
12"		60						
16"		80						
24"		100						

NOTES:
 RESTRAINED PIPE AND FITTING JOINTS SHALL BE PROVIDED FOR ALL PIPE AND FITTING JOINTS WITHIN THE REQUIRED MINIMUM LENGTH (L) OF PIPE, EACH SIDE OF THE FITTING.
 FOR FIELD CONDITIONS DIFFERENT FROM THOSE LISTED IN TABLE, RESTRAINED JOINT REQUIREMENTS SHALL BE ASSESSED.

RESTRAINED PVC PIPE JOINT DETAIL (200 psi)
 NOT TO SCALE



RECORD DRAWING

Record drawings have been prepared on the basis of information furnished by others. The engineer is not responsible for errors or omissions which have been incorporated into this document as a result. The location of items shown without labeled dimensions shall be considered as approximate. Profiles show general layout. Due to changes during construction, alignment, station and elevation information may not be correct. The site was not re-surveyed after construction, so "as-built" locations, elevations and finish grades are approximate and shall be considered "schematic". Details and cross sections may not reflect "as built" conditions.
 Prepared by: Otter Creek Engineering, Inc., East Middlebury, Vermont.

AREA OF BEARING FACE OF CONCRETE THRUST BLOCKS (IN SQUARE FEET)

PIPE SIZE (INCHES)	SOFT WET CLAY, SAND OR SILT (1000 PSF)		DRY SAND (3000 PSF)		COMPACT SAND, COARSE GRAVEL OR HARDPAN (5000 PSF)	
	HORIZONTAL CAP OR TEE		HORIZONTAL 90° BEND		HORIZONTAL 45° BEND	
8 OR LESS	20 SF	7 SF	4 SF	4 SF	4 SF	4 SF
10	29	10	6	6	6	6
12	41	14	8	8	8	8
16	60	20	12	12	12	12
8 OR LESS	27 SF	9 SF	6 SF	6 SF	6 SF	6 SF
10	41	14	8	8	8	8
12	58	19	12	12	12	12
16	85	28	17	17	17	17
8 OR LESS	15 SF	5 SF	3 SF	3 SF	3 SF	3 SF
10	22	7	5	5	5	5
12	31	11	6	6	6	6
16	46	15	9	9	9	9
8 OR LESS	8	3	2	2	2	2
10	11	4	2	2	2	2
12	16	5	3	3	3	3
16	23	8	5	5	5	5
REDUCER						
8 X 6	8 SF	7 SF	3 SF	3 SF	3 SF	3 SF
10 X 8	11	7	5	5	5	5
12 X 8	16	11	6	6	6	6
12 X 10	24	14	8	8	8	8
16 X 12	27	16	10	10	10	10

NOTE: BEARING SURFACE AREAS CALCULATED ASSUMING A MAXIMUM WORKING PRESSURE OF 150 PSI AND A 2:1 SAFETY FACTOR FOR SURGE

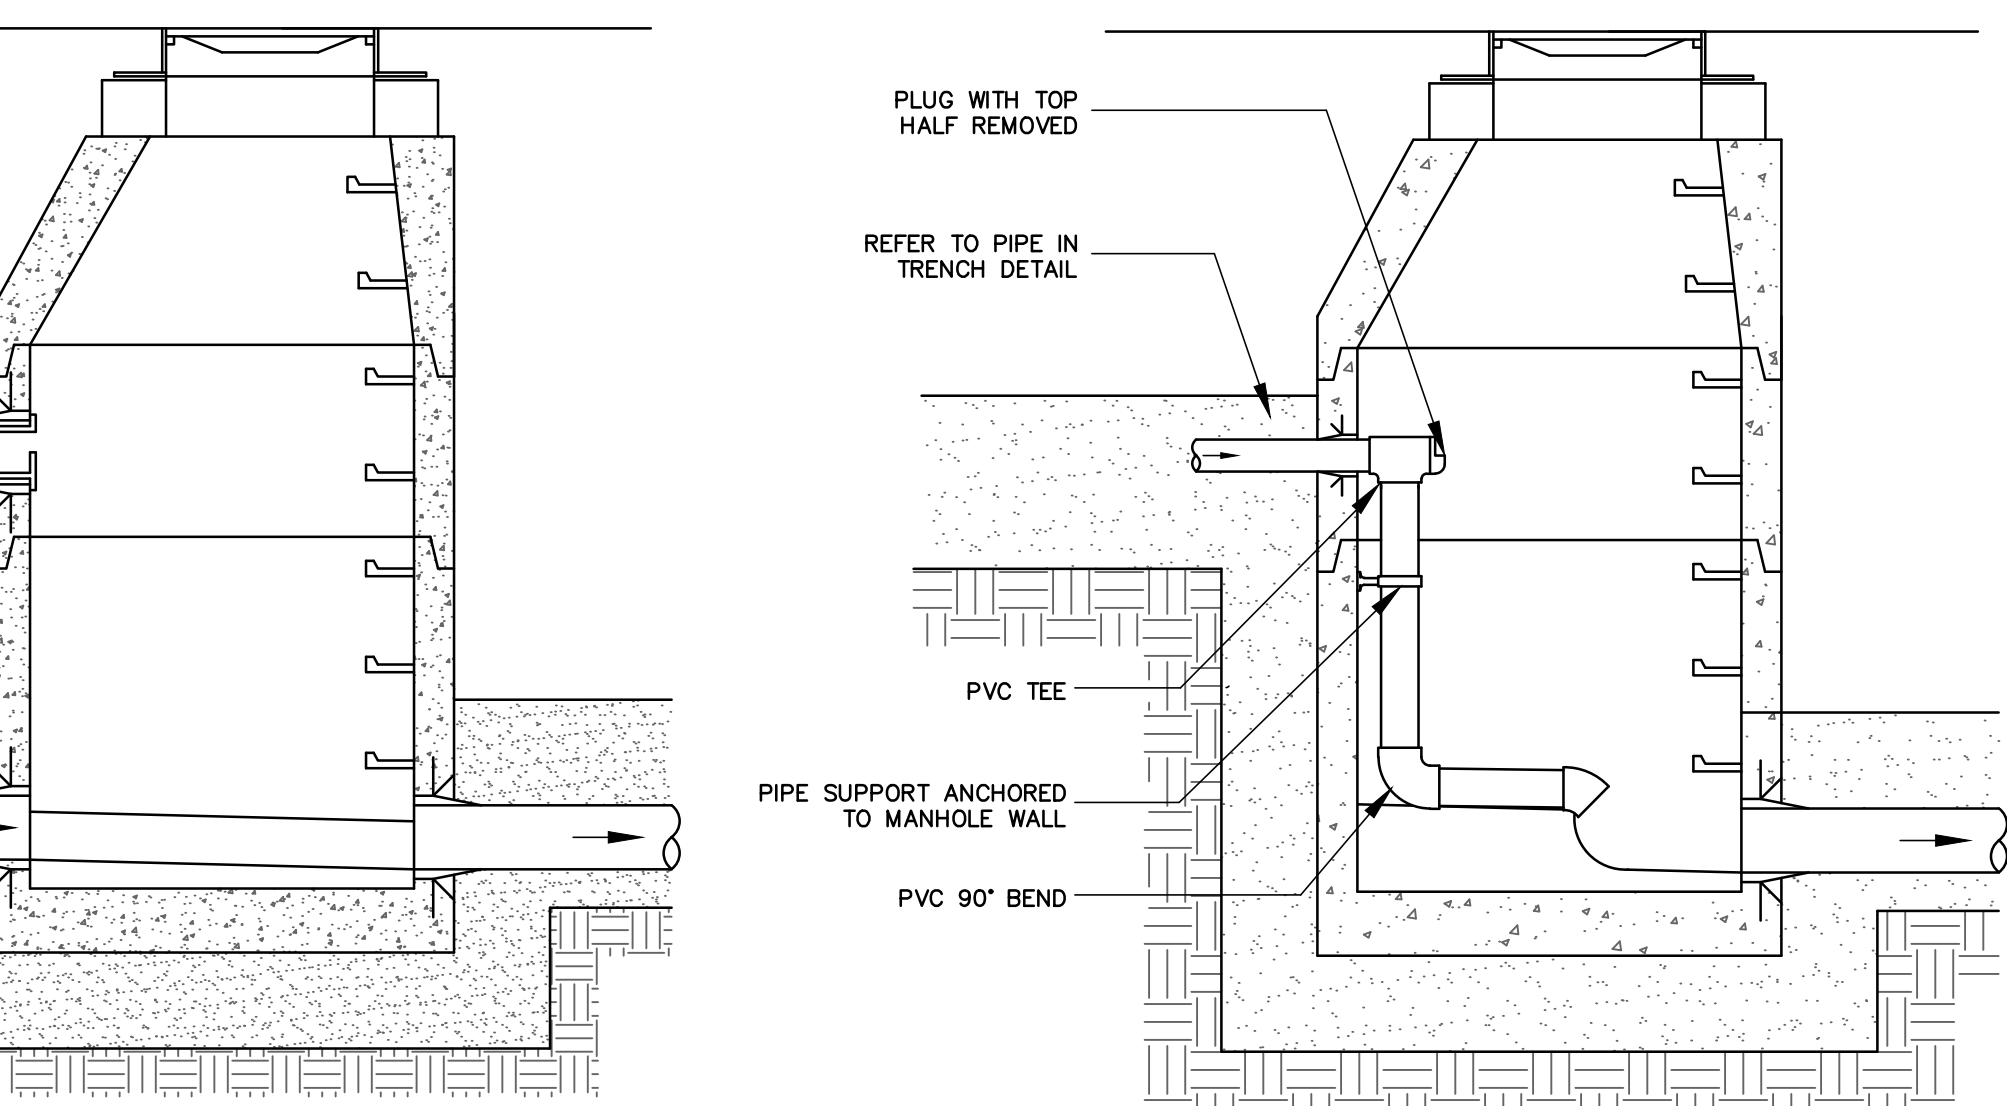
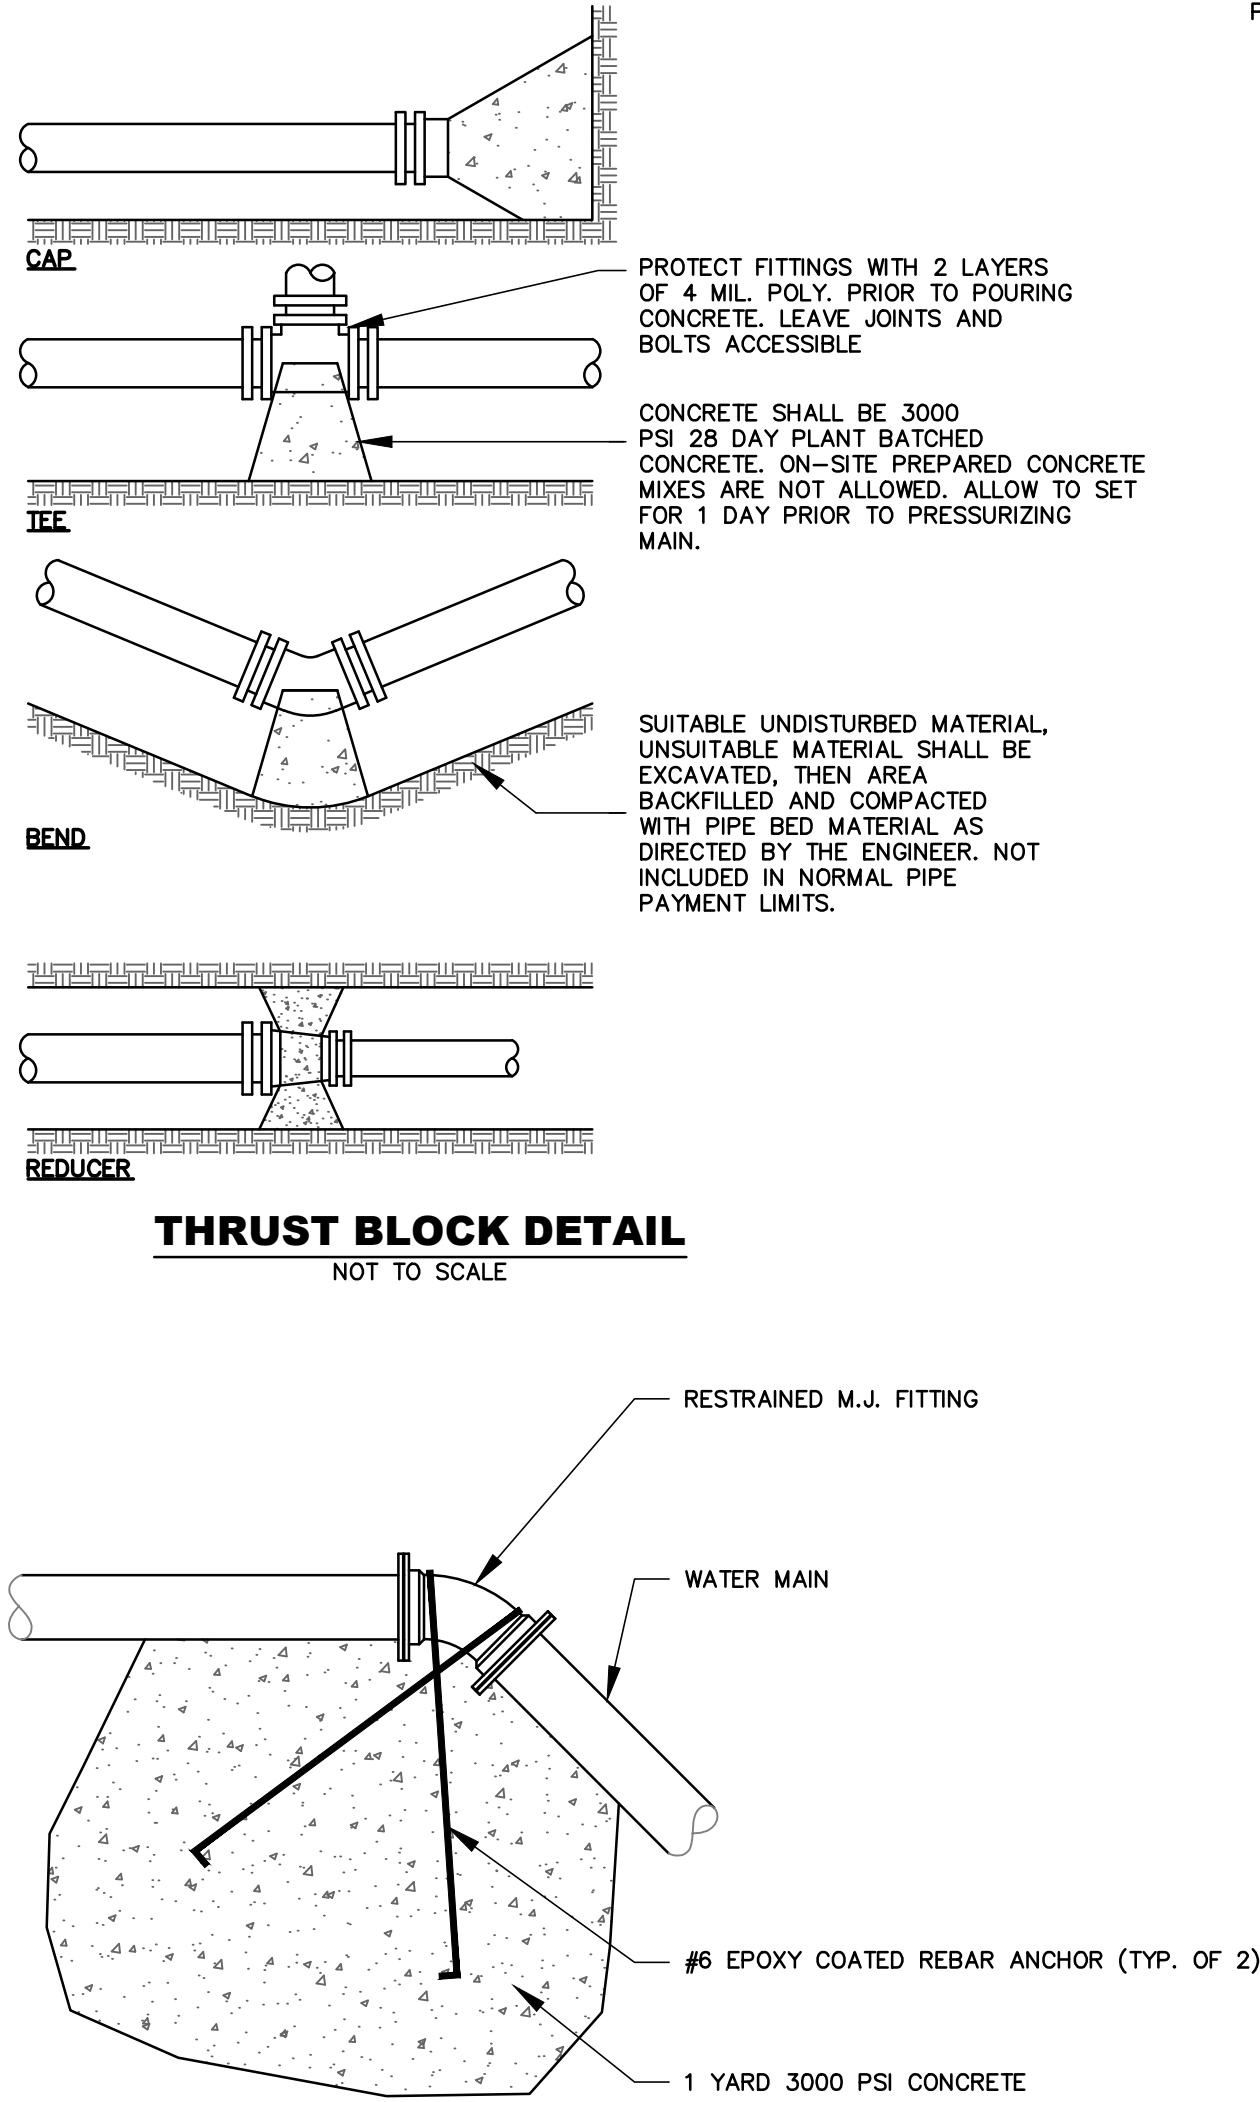


NOTES:
 REFER TO "SEWER MANHOLE DETAIL" FOR NOTES AND DETAILS. THIS DETAIL COVERS ONLY THE EXTERNAL DROP PORTION OF THE MANHOLE.


NOTES:
 REFER TO "SEWER MANHOLE DETAIL" FOR NOTES AND DETAILS. THIS DETAIL COVERS ONLY THE INTERNAL DROP PORTION OF THE MANHOLE.

EXTERNAL DROP MANHOLE
 NOT TO SCALE

INTERNAL DROP MANHOLE
 NOT TO SCALE

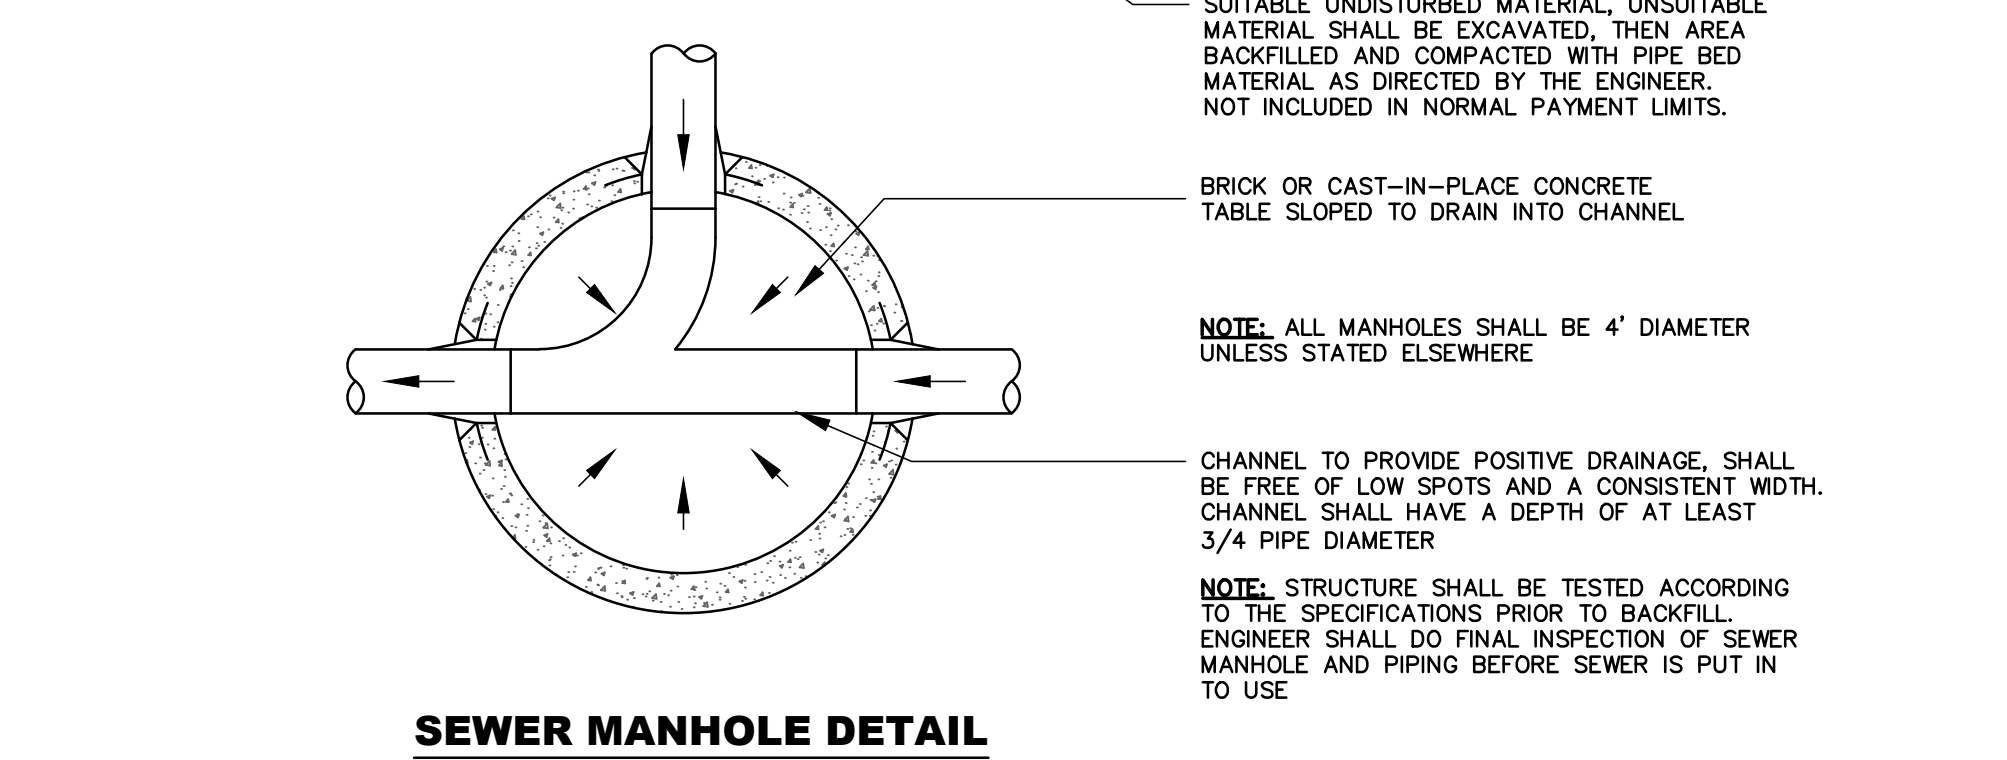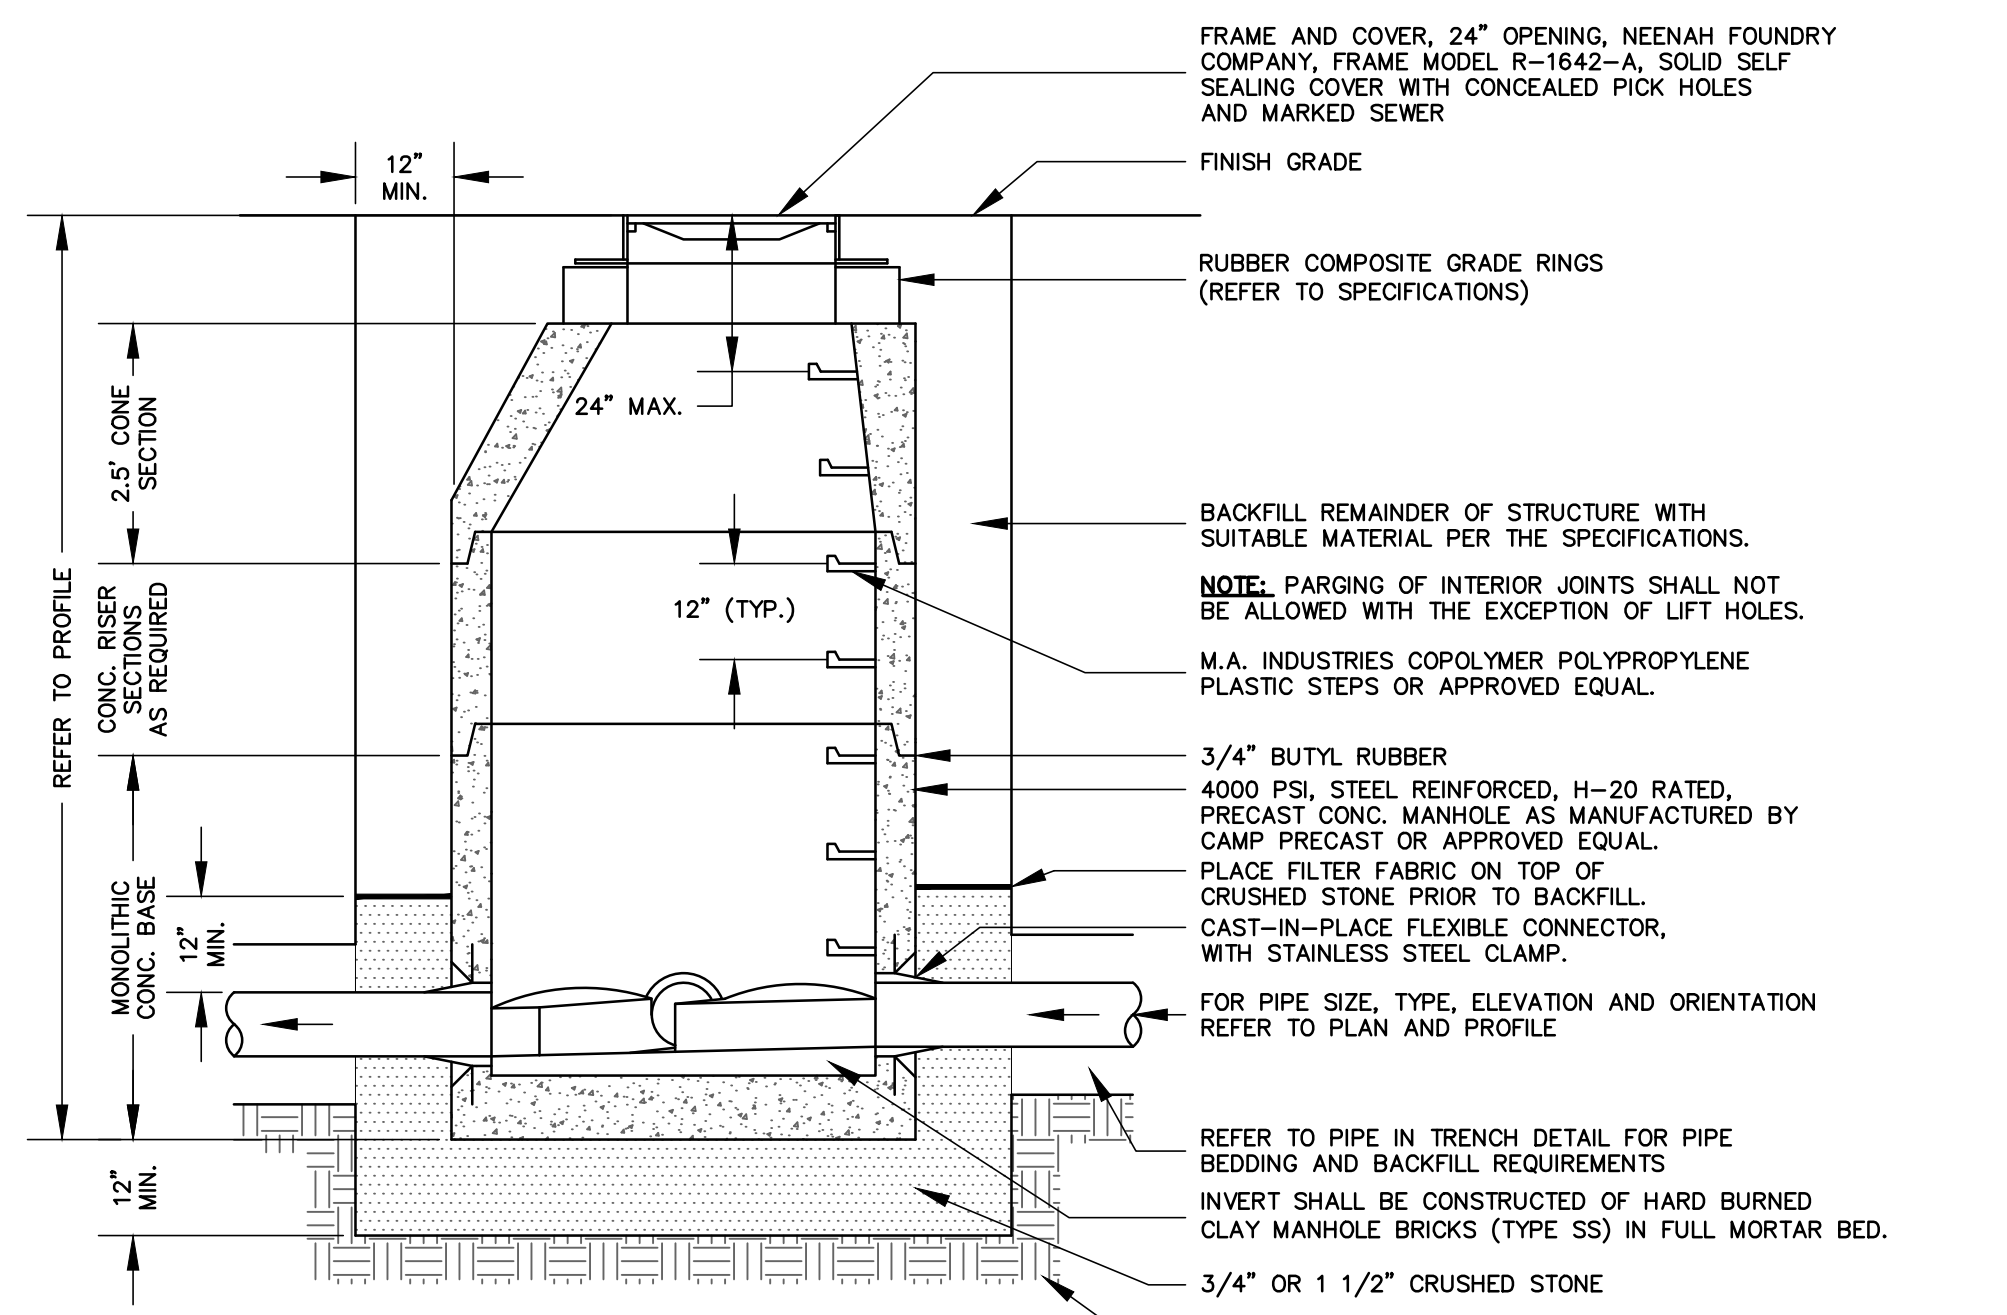

SEWER MANHOLE DETAIL
 NOT TO SCALE

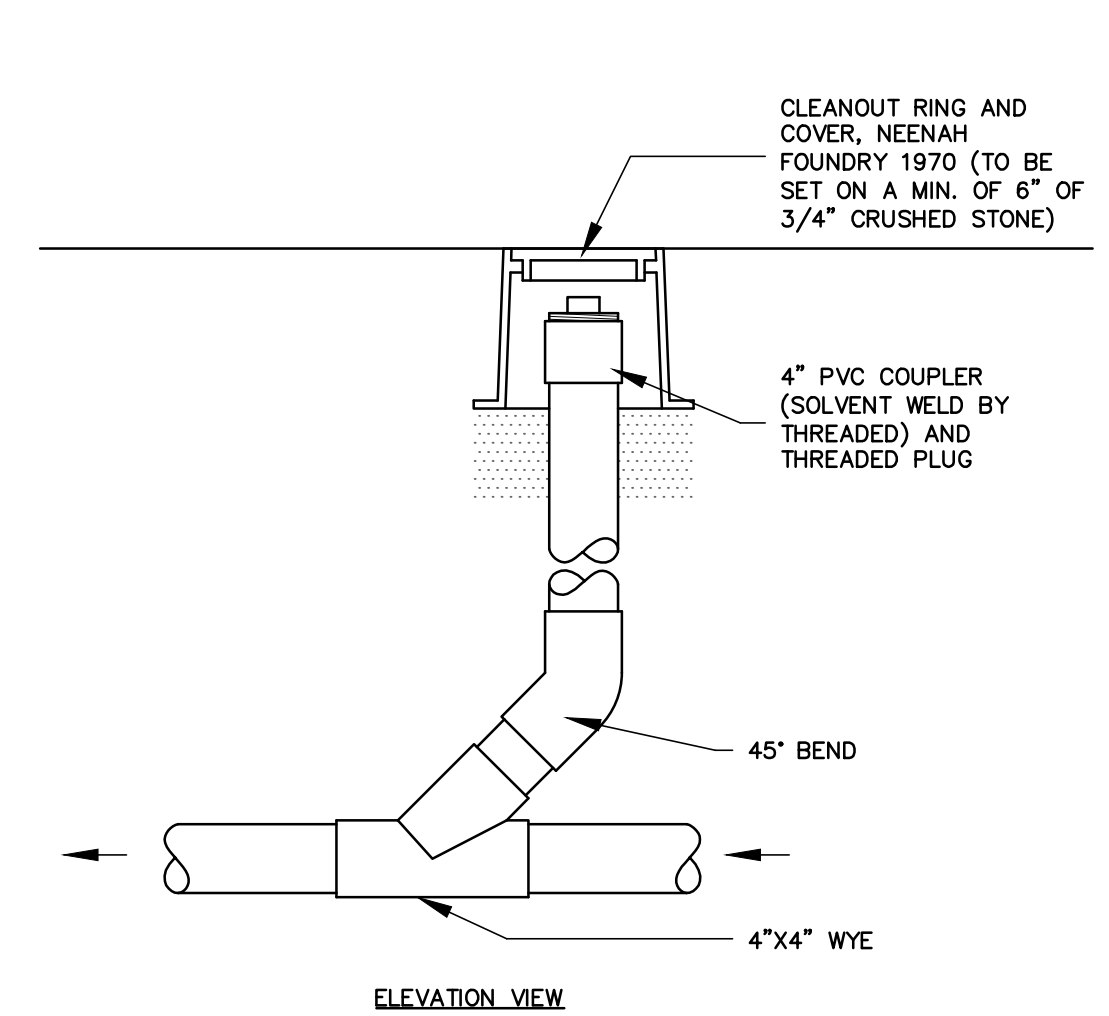

IN-LINE CLEANOUT DETAIL
 NOT TO SCALE

NOTES:
 1. REFER TO PIPE IN TRENCH DETAIL FOR BEDDING AND BACKFILL MATERIAL.
 2. CONTRACTOR TO INSTALL CLEANOUTS ON EACH NEW SEWER SERVICE AT THE RIGHT-OF-WAY (ROW) LINE.
 3. CLEANOUT SIZE IS BASED ON THE SIZE OF SEWER SERVICE.



SEWER LATERAL CONNECTION DETAIL
 NOT TO SCALE

NOTES:
 1. REFER TO SITE PLANS AND PROFILES FOR PIPE SIZE AND TYPE.
 2. REFER TO PIPE IN TRENCH DETAIL FOR BEDDING AND BACKFILL REQUIREMENTS.

STAMP AND SIGNATURE:

 DESIGN ENGINEER

THESE DRAWINGS SHALL NOT BE ALTERED IN ANY WAY WITHOUT THE WRITTEN APPROVAL OF THE ENGINEER. ANY REVISIONS SHALL BE MADE BY THE ENGINEER AND NOTED IN THE REVISION BLOCK. © 2021
 OTTER CREEK ENGINEERING, INC.

TOWN OF BERLIN
PAINÉ TURNPIKE NORTH WASTEWATER IMPROVEMENTS
BERLIN, VERMONT

RECORD
 DATE ISSUED: 6/30/2021
 REVISIONS:
 DRAWN BY: RR
 CHECKED BY: JK
 SCALE: AS SHOWN
 PROJECT NO.: 519-005
 CADD FILE: 519-005 DETAILS
 TITLE: DETAILS AND NOTES
 DRAWING NO.: **C-12**




OTTER CREEK
ENGINEERING

404 East Main Street
P.O. Box 712
East Middlebury, VT 05740
Telephone: 802-382-8522
Fax: 802-382-8640

110 Merchants Row
4th Floor, Suite 15
Rutland, VT 05701
Telephone: 802-747-3080
Fax: 802-747-4820
E-mail: info@ottercrk.com

STAMP AND SIGNATURE:

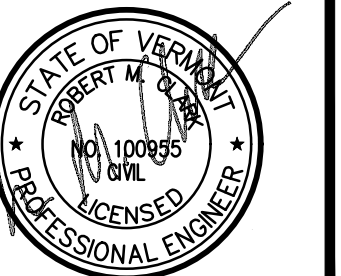

DESIGN ENGINEER

THESE DRAWINGS SHALL NOT
BE ALTERED IN ANY WAY
WITHOUT THE WRITTEN
APPROVAL OF THE ENGINEER.
ANY REVISIONS SHALL BE
MADE BY THE ENGINEER AND
NOTED IN THE REVISION
BLOCK. © 2021

OTTER CREEK ENGINEERING, INC.

TOWN OF BERLIN
PAINÉ TURNPIKE NORTH
WASTEWATER
IMPROVEMENTS
BERLIN, VERMONT

RECORD

DATE ISSUED: 6/30/2021

REVISIONS:

DRAWN BY: RR

CHECKED BY: JK

SCALE: AS SHOWN

PROJECT NO.: 519.005


CADD FILE: 519-005 DETAILS

TITLE:

DETAILS
AND NOTES

DRAWING NO.


C-13

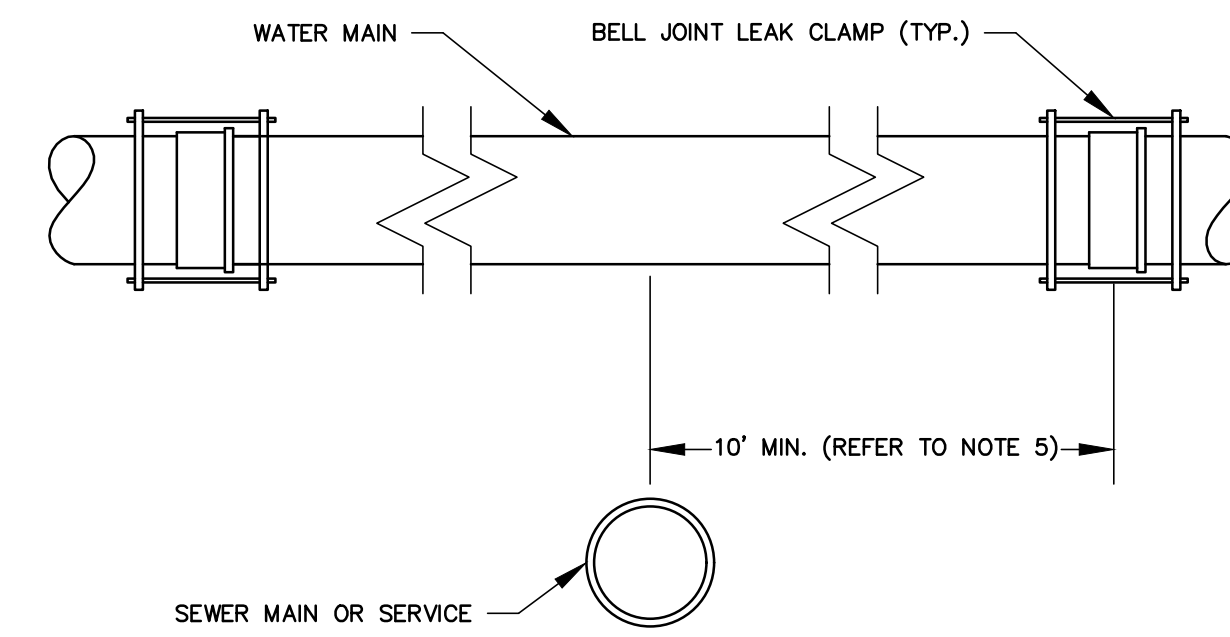

WATER / SEWER CROSSING DETAIL


NOT TO SCALE

1. WATER MAINS CROSSING OVER SEWER MAINS OR SERVICES SHALL HAVE A MINIMUM VERTICAL CLEARANCE OF 18 INCHES.
2. WATER AND SEWER PIPE JOINTS SHALL BE LOCATED AS FAR APART AS POSSIBLE.
3. PROVIDE STRUCTURAL SUPPORT FOR EXPOSED WATER AND SEWER PIPES.
4. FOR PARALLEL INSTALLATION, THERE SHALL BE A HORIZONTAL SEPARATION OF 10 FEET BETWEEN WATER MAINS AND SANITARY SEWER, AND A SEPARATION OF 5 FT BETWEEN WATER MAINS AND STORM SEWERS.
5. IN THE EVENT 18 INCHES OF VERTICAL CLEARANCE (WATER OVER SEWER) OR 10' OF HORIZONTAL SEPARATION CANNOT BE ACHIEVED OR IN ALL CASES WHERE SEWER IS OVER WATER (REGARDLESS OF VERTICAL SEPARATION), CONTRACTOR SHALL INSTALL BELL JOINT LEAK CLAMPS, AT EACH WATER MAIN BELL JOINT. REFER TO SPECIFICATIONS.

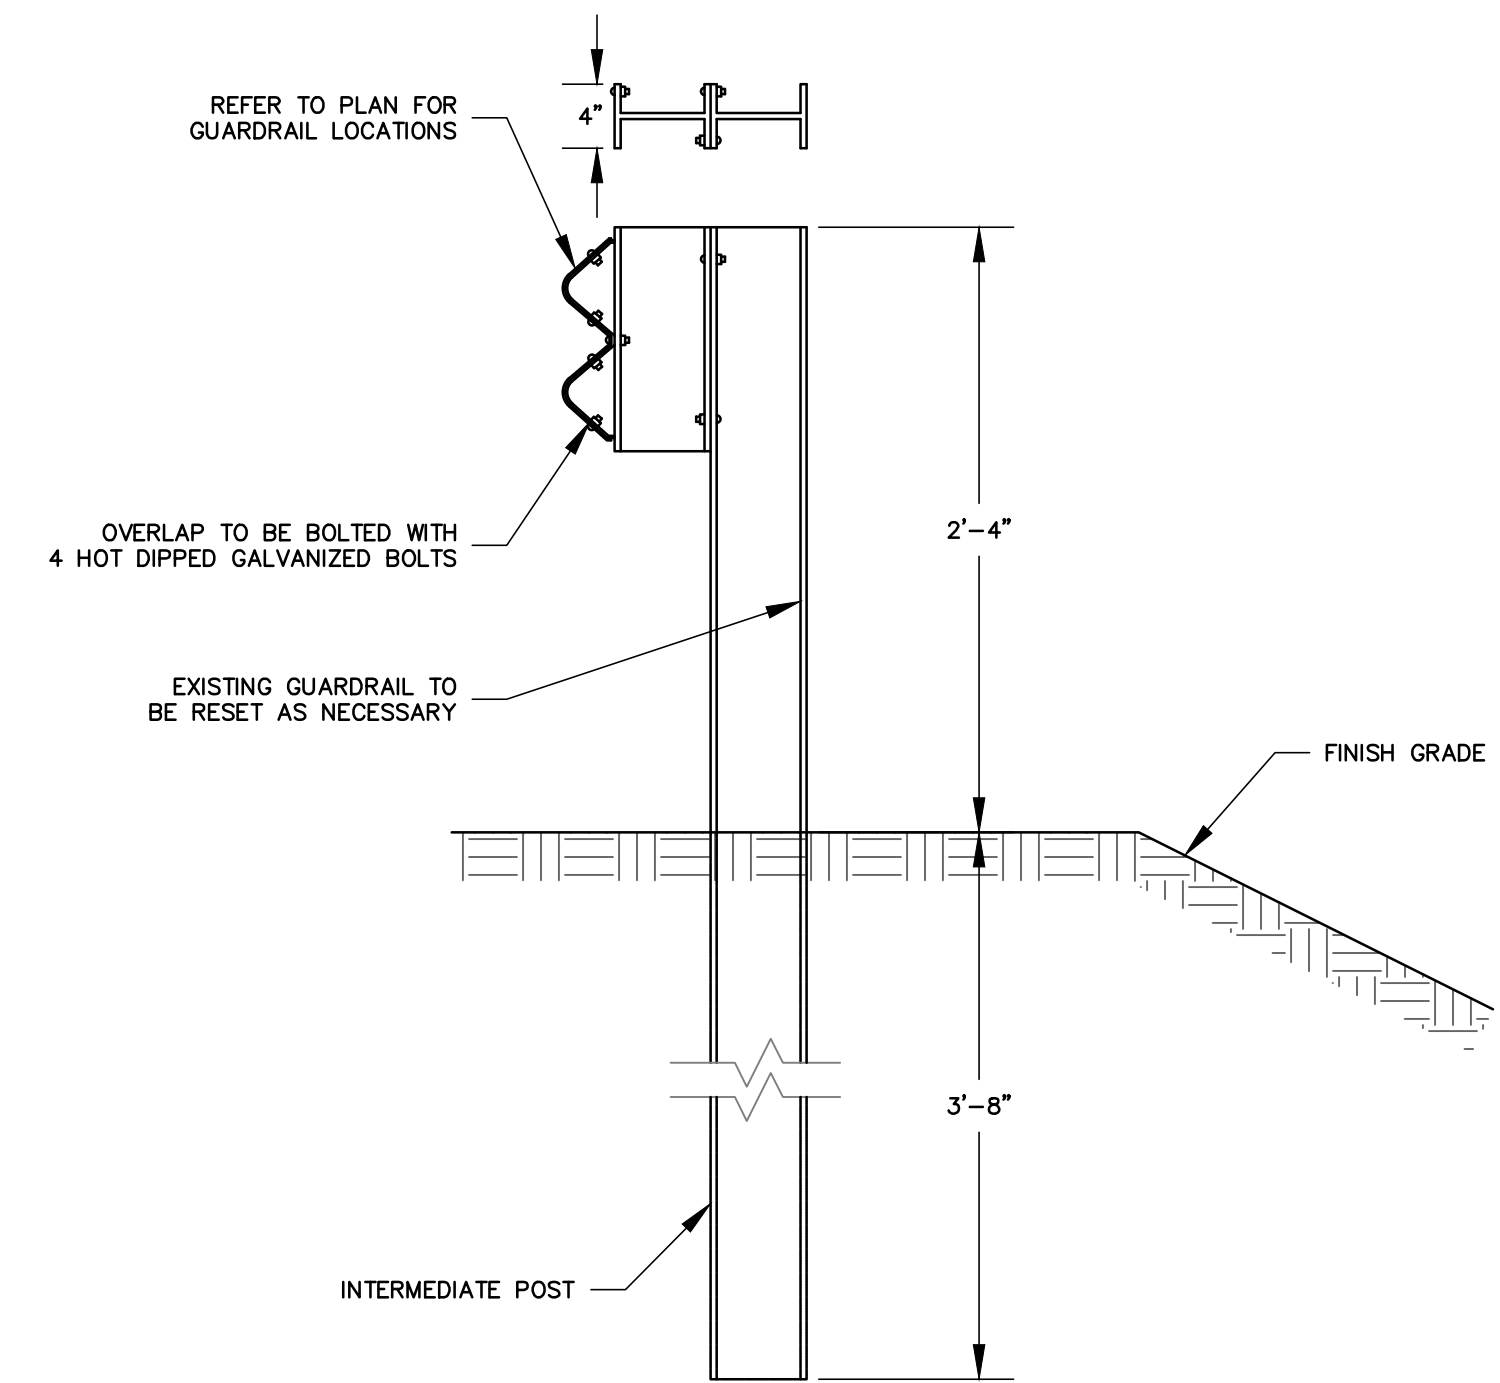


GUARDRAIL DETAIL

NOT TO SCALE

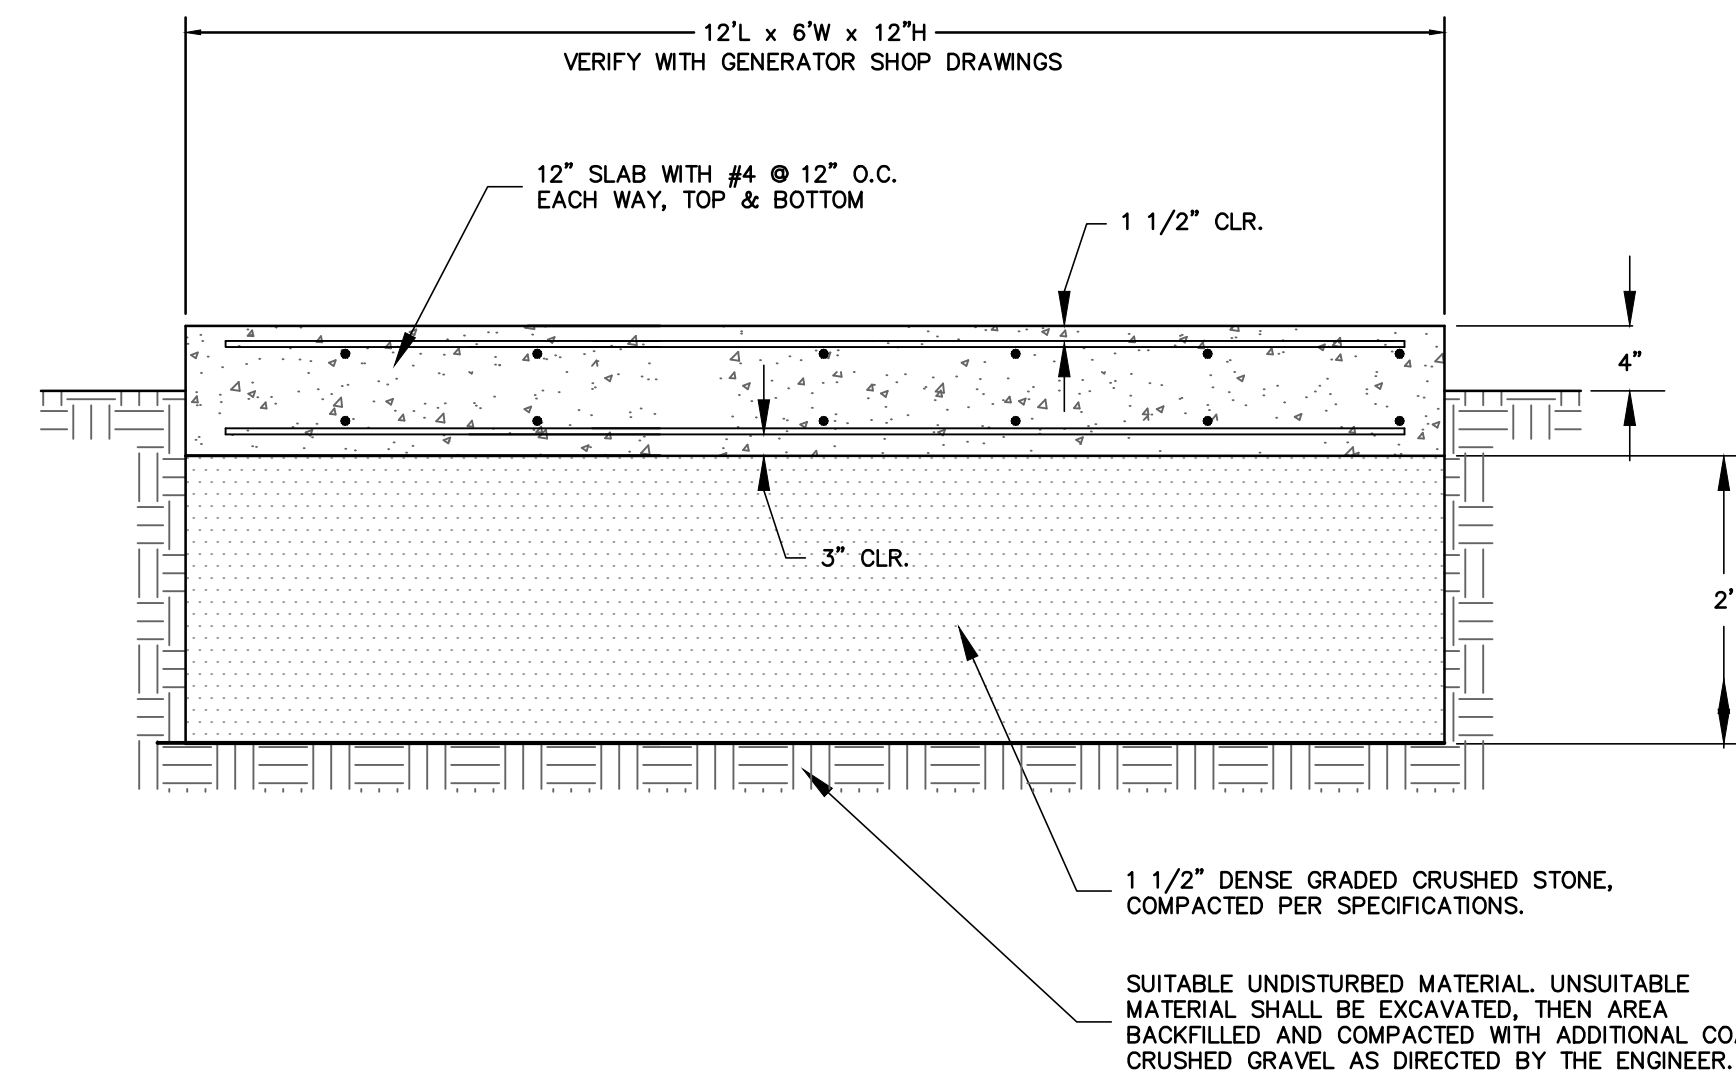

EMERGENCY GENERATOR PAD

NOT TO SCALE

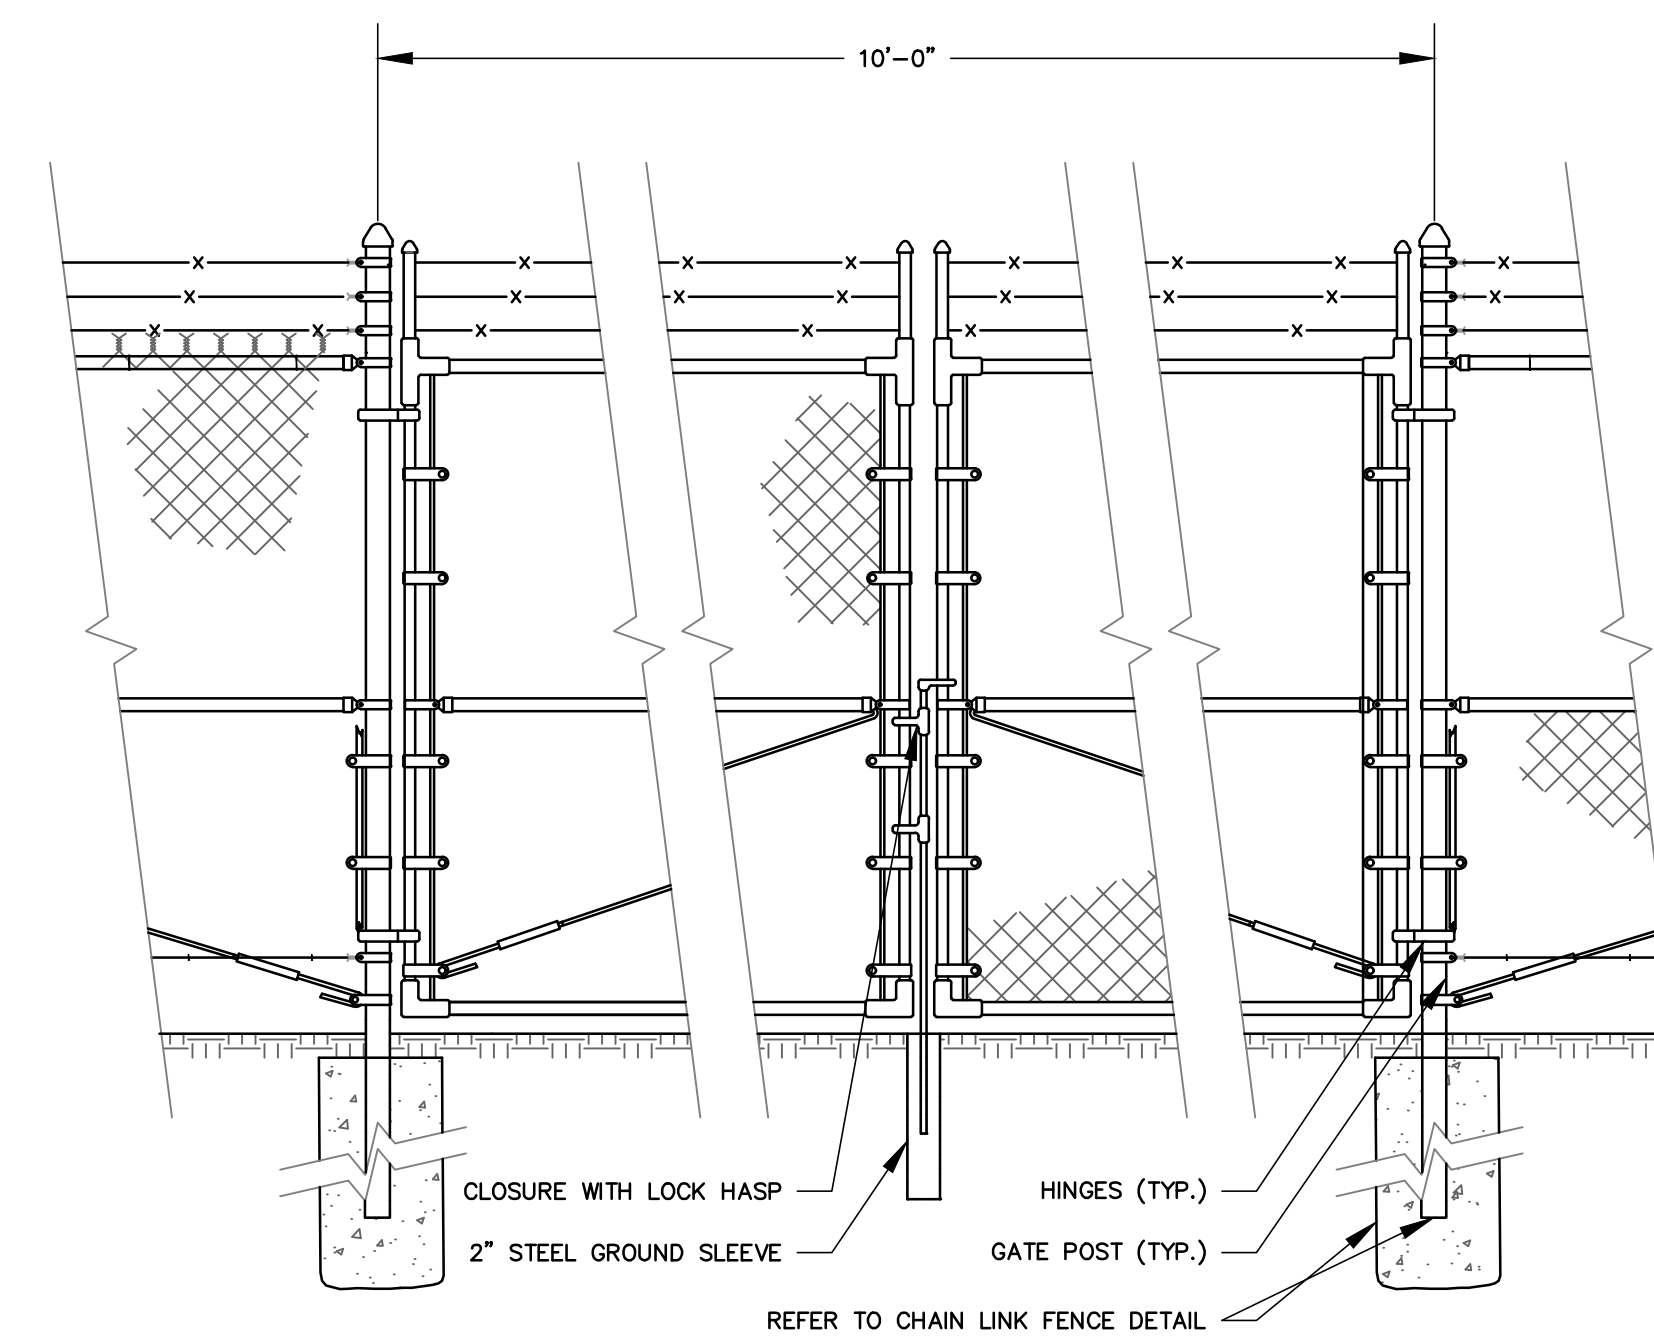


NOTES:

1. GATE POSTS TO BE 4" O.D.
2. PROVIDE LOCKING GATE ACCESS AS SHOWN ON SITE PLAN.


GATE DETAIL

NOT TO SCALE

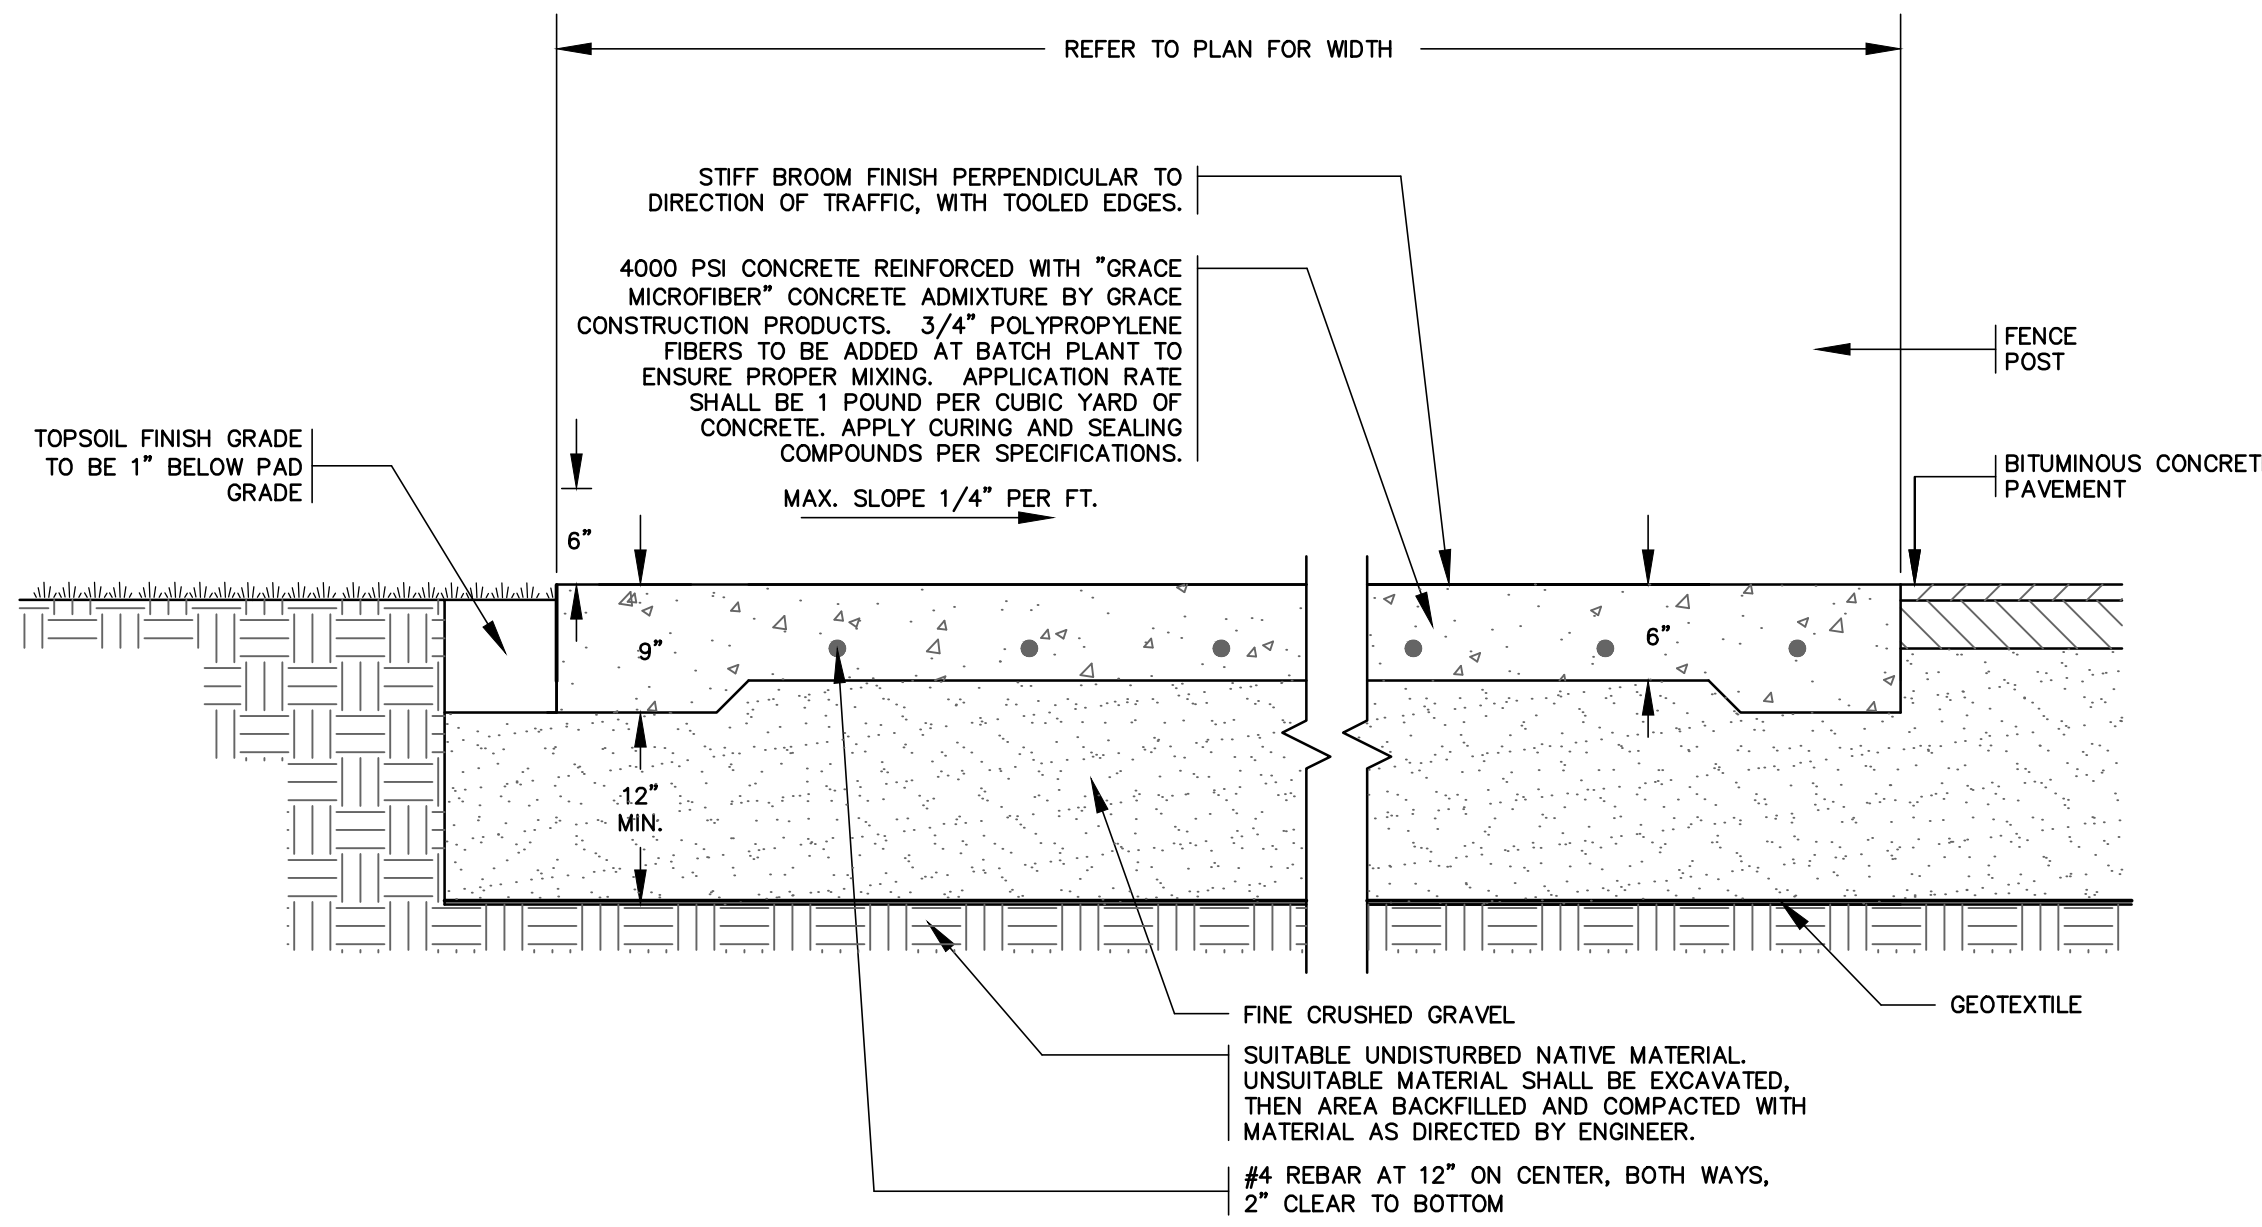

CONCRETE DUMPSTER PAD DETAIL

NOT TO SCALE

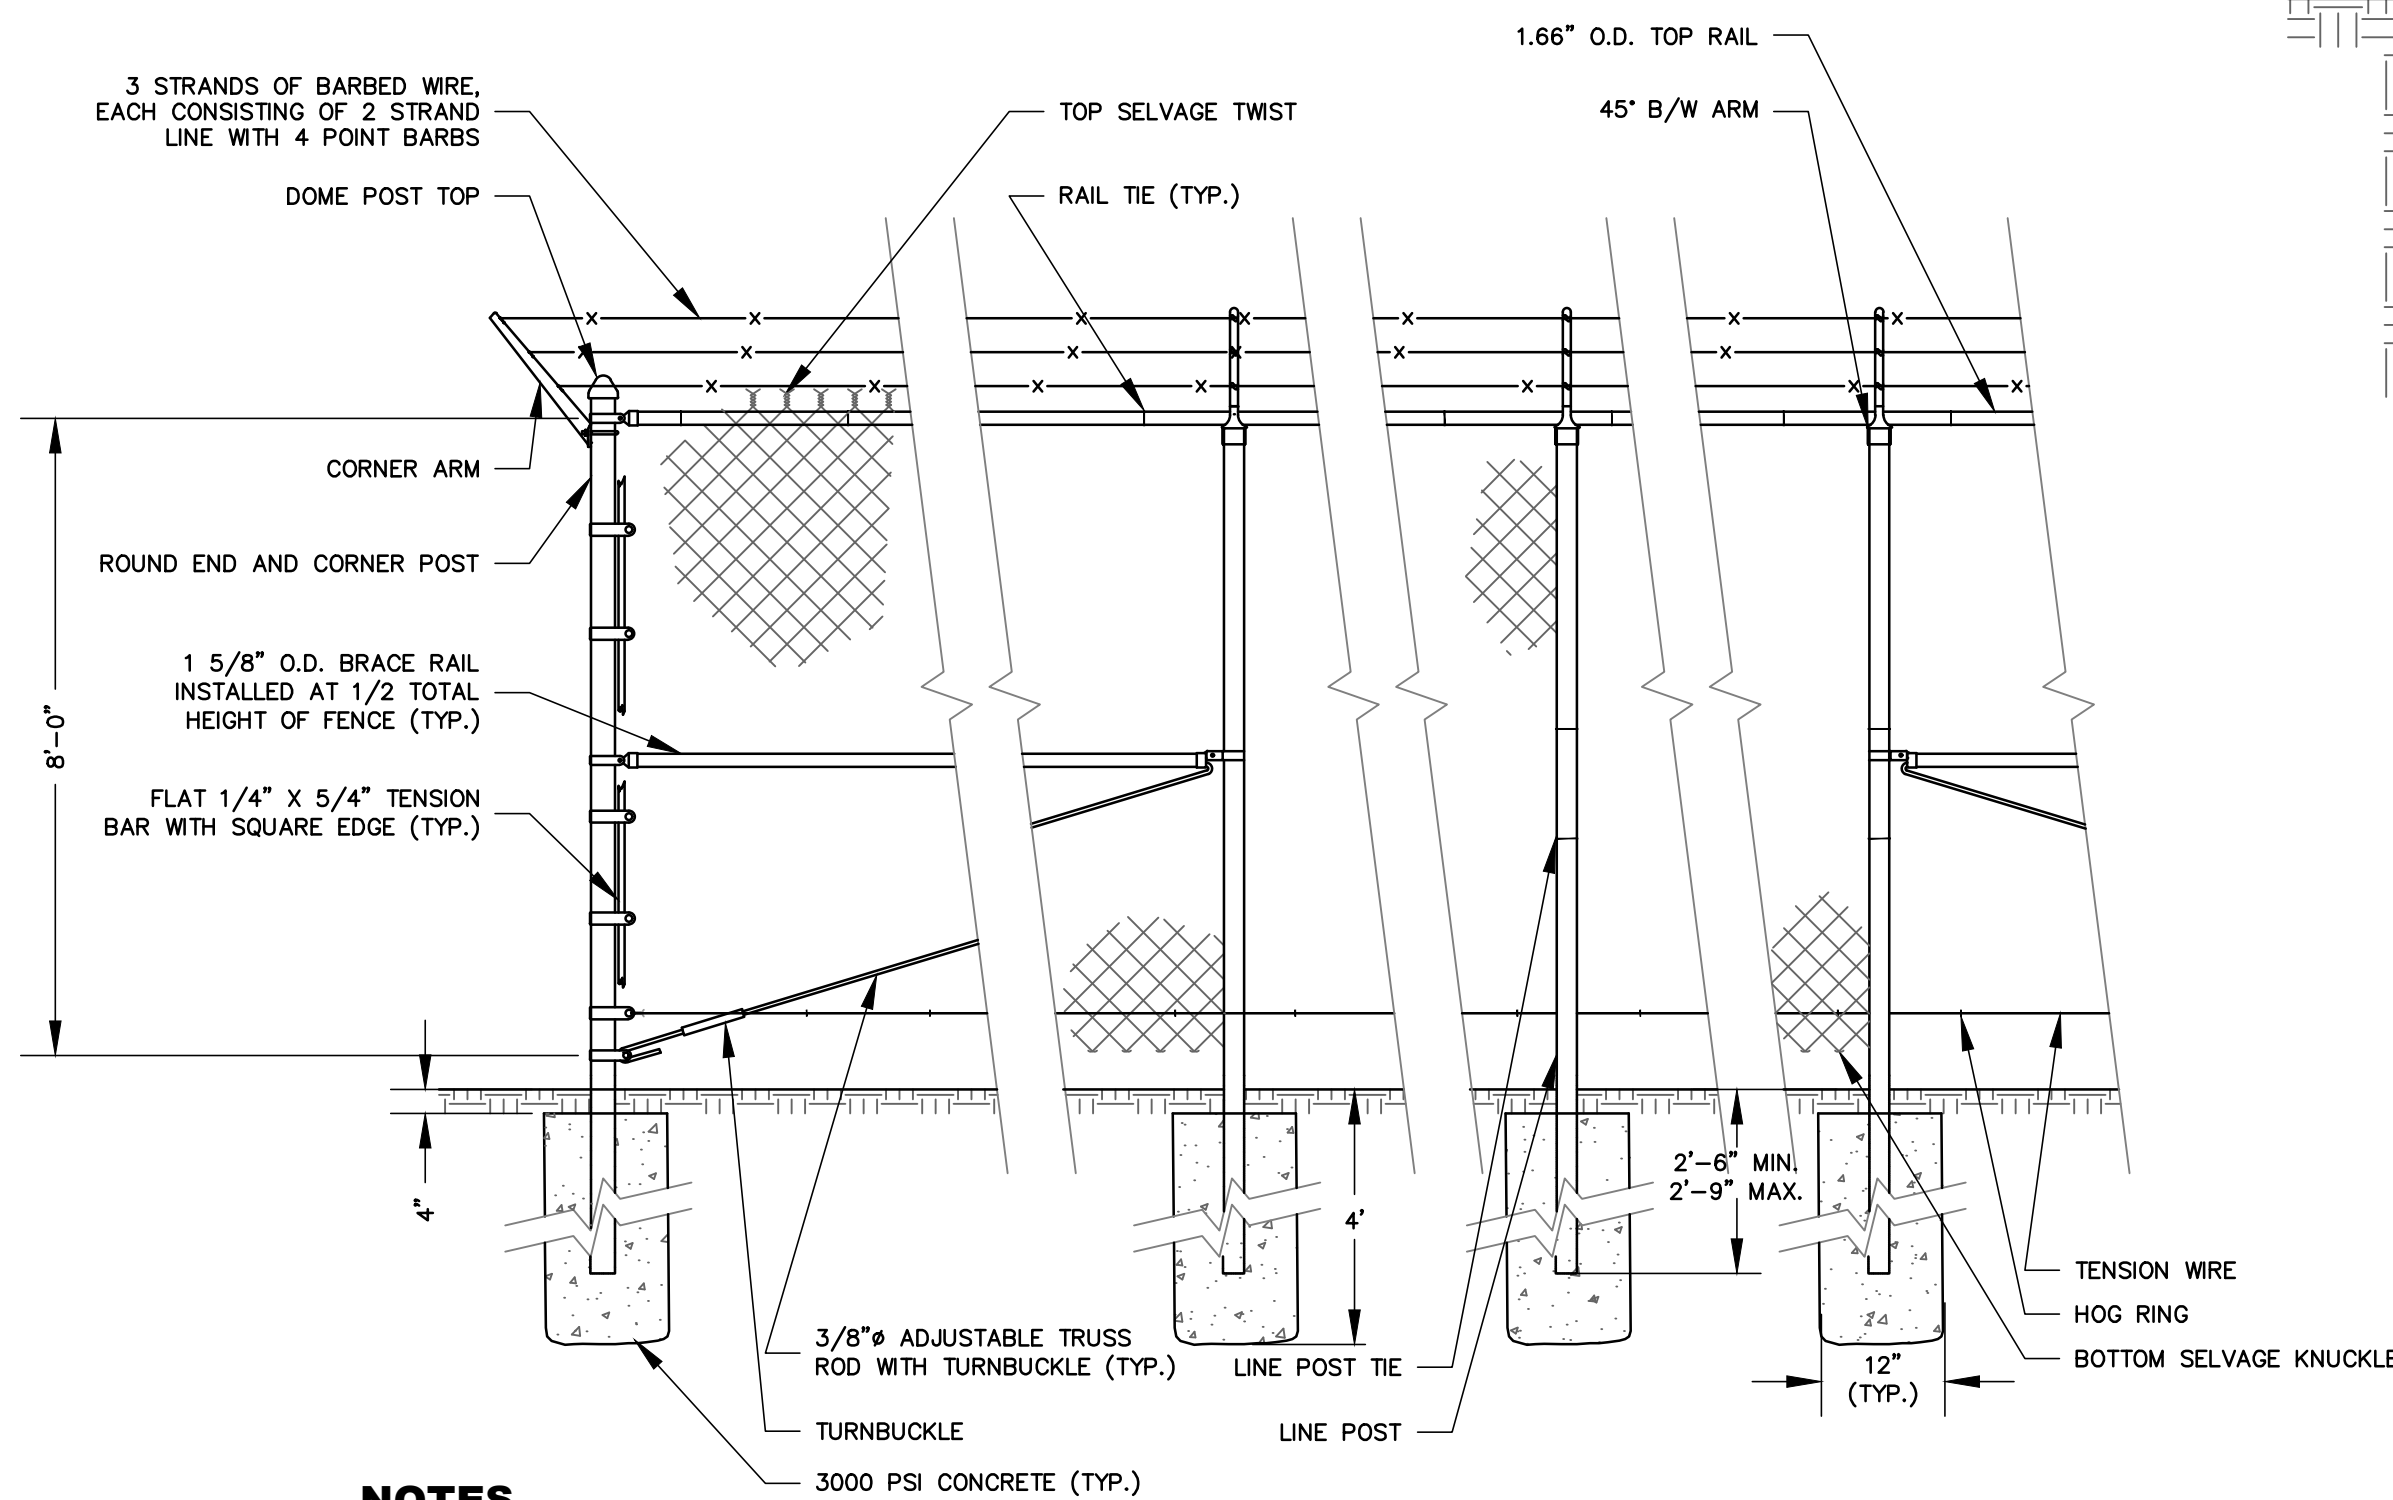

NOTES:

1. HEIGHT OF FENCE SHALL BE 8'-0".
2. FABRIC SHALL BE CHAIN LINK, #9 WIRE WOVEN IN A 2" MESH ZINC COATED STEEL OR ALUMINUM COATED STEEL. TOP TO HAVE 3 STRANDS OF OUTWARD FACING BARBED WIRE. THE BOTTOM OF FENCE IS TO BE 2" ABOVE THE GROUND LINE.
3. LINE POSTS TO BE 2 3/8" O.D. PIPE WEIGHING 3.65 POUNDS PER LINEAR FOOT. POSTS SHALL BE SPACED EQUIDISTANT WITH A MAXIMUM SPACING OF 10'-0" CENTER TO CENTER.
4. CORNER POSTS TO BE 3" O.D.
5. ALL POSTS TO HAVE DOME CAPS.
6. FABRIC TO BE FASTENED TO POSTS AND GATE FRAMES WITH #9 GAUGE WIRE.
7. TENSION WIRE SHALL BE #9 GAUGE WIRE ATTACHED 1" BELOW TOP SELVAGE AND 2" ABOVE THE BOTTOM SELVAGE BY MEANS OF HOG RINGS ON 24" CENTERS.
8. AN END SECTION ASSEMBLY IS TO BE ERCTED ON A MAXIMUM OF 200' CENTER TO CENTER.

CHAIN LINK FENCE DETAIL

NOT TO SCALE

RECORD DRAWING

Record drawings have been prepared on the basis of information furnished by others. The engineer is not responsible for errors or omissions which have been incorporated into this document as a result. The location of items shown without labeled dimensions shall be considered as approximate. Profiles show general layout. Due to changes during construction, alignment, station and elevation information may not be correct. The site was not re-surveyed after construction, so "as-built" locations, elevations and finish grades are approximate and shall be considered "schematic". Details and cross sections may not reflect "as built" conditions.
Prepared by: Otter Creek Engineering, Inc., East Middlebury, Vermont.




OTTER CREEK
ENGINEERING

404 East Main Street
P.O. Box 712
East Middlebury, VT 05740
Telephone: 802.382-8522
Fax: 802.382-8640

110 Merchants Row
4th Floor, Suite 15
Rutland, VT 05701
Telephone: 802.747-3080
Fax: 802.747-4820
E-mail: info@ottercreek.com

STAMP AND SIGNATURE:

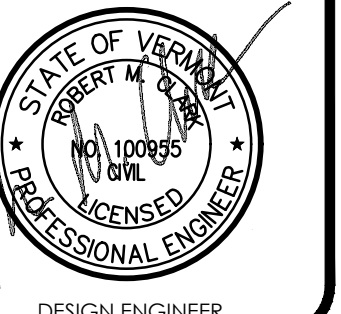

DESIGN ENGINEER

THESE DRAWINGS SHALL NOT
BE ALTERED IN ANY WAY
WITHOUT THE WRITTEN
APPROVAL OF THE ENGINEER.
ANY REVISIONS SHALL BE
MADE BY THE ENGINEER AND
NOTED IN THE REVISION
BLOCK. © 2021

OTTER CREEK ENGINEERING, INC.

TOWN OF BERLIN
PAINÉ TURNPIKE NORTH
WASTEWATER
IMPROVEMENTS
BERLIN, VERMONT

RECORD

DATE ISSUED: 6/30/2021

REVISIONS:

DRAWN BY: RR

CHECKED BY: JK

SCALE: AS SHOWN

PROJECT NO.: 519.005

CADD FILE: 519-005 DETAILS

TITLE:

DETAILS
AND NOTES

DRAWING NO.

C-14

SAFETY NOTES

1. CONTRACTOR SHALL BE RESPONSIBLE FOR INITIATING, MAINTAINING AND SUPERVISING ALL WORK SAFETY PRECAUTIONS AND PROGRAMS IN CONNECTION WITH THE WORK. CONTRACTOR SHALL TAKE ALL NECESSARY PRECAUTIONS TO PREVENT DAMAGE, INJURY OR LOSS TO:

- A. ALL EMPLOYEES ON THE WORK SITE AND OTHER PERSONS WHO MAY BE AFFECTED.
- B. THE WORK SITE AND ALL THE MATERIALS AND EQUIPMENT TO BE INCORPORATED WHETHER IN STORAGE ON OR OFF THE SITE.
- C. OTHER PROPERTY AT THE SITE OR ADJACENT, INCLUDING BUT NOT LIMITED TO TREES, SHRUBS, LAWNS, WALKS, PAVEMENTS, ROADWAYS, STRUCTURES AND UTILITIES NOT DESIGNATED FOR REMOVAL, RELOCATION, OR REPLACEMENT IN THE COURSE OF CONSTRUCTION.

2. CONTRACTOR SHALL COMPLY WITH ALL APPLICABLE LAWS, ORDINANCES, RULES, REGULATIONS AND ORDERS (INCLUDING O.S.H.A. REGULATIONS) OF ANY PUBLIC BODY HAVING JURISDICTION OVER THE SAFETY OF PERSONS OR PROPERTY.



3. THE CONTRACTOR SHALL NOTIFY OWNERS OF ADJACENT PROPERTY AND UTILITIES WHEN EXECUTION OF THE WORK WILL AFFECT THEM.

4. THE CONTRACTOR'S DUTIES AND RESPONSIBILITIES FOR THE SAFETY AND PROTECTION OF THE WORK SHALL CONTINUE UNTIL SUCH TIME AS ALL THE WORK IS COMPLETED.

5. THE LOCATION OF EXISTING UNDERGROUND UTILITIES ARE SHOWN IN AN APPROXIMATE WAY ONLY AND HAVE NOT BEEN INDEPENDENTLY VERIFIED BY THE OWNER OR ITS REPRESENTATIVE. THE CONTRACTOR SHALL DETERMINE THE EXACT LOCATION OF ALL EXISTING UTILITIES BEFORE COMMENCING WORK, AND AGREES TO BE FULLY RESPONSIBLE FOR ANY AND ALL DAMAGES WHICH OCCUR BY THE CONTRACTOR'S FAILURE TO EXACTLY LOCATE AND PRESERVE ANY AND ALL UNDERGROUND UTILITIES. IF PIPELINE DAMAGES OCCUR WHICH RESULTS IN A GAS RELEASE, CONTRACTOR IS REQUIRED BY LAW TO CALL 911.

6. CONTRACTOR SHALL COORDINATE WITH DIG-SAFE (888)-344-7233 OR WWW.DIGSAFE.COM A MINIMUM OF 48 HOURS PRIOR TO PERFORMING ANY EXCAVATION.

7. AT THE CLOSE OF EACH WORK DAY, THE CONTRACTOR SHALL BACKFILL OR ADEQUATELY BARRICADE ALL OPEN TRENCHES.

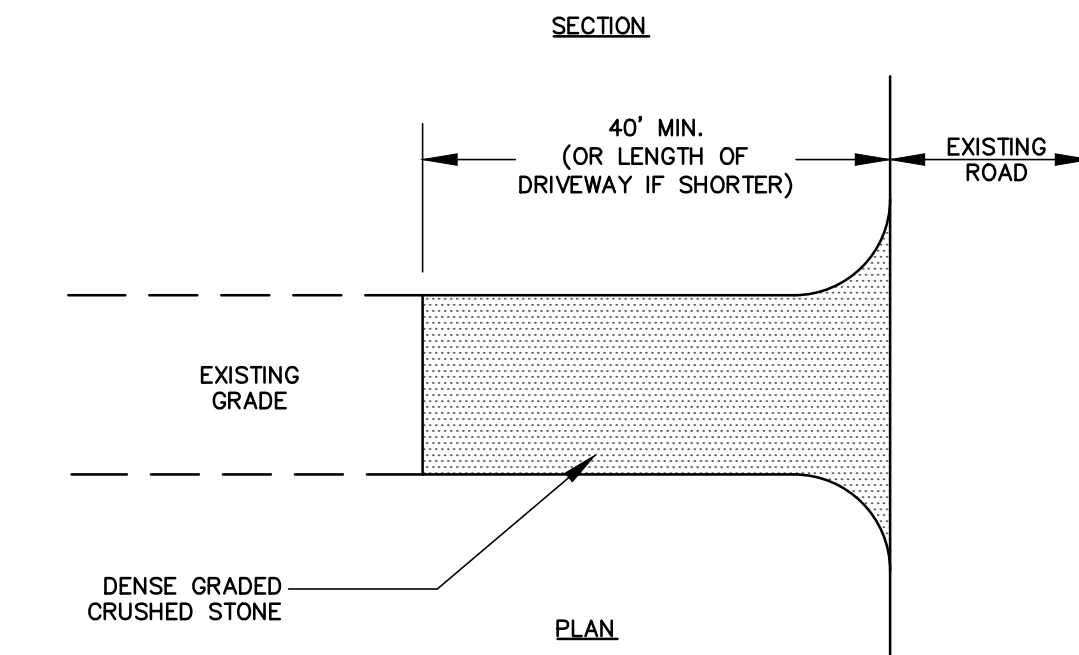
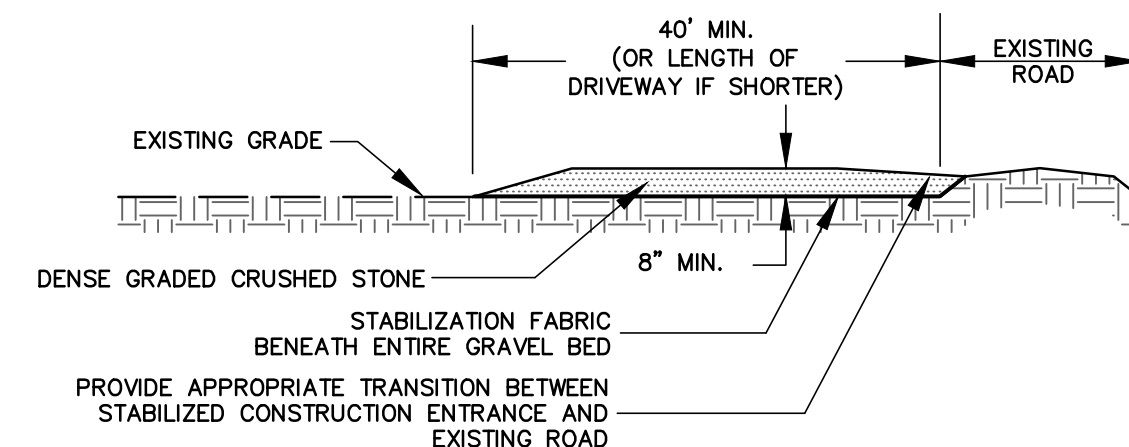


NOTES:

1. WIDTH SHALL BE 12 FEET MINIMUM.
2. VEHICLE WASHING: WHEN NECESSARY, WHEELS AND TIRES SHALL BE CLEANED TO REMOVE SEDIMENT PRIOR TO ENTRANCE ONTO PUBLIC RIGHT-OF-WAY. WHEN WASHING IS REQUIRED, IT SHALL BE DONE ON AN AREA STABILIZED WITH CRUSHED STONE, WHICH DRAINS INTO AN APPROVED SEDIMENT TRAP OR SEDIMENT BASIN. ALL SEDIMENT SHALL BE PREVENTED FROM ENTERING ANY STORM DRAIN, DITCH, OR WATERCOURSE THROUGH USE OF SAND BAGS, GRAVEL BOARDS, OR OTHER APPROVED METHODS.
3. MAINTENANCE: THE ENTRANCE SHALL BE MAINTAINED IN A CONDITION WHICH WILL PREVENT TRACKING OR FLOWING OF SEDIMENT ONTO PUBLIC RIGHT-OF-WAY. THIS MAY REQUIRE PERIODIC TOP DRESSING WITH ADDITIONAL STONE AS CONDITIONS DEMAND AND REPAIR AND/OR CLEANOUT OF ANY MEASURES USED TO TRAP SEDIMENT. ALL SEDIMENT SPILLED, DROPPED, WASHED ONTO PUBLIC RIGHT-OF-WAYS MUST BE REMOVED IMMEDIATELY.


TEMPORARY STABILIZED CONSTRUCTION ENTRANCE

NOT TO SCALE

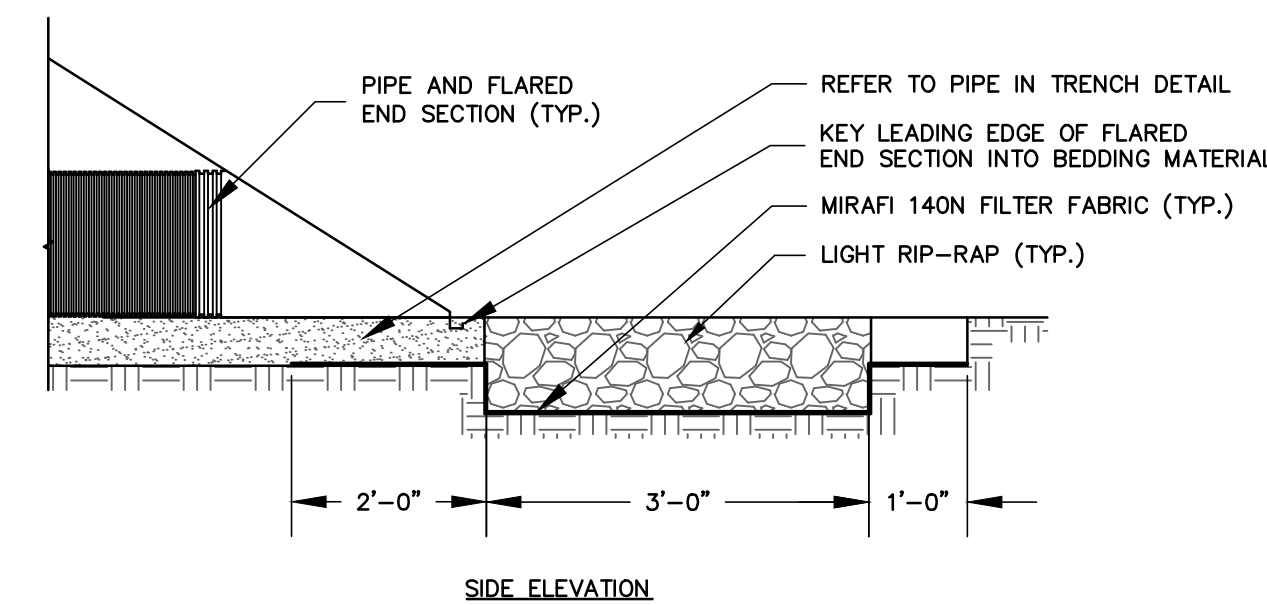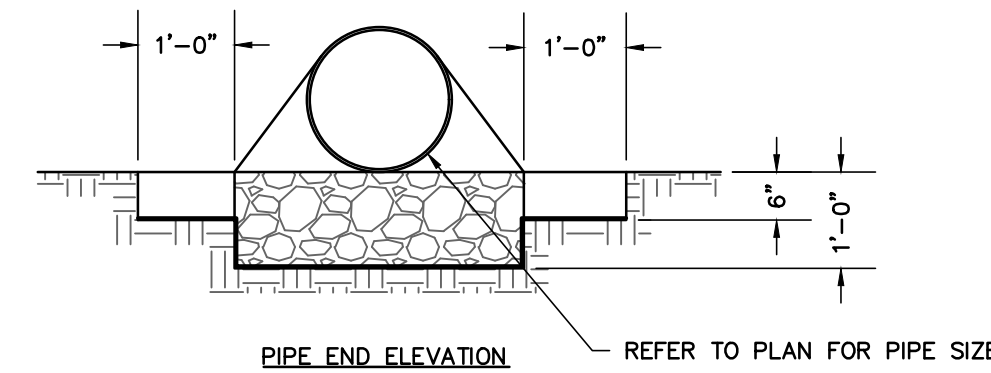


FLARED END SECTION DETAIL

NOT TO SCALE

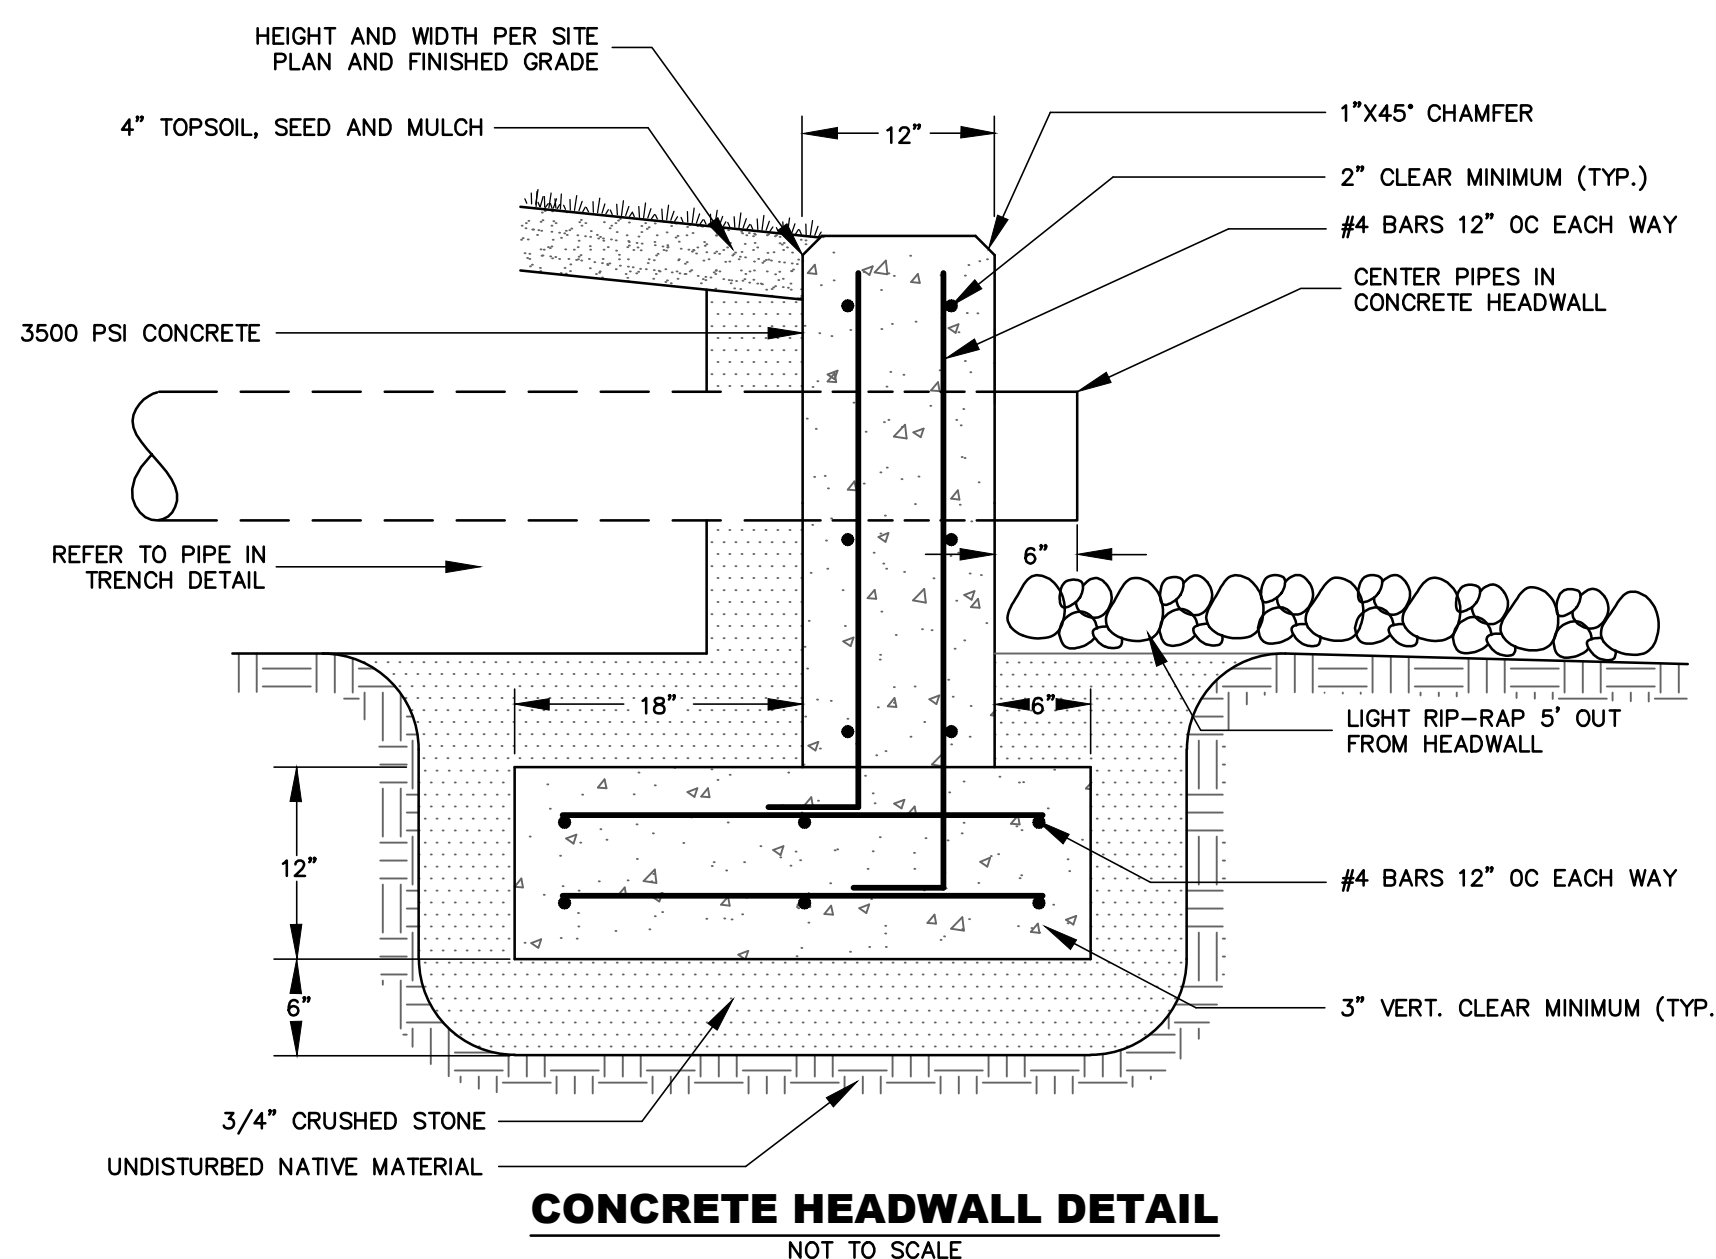

CONCRETE HEADWALL DETAIL

NOT TO SCALE

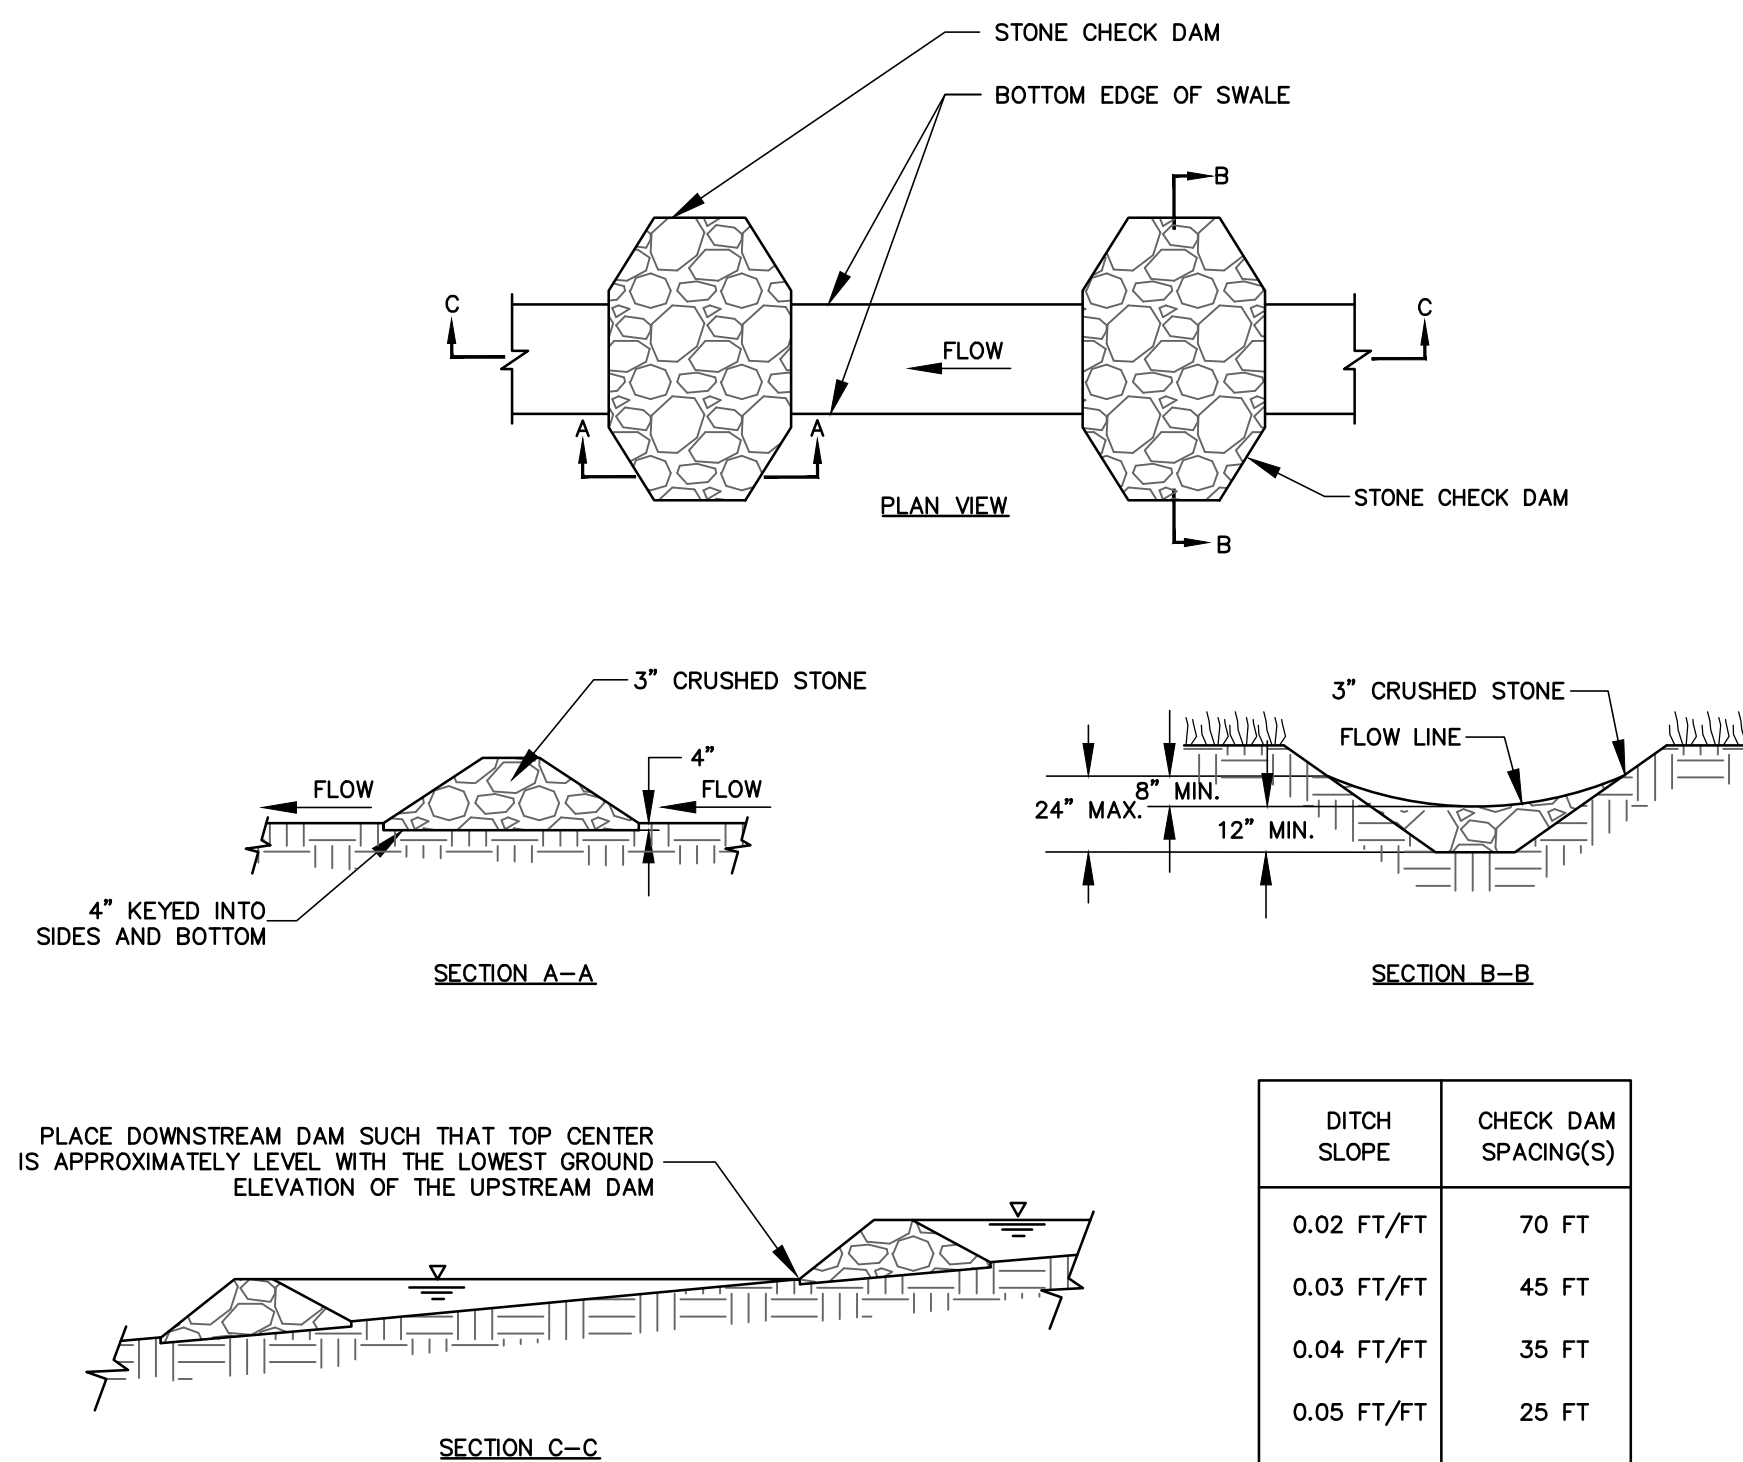

DITCH SLOPE	CHECK DAM SPACING(S)
0.02 FT/FT	70 FT
0.03 FT/FT	45 FT
0.04 FT/FT	35 FT
0.05 FT/FT	25 FT
0.06 FT/FT	20 FT

DO NOT USE CHECK DAMS BELOW 2% OR ABOVE 6% DITCH GRADES

STONE CHECK DAM DETAIL

NOT TO SCALE

EROSION CONTROL NOTES

1. THIS PROJECT IS SUBJECT TO THE STATE OF VERMONT'S CONSTRUCTION GENERAL PERMIT 3-9020, AS REQUIRED. THE CONTRACTOR SHALL APPLY FOR COVERAGE AS A CO-PERMITTEE, PRIOR TO THE START OF CONSTRUCTION.

2. THE CONTRACTOR IS RESPONSIBLE FOR EROSION PREVENTION AND SEDIMENT CONTROL FOR THIS PROJECT. ANY FINES ASSESSED BY REGULATORY AGENCIES FOR THE NONCOMPLIANCE WITH STATE WATER QUALITY STANDARDS SHALL BE THE RESPONSIBILITY OF THE CONTRACTOR. THE CONTRACTOR IS RESPONSIBLE FOR PROVIDING THE ON-SITE COORDINATOR REQUIRED BY GENERAL PERMIT 3-9020.

3. THE ON-SITE COORDINATOR SHALL HAVE THE AUTHORITY TO STOP AND/OR MODIFY CONSTRUCTION ACTIVITIES AS NECESSARY TO COMPLY WITH THE TERMS AND CONDITIONS OF THE PERMIT AND SHALL BE RESPONSIBLE FOR INSPECTIONS AND RECORD KEEPING.

4. THE EROSION PREVENTION AND SEDIMENT CONTROL MEASURES SHOWN ON THE PLANS DO NOT RELIEVE THE CONTRACTOR'S RESPONSIBILITY TO OBSERVE, EVALUATE AND CONSIDER ALTERNATIVES AND TO PROPOSE APPROPRIATE RECOMMENDATIONS IN ORDER TO LIMIT POTENTIAL WATER QUALITY IMPACTS.



5. ANY MAJOR CHANGES PROPOSED BY THE CONTRACTOR MUST BE APPROVED BY THE STATE OF VERMONT, AGENCY OF NATURAL RESOURCES, AND DEPARTMENT OF ENVIRONMENTAL CONSERVATION. THE CONTRACTOR IS RESPONSIBLE FOR ALL COST, AMENDMENT APPLICATIONS AND SUPPORTING MATERIAL NECESSARY AND SCHEDULE IMPACTS ASSOCIATED WITH THE MAJOR CHANGES.

6. EROSION PREVENTION AND SEDIMENT SHALL BE MONITORED AND MAINTAINED THROUGHOUT CONSTRUCTION AND REMOVED AFTER PROJECT AREA AND DRAINAGE COURSES ARE FULLY ESTABLISHED AND STABLE.

7. ALL DISTURBED AREAS NOT UNDER ACTIVE CONSTRUCTION SHALL BE STABILIZED BY ROUGH GRADING TO MINIMIZE SLOPES AND MULCHED. FOLLOWING FINAL GRADING OF ANY PORTION OF THE SITE, CONTRACTOR SHALL LOAM, SEED AND MULCH WITHIN ONE WEEK.

8. REFER TO CONTRACT SPECIFICATIONS, DETAILS AND GENERAL PERMIT FOR ADDITIONAL INFORMATION.

9. THE CONTRACTOR SHALL INSTALL INLET PROTECTION ON ALL CATCH BASINS WITHIN 100 FEET DOWN GRADIENT OF THE ACTIVELY WORKED CONSTRUCTION AREA. INLET PROTECTION BEST MANAGEMENT PRACTICES SHALL BE INSTALLED PRIOR TO THE START OF WORK AND IN ACCORDANCE WITH MANUFACTURER'S RECOMMENDATIONS.

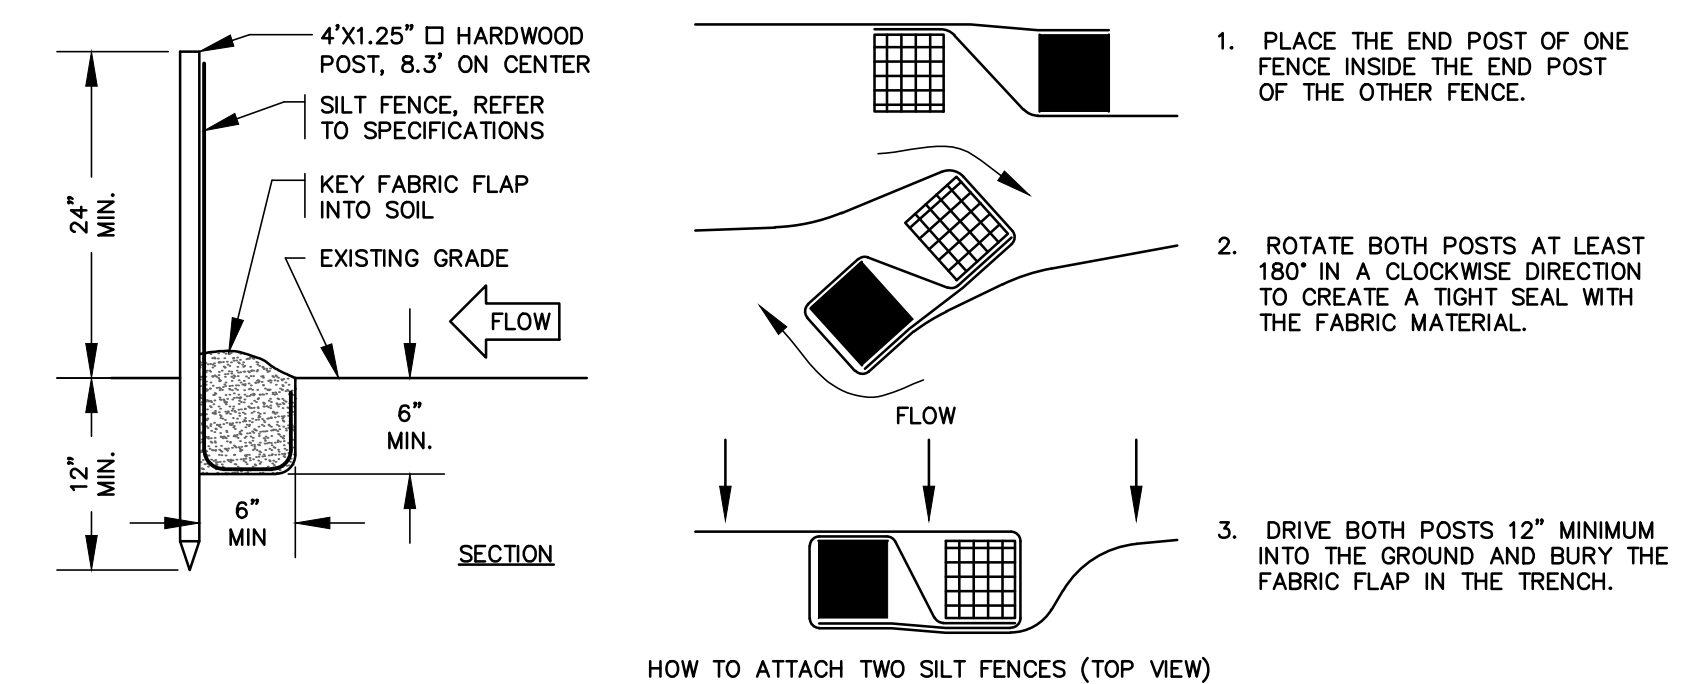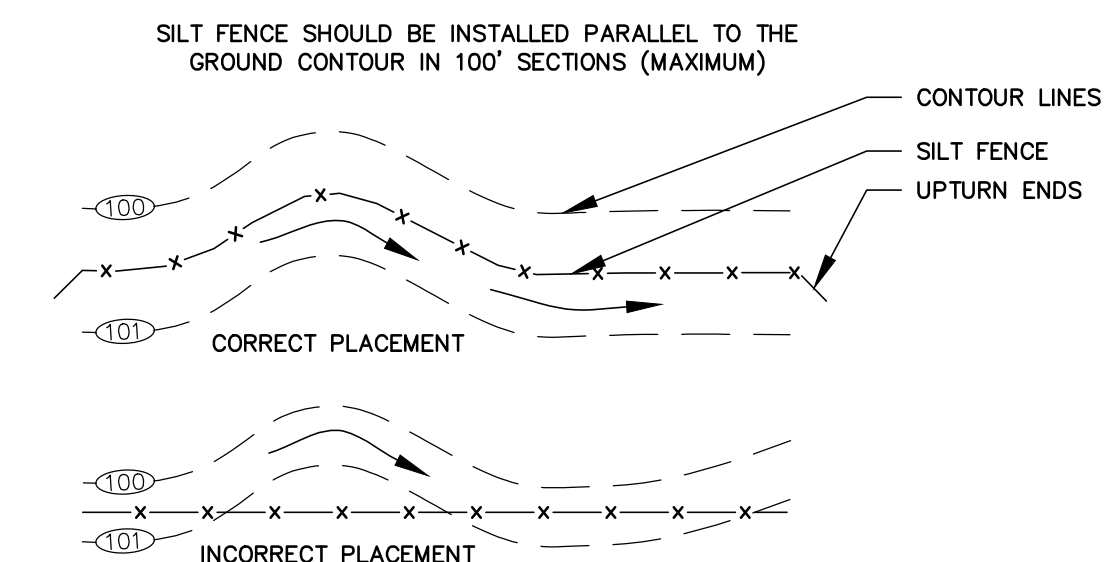

1. PLACE THE END POST OF ONE FENCE INSIDE THE END POST OF THE OTHER FENCE.
2. ROTATE BOTH POSTS AT LEAST 180° IN A CLOCKWISE DIRECTION TO CREATE A TIGHT SEAL WITH THE FABRIC MATERIAL.
3. DRIVE BOTH POSTS 12" MINIMUM INTO THE GROUND AND BURY THE FABRIC FLAP IN THE TRENCH.

NOTES:

1. SILT FENCE SHALL BE INSTALLED AT THE DOWNHILL SIDE OF CONSTRUCTION ACTIVITIES BEFORE UPSLOPE LAND DISTURBANCE BEGINS.
2. REFER TO TECHNICAL SPECIFICATIONS FOR ADDITIONAL INFORMATION.

SILT FENCE DETAIL

NOT TO SCALE

RECORD DRAWING

Record drawings have been prepared on the basis of information furnished by others. The engineer is not responsible for errors or omissions which have been incorporated into this document as a result. The location of items shown without labeled dimensions shall be considered as approximate. Profiles show general layout. Due to changes during construction, alignment, station and elevation information may not be correct. The site was not re-surveyed after construction, so "as-built" locations, elevations and finish grades are approximate and shall be considered "schematic." Details and cross sections may not reflect "as built" conditions. Prepared by: Otter Creek Engineering, Inc., East Middlebury, Vermont.